


West 1/4 Corner
Section 22-1-16
N. 196,753.35
E. 2,377,509.26

**Outlot 97 of the Assessor's Plat
of the Village of Walworth,**

Surveyed for: **Anna Maria Hinkle**
322 Linden Lane
Delavan, Wisconsin. 53115

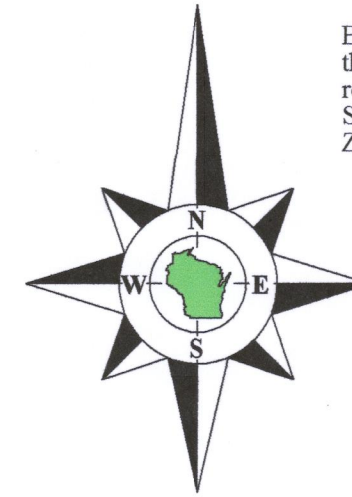

Coordinates are referenced to the Wisconsin State Plane Coordinate System, South Zone, (NAD-27).

Scale in feet
1" = 20'

A horizontal graphic scale bar with alternating black and white segments. The segments are labeled from left to right as 0', 10', 20', 40', and 60'. The 10' segment is divided into two 5' sub-segments. The 20' segment is divided into four 5' sub-segments. The 40' segment is divided into eight 5' sub-segments. The 60' segment is divided into twelve 5' sub-segments.

OLSON
LAND SURVEYING, LLC

Rural | Residential | Commercial


☒ Found County Section Corner	N North
☒ Found Iron Pipe	S South
☒ Found Cut Cross	E East
☒ Set Cut Cross	W West
☒ Set Pole	" Bearings
☒ Second Information	" Degrees
☒ Utility Box or Pedestal	" Meters
☒ Light Pole	" Seconds
☒ PVC Cap	" Distances
	" Feet
	" Inches
☒ Asphalt Surface	Concrete Surface

2018.099

Sheet 1 of 1 Sheets

Drawing Name:

Job Reference Number
2018.099

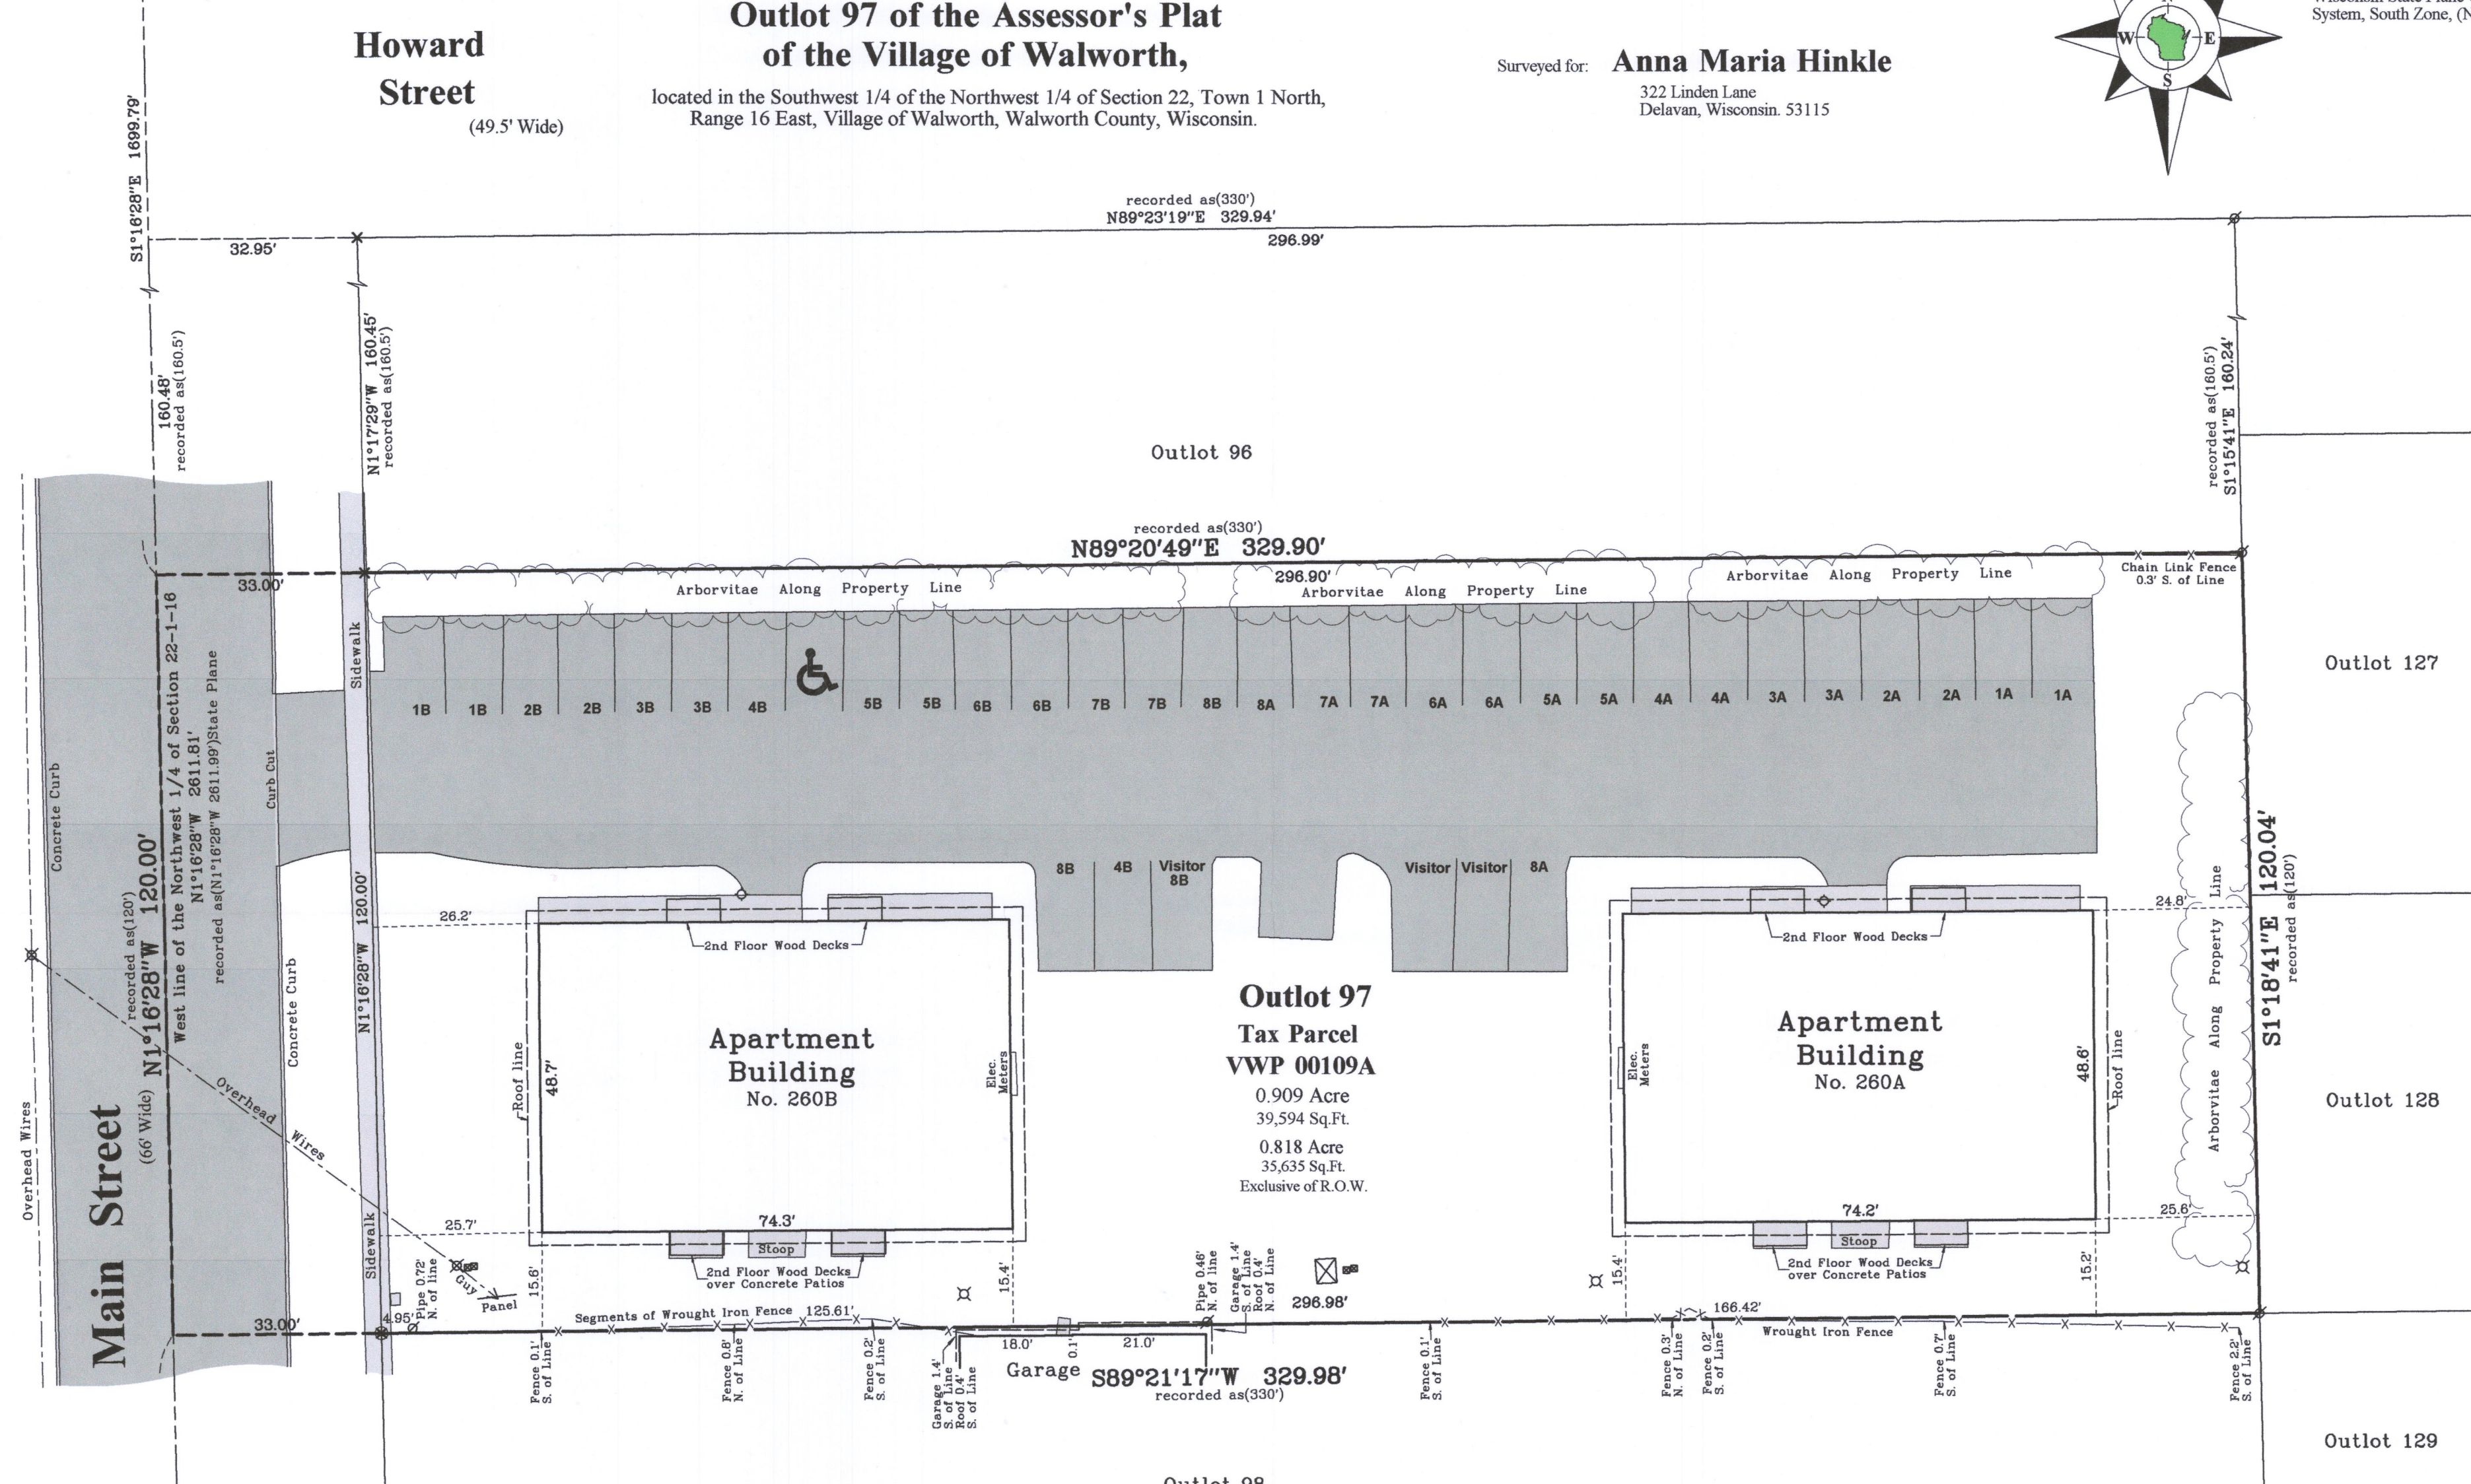

- 1) This Plat of Survey is not certified unless signed and sealed in red ink.
- 2) This survey is subject to Wisconsin lien laws. This Plat of Survey is the notice of intent to file lien. Lien waiver required.
- 3) The Survey Date shown on this Plat of Survey is the completion date of the field work.

All rights reserved. No part of this survey plat may be reproduced or transmitted in any form by any means - graphic, electronic, or mechanical, including photocopying, tracing, or information storage and retrieval systems - without permission in writing from Douglas G. Olson, Olson Land Surveying, LLC.

This survey is made for the exclusive use of the present owners of the property, and also those who purchase, mortgage or guarantee title thereto, within one year from the date hereof.

Douglas G. Olson
Wisconsin Professional Land Surveyor - 2093

VWP-109A 009-1308