#244-63.

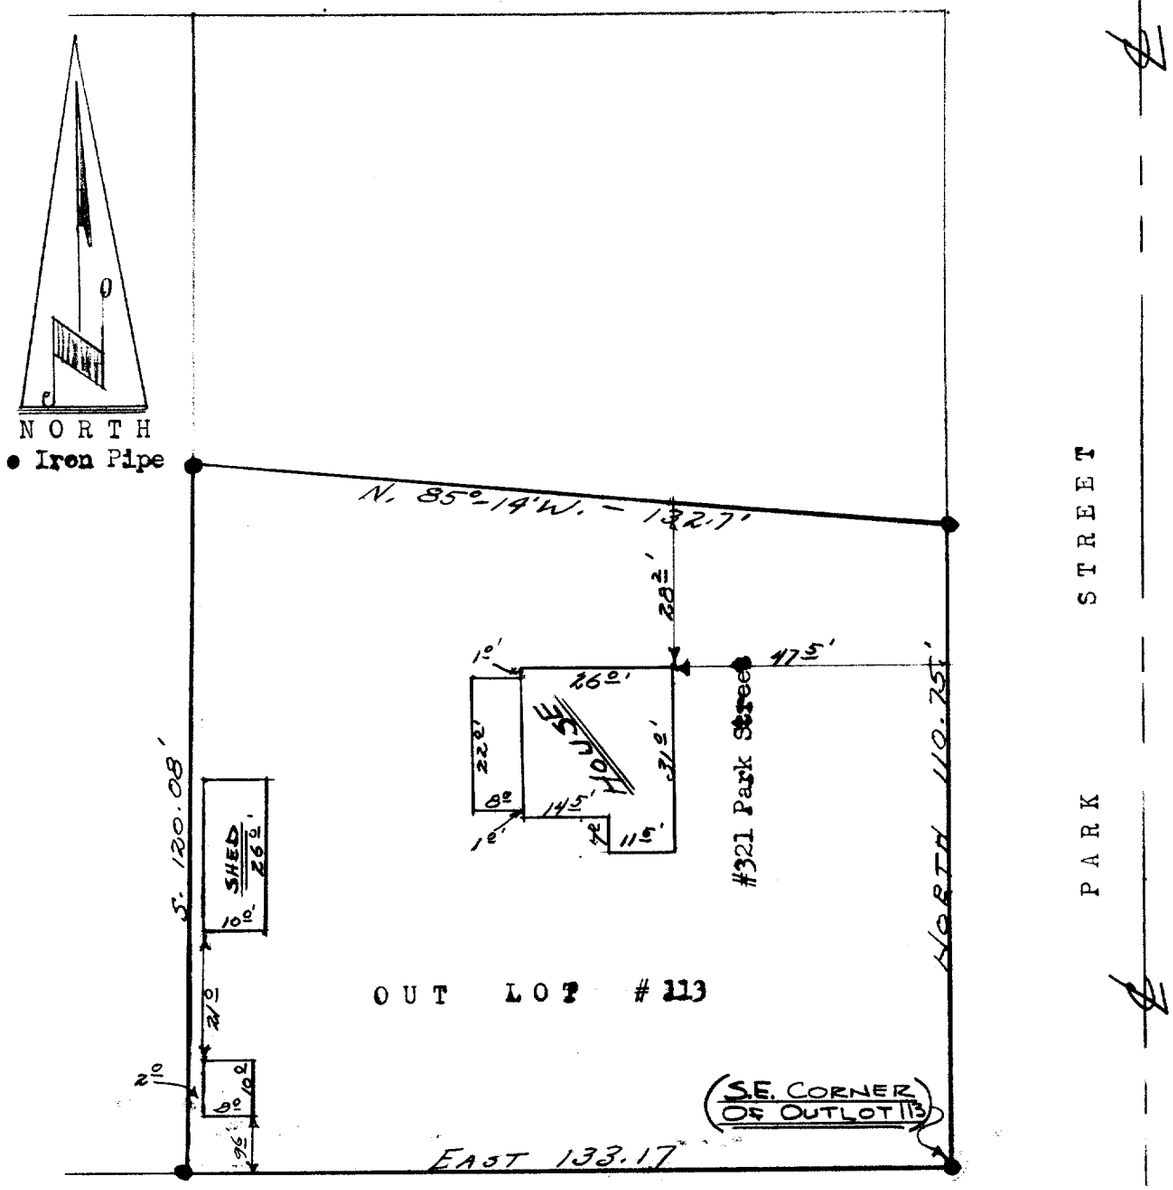


DESCRIPTION: Part of Outlots 112 and 113; Commencing at the SE Corner of Outlot 113, thence North 110.75 feet, thence N. 85° 14' W. 132.70 feet, thence South 120.08 feet, thence East 133.17 feet, to the place of beginning all in the Village of Walworth, Walworth County, Wisconsin.

CERTIFICATE: I, hereby certify that I have surveyed the above mentioned property and that the hereon portrayed is an accurate survey and a true representation thereof and correctly shows the exterior boundary lines and the location of buildings and other improvements thereof.

James F. Biagi. R.E. and L.S.
Elkhorn, Wisconsin.

JAMES F. BIAGI
MILWAUKEE, WIS.
WISCONSIN
LAND SURVEYOR

Dated: October 27th 1965.

VWP-138

9-13