


DUNHAM SURVEYING, S.C.
SURVEYING & SUBDIVIDING
DELAVER, WISCONSIN 53115

Iron Pipe located 0.8'
Northeast of fence corner.

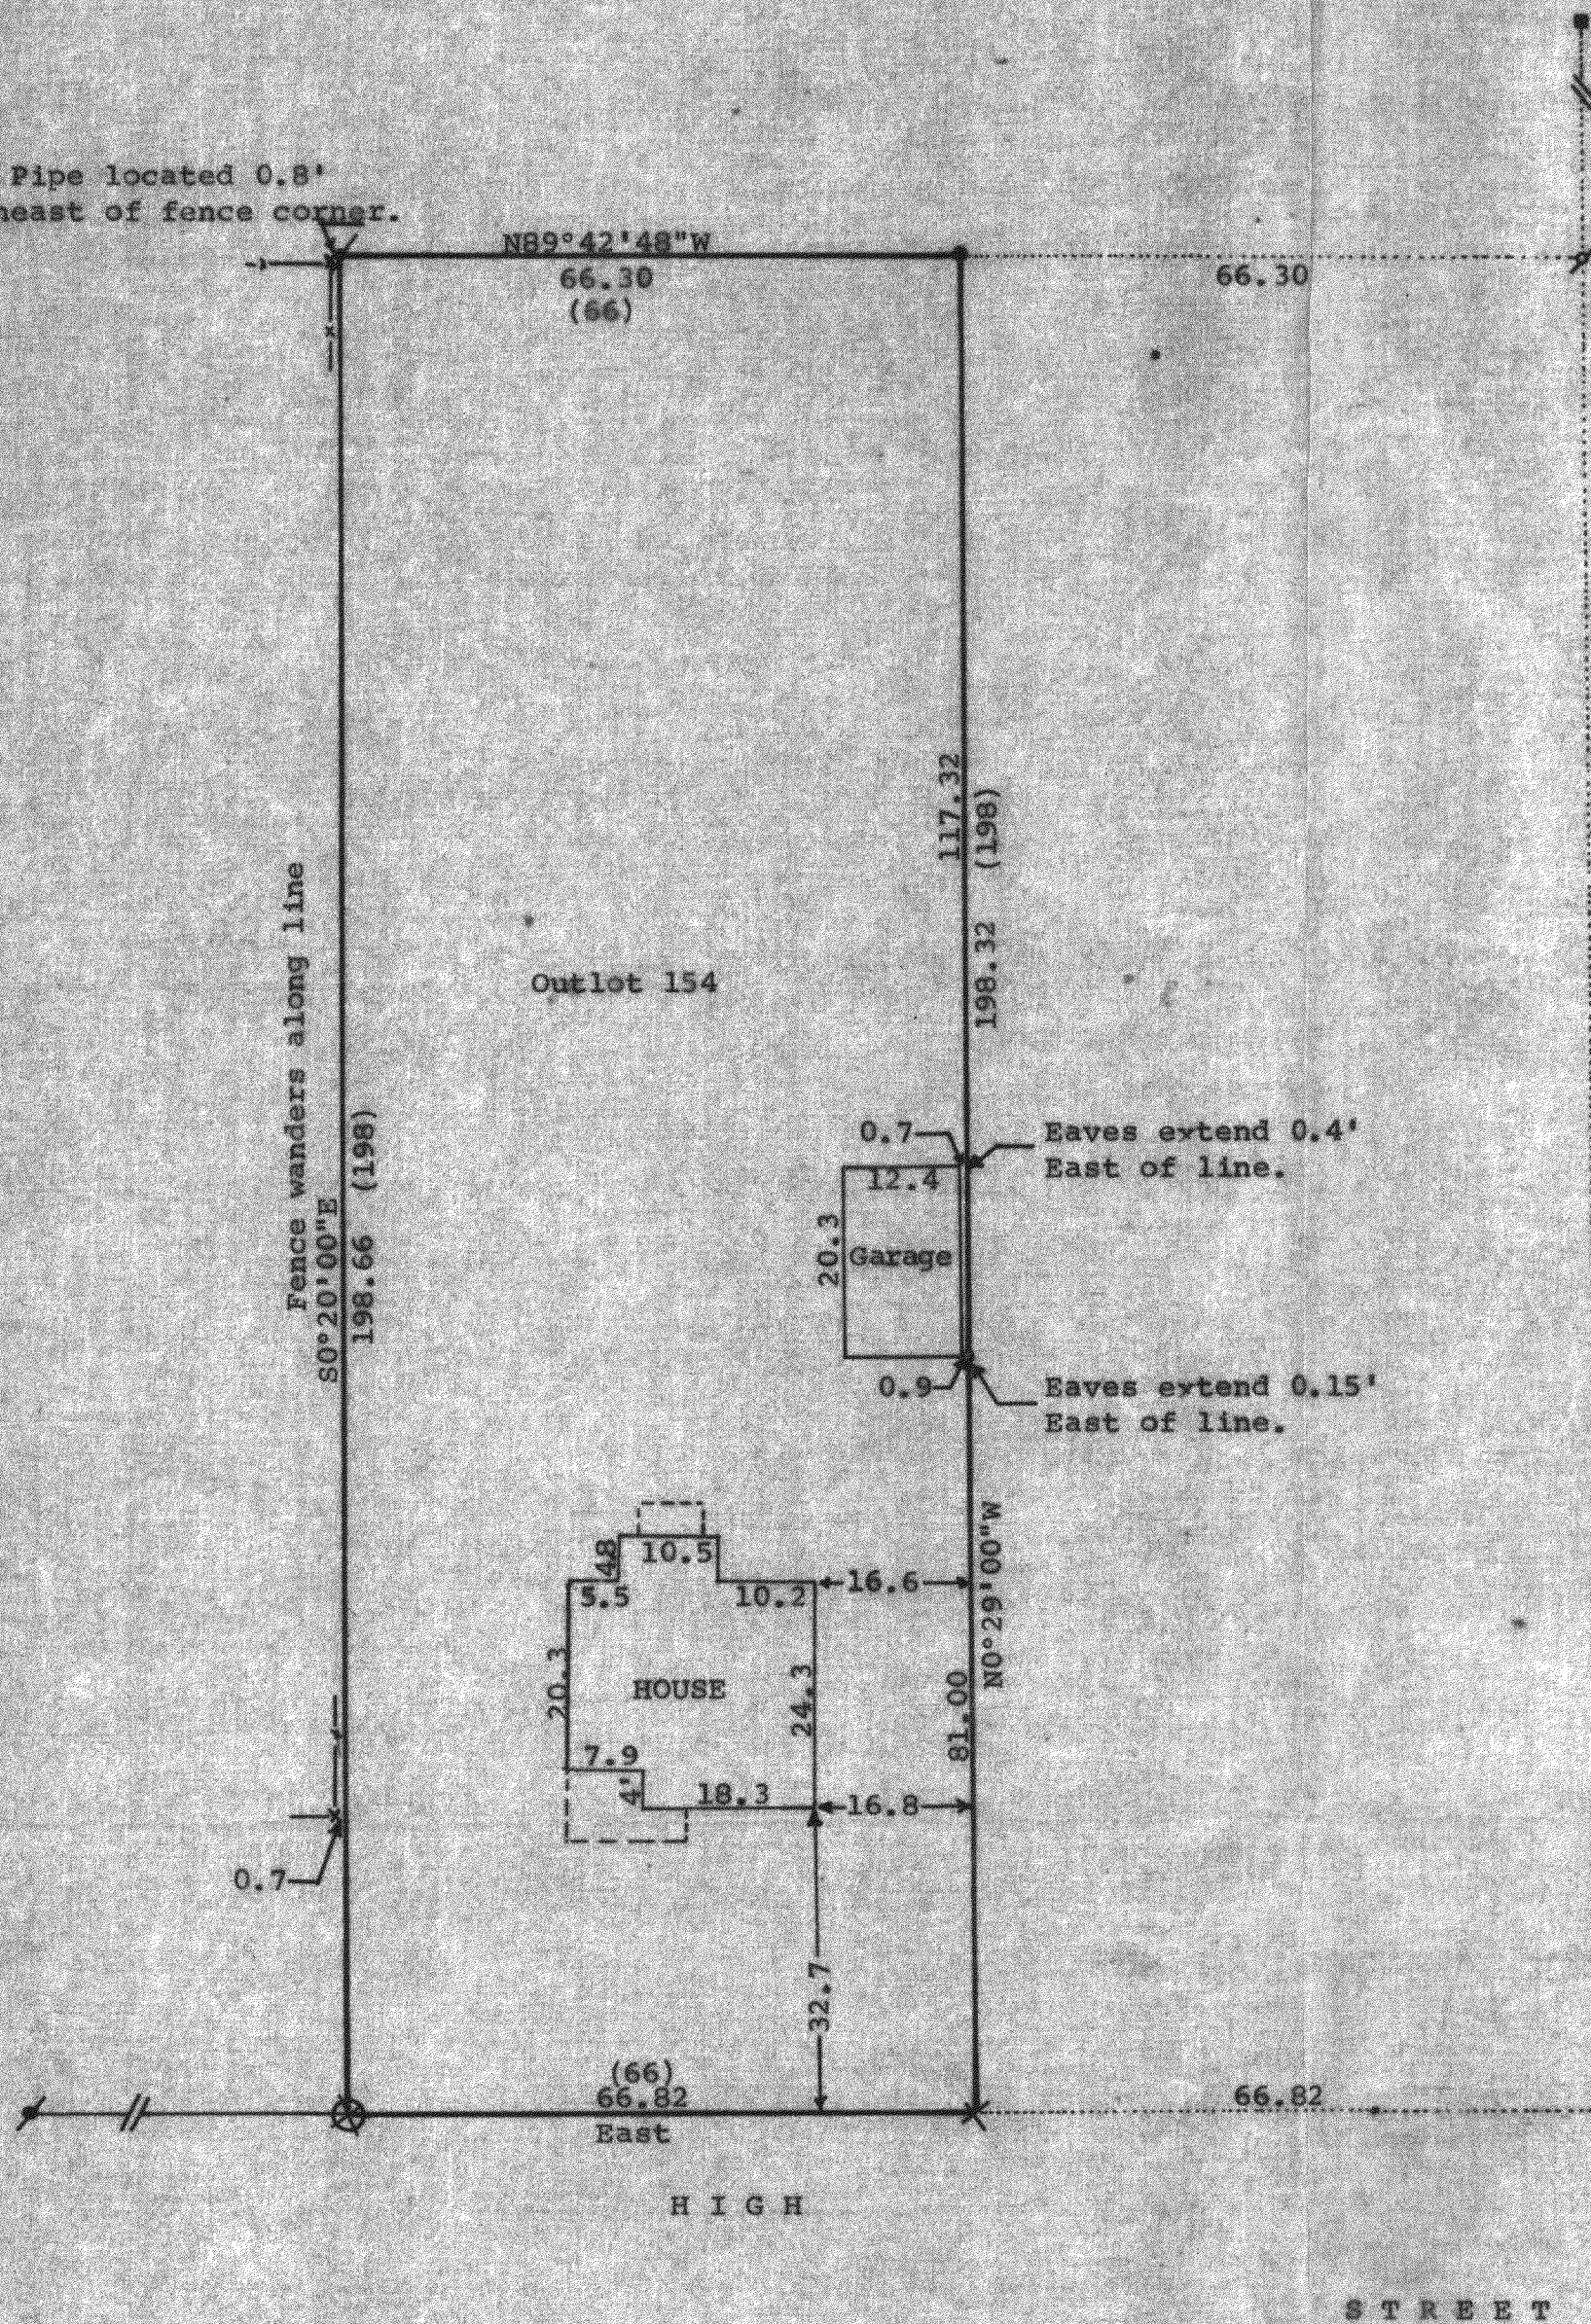

Scale - 1" = 20'
X = Cross Cut in Concrete
• = 3/4" Iron Pipe Set
o = 1/2" Iron Pipe Set
/ = 1/4" Iron Pipe Found
/ = 3/4" Iron Pipe Found
■ = 1" Iron Pipe Found
⊗ = Cross Found in Concrete
(xx) = Recorded Distance

Survey ordered by:
Churchill Realty
Walworth, Wisconsin 53184

Bearings are referenced to the
Northerly line of High St.
Assumed bearing of East used.

STATE OF WISCONSIN)
COUNTY OF WALWORTH) ss

I, George T. Dunham, Surveyor, certify that I have surveyed
the property described as follows,
Outlot 154 of the Assessor's Plat of the Village of Walworth,
Walworth County, Wisconsin,
and that the plat shown above is a true representation thereof and shows
the size and location of the property, its exterior boundaries, the
location of boundary fences, apparent easements, roadways and visible
encroachments, if any, and that I have surveyed the property hereon
described according to the official records to the best of my knowledge
and belief.
February 9, 1984

George T. Dunham
George T. Dunham, Surveyor

