


DUNHAM SURVEYING, S.C.
SURVEYING & SUBDIVIDING
DELAVER, WISCONSIN 53115

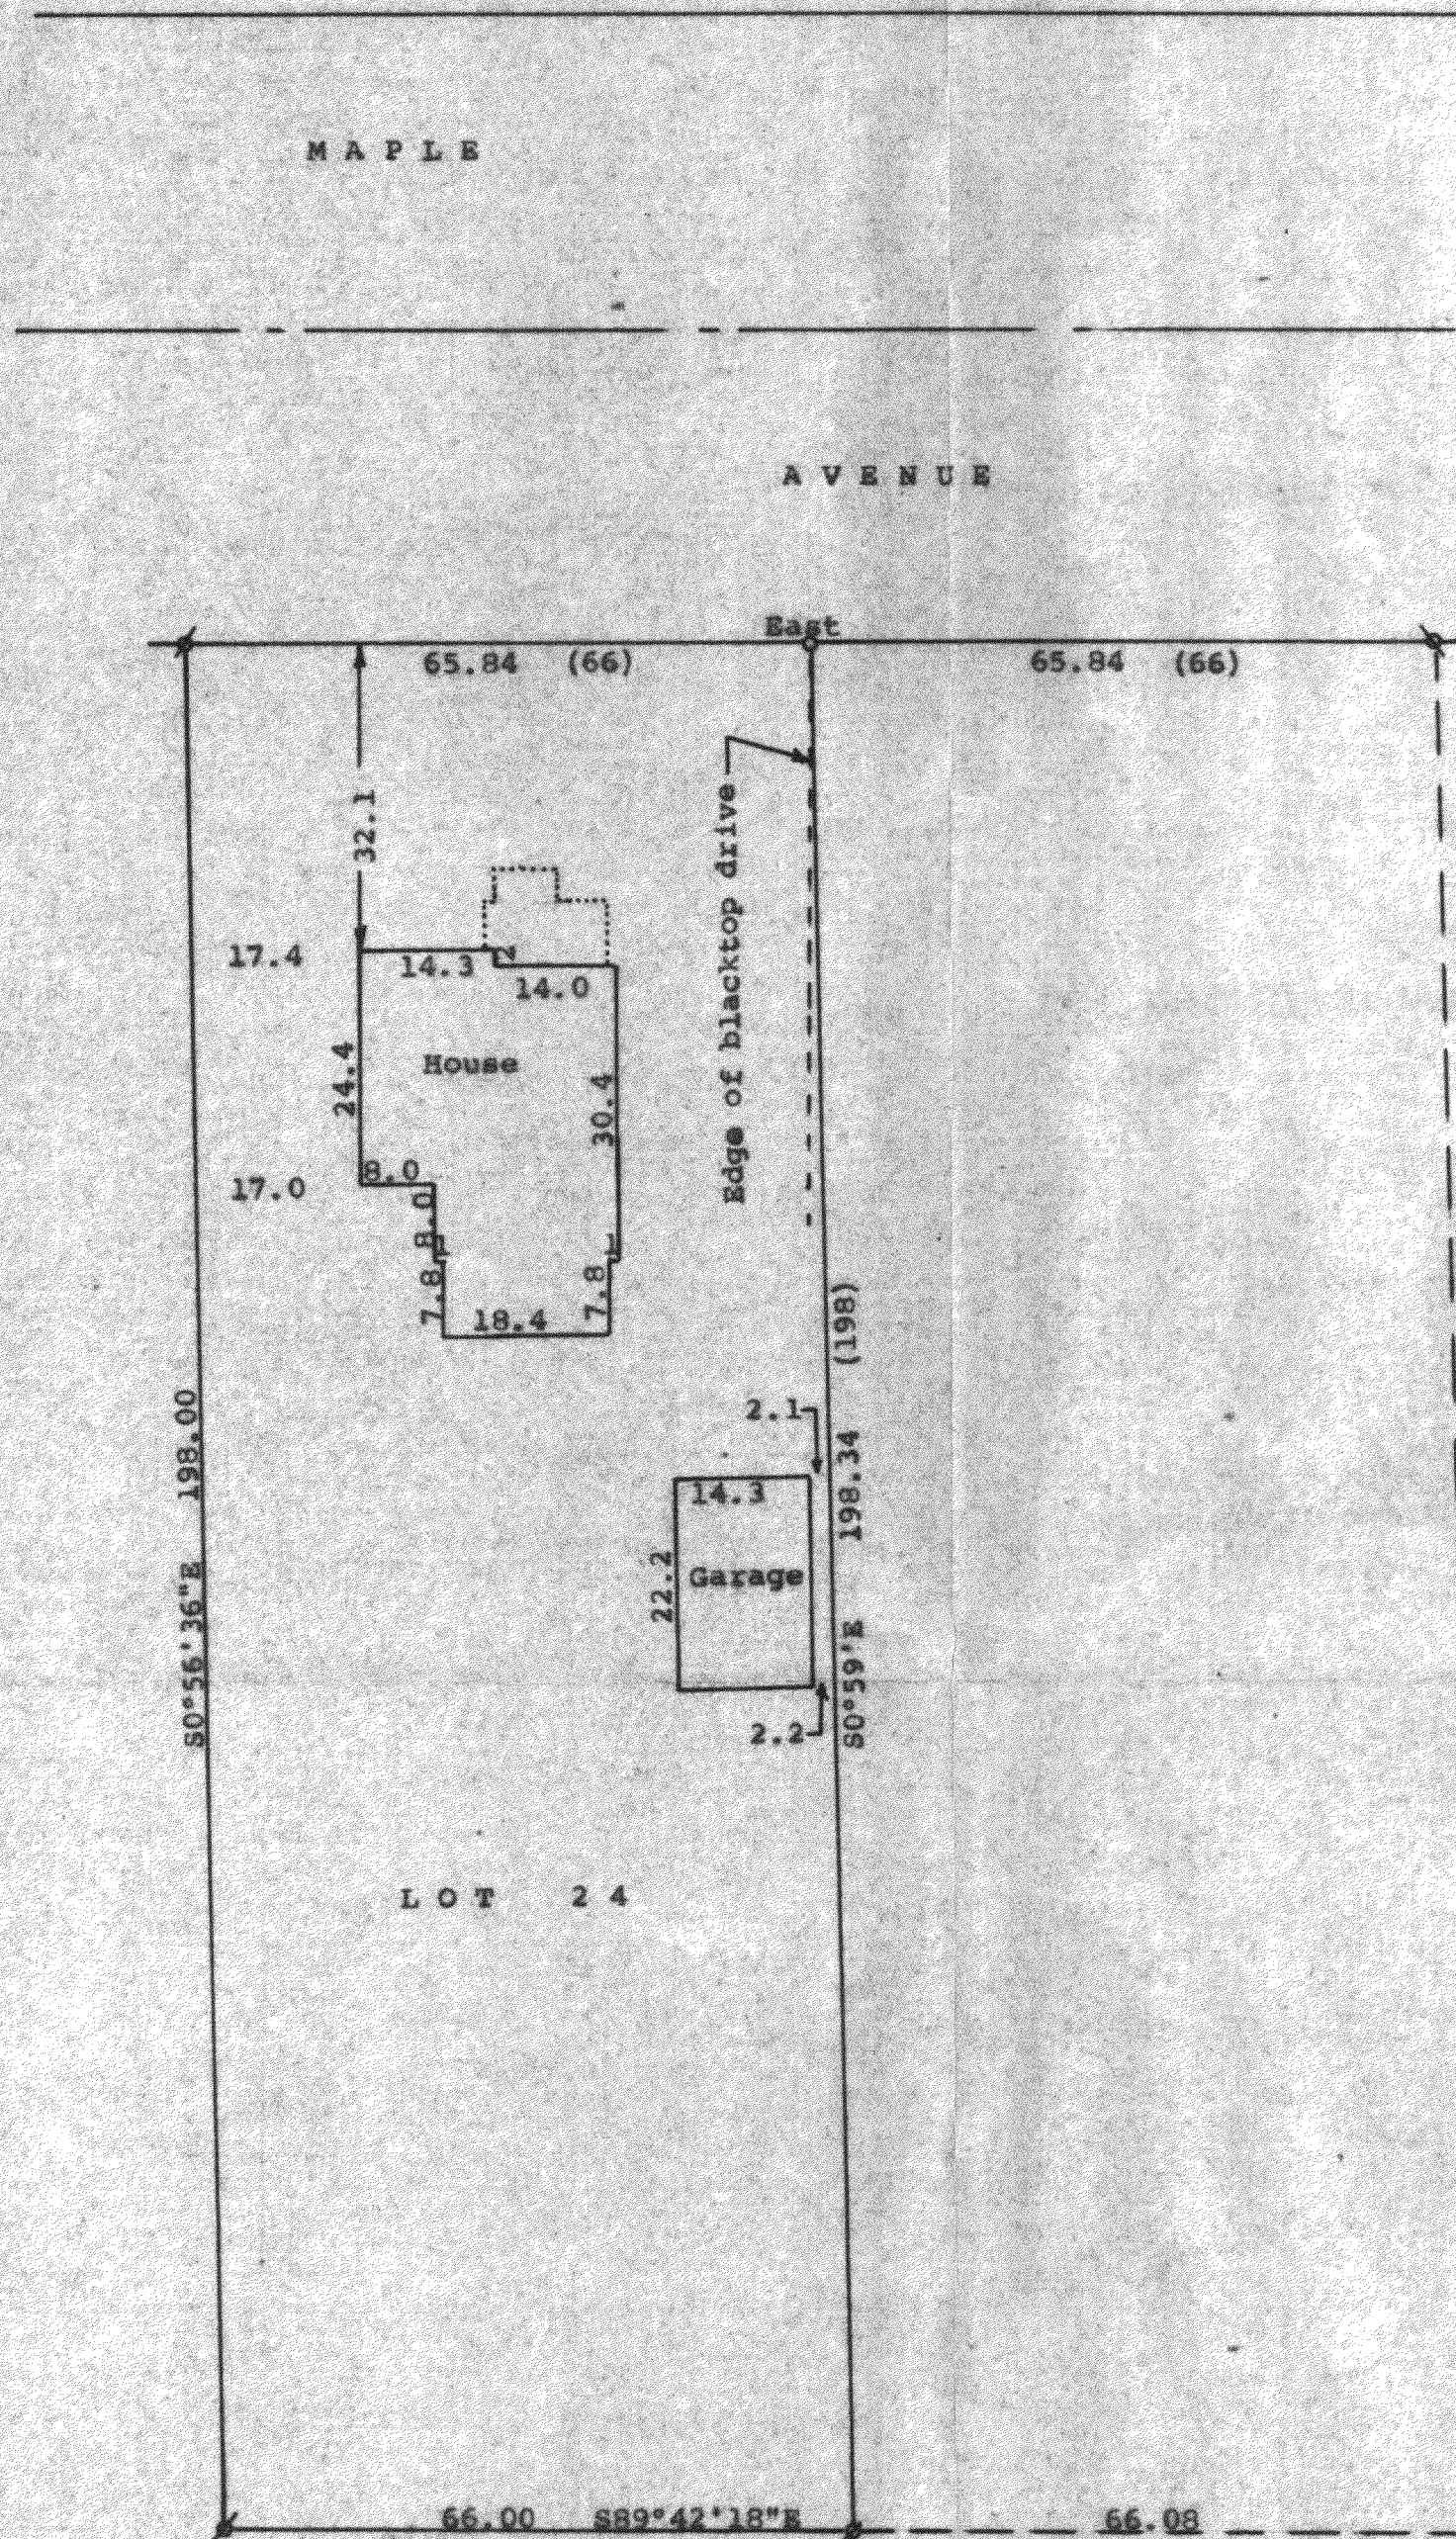

Scale - 1" = 20'
 Ø = 3/4" Iron Pipe Found
 □ = 1 1/2" Iron Pipe Found
 ○ = 3/4" X 24" Iron Pipe Set
 Bearings referenced to the assumed bearing
 of East along the south line of Maple Ave.,
 Survey ordered by: Churchill Real Estate
 322 Park
 Walworth WI 53184
 (00) = recorded distance


STATE OF WISCONSIN) SS
 COUNTY OF WALWORTH)

I, George T. Dunham, Surveyor, certify that I have surveyed the property
 described as follows:

Lot 24 of Clark's Addition to the Village of Walworth, Walworth County,
 Wisconsin.

and that the plat shown hereon is a correct representation thereof and shows
 the size and location of the property, its exterior boundaries, the location
 of all visible structures and dimensions of all principal buildings thereon,
 boundary fences, apparent easements, roadways and visible encroachments, if
 any, and that I have surveyed the property hereon described, according to the
 official records, to the best of my knowledge and belief.

November 1, 1988

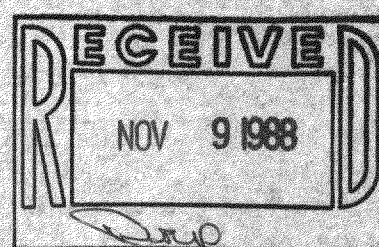

George T. Dunham
 George T. Dunham, Surveyor

