


DUNHAM SURVEYING, S.C.
SURVEYING & SUBDIVIDING
DELAVER, WISCONSIN 53115

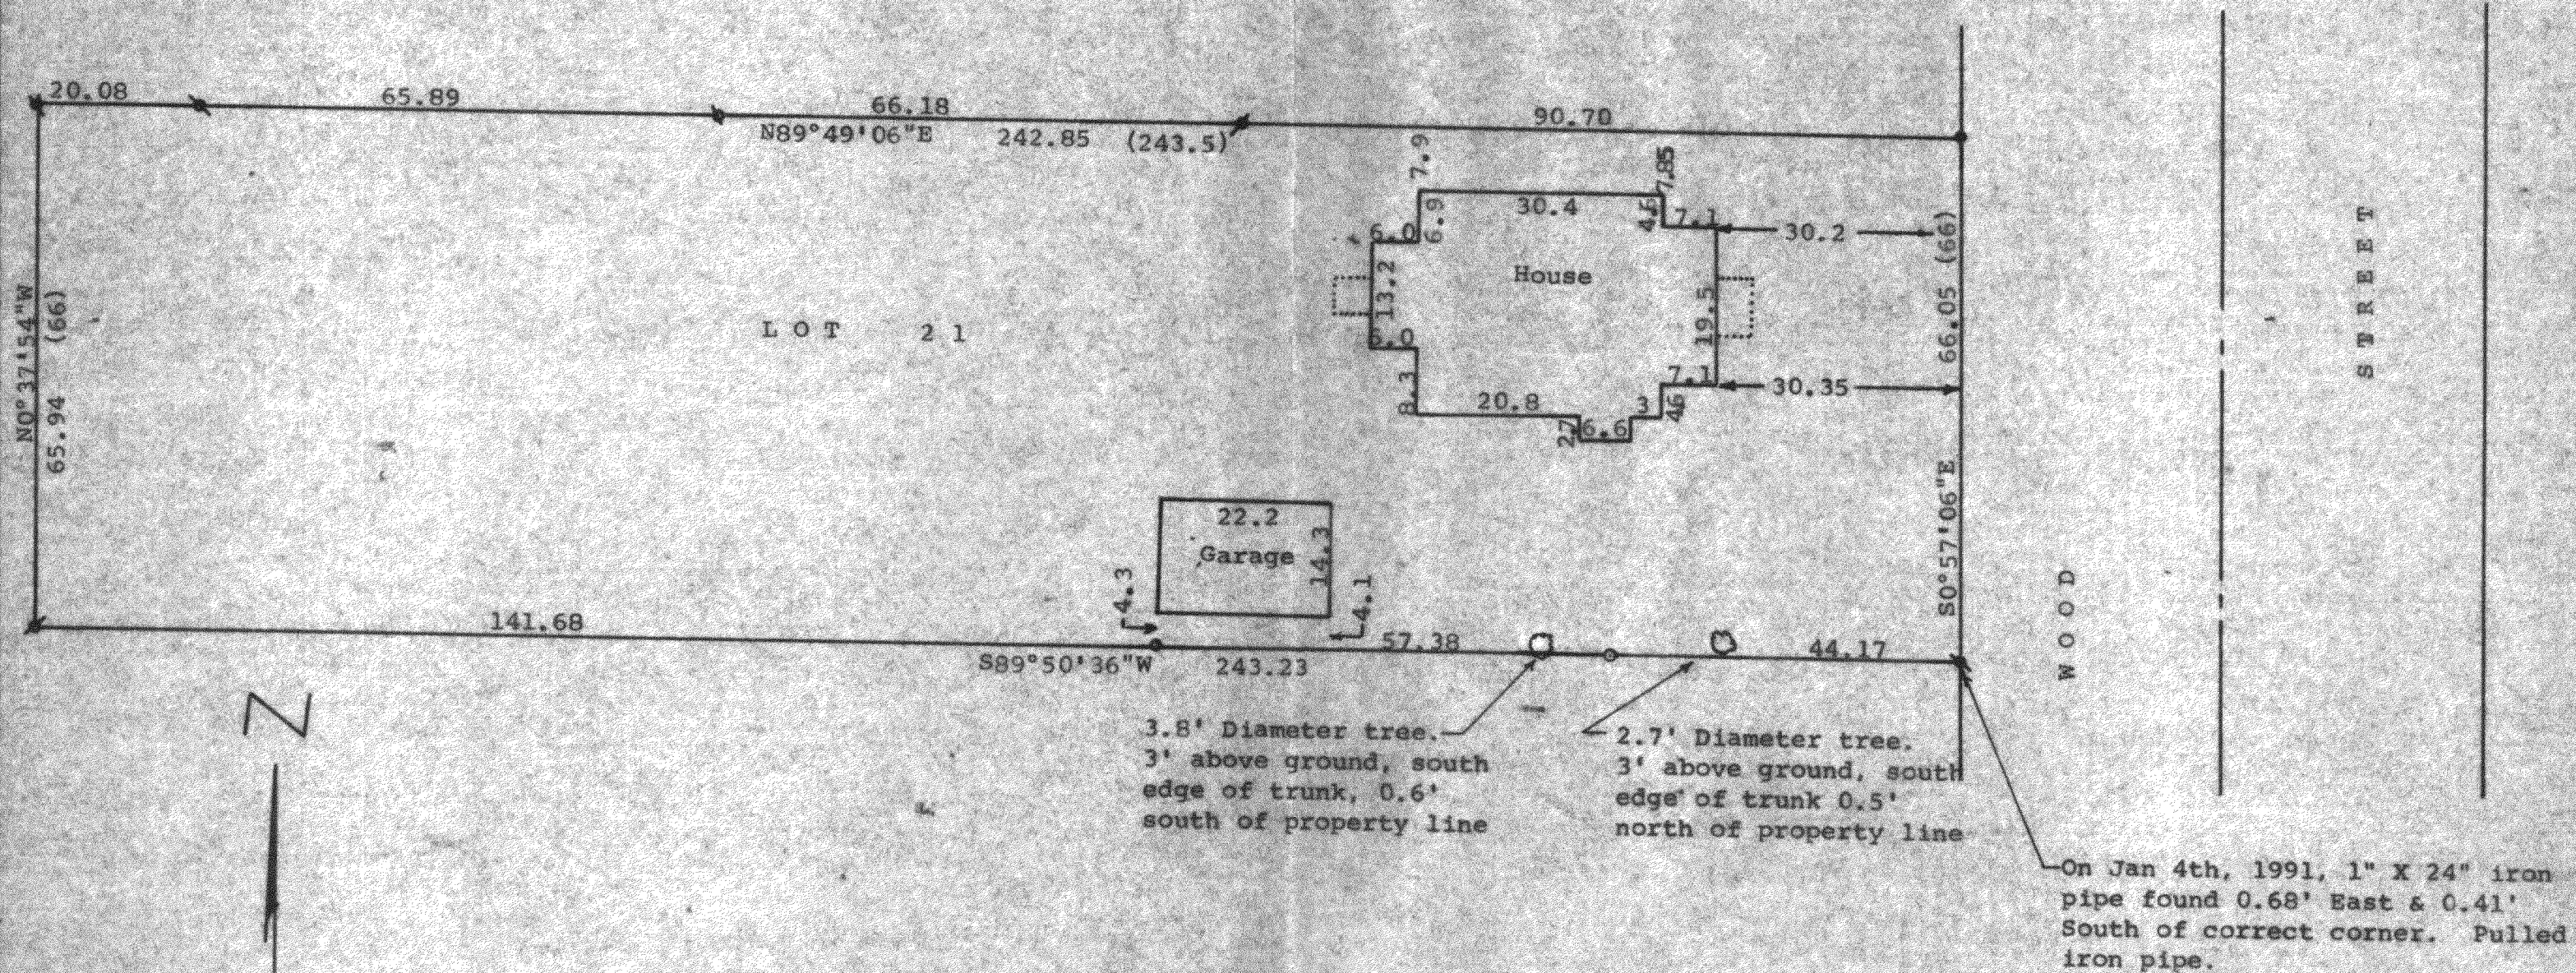

Scale - 1" = 20'
 • = 1" Iron Rod Found
 ◐ = 1" Iron Pipe Found
 ◑ = 3/4" Iron Pipe Found
 ◒ = 3/4" X 24" Iron Pipe Set
 Bearings referenced to the north
 line of Lot 21 with the previously
 assumed bearing of N89°49'06"E
 (0.00) = recorded distance
 Survey ordered by:
 Churchill Real Estate
 322 Park Avenue
 Walworth, WI 53184

STATE OF WISCONSIN) SS
 COUNTY OF WALWORTH)

I, George T. Dunham, Surveyor, certify that I have surveyed
 the property described as follows:

Lot 21 of Clarke's 2nd Addition to the Village of Walworth,
 Walworth County, Wisconsin,

and that the map shown above is a true representation thereof and shows
 the size and location of the property, its exterior boundaries, the location
 of all visible structures and dimensions of all principal buildings thereon,
 boundary fences, apparent easements, roadways and visible encroachments, if
 any, and that I have surveyed the property hereon described, according to the
 official records, to the best of my knowledge and belief.

May 11, 1987

Updated and recertified to this
 4th day of January 1991.

George T. Dunham
 George T. Dunham, Surveyor

