

Plat of Survey

of

Part of Lot 14 of Clarke's 2nd Addition to the Village of Walworth,


a subdivision located in the Southwest 1/4 of Section 22, Town 1 North,
Range 16 East, Village of Walworth, Walworth County, Wisconsin.

More particularly described in a Quit Claim Deed recorded October 15, 2007, as Document No. 721241 as shown below: That part of Lot 14 in Clarke's Second Addition to the Village of Walworth described as follows: Commencing at a point that is 66 feet West of the east line of said lot and which is 66 feet south of the north line of said lot, thence running west in a line parallel with and 66 feet distant from the south line of Lot 13 in said subdivision, 177.1 feet more or less to the West line of said Lot 14, run thence south in the west line of said Lot 14, 66 feet, run thence east 177.1 feet in a line parallel with and 132 feet distant from the north line of said Lot 14 to a point 66 feet from the east line of said lot, run thence north 66 feet to the place of beginning.

Surveyed for: **Shorewest Realtors**
623 Main Street
Lake Geneva, Wisconsin. 53147



Bearings reference to Certified
Survey Map No. 1948.

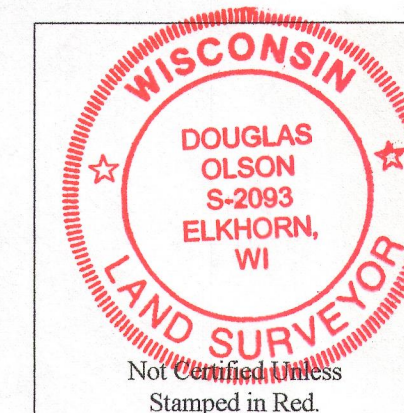

Notes:

- 1) This survey plat is not certified unless signed and sealed in red ink.
- 2) This survey is subject to Wisconsin lien laws. This Plat of Survey is the notice of intent to file lien. Lien waiver required.


Copyright 2013 by Jensen & Olson Land Surveying, LLC.

All rights reserved. No part of this survey plat may be reproduced or transmitted in any form by any means - graphic, electronic, or mechanical, including photocopying, tracing, or information storage and retrieval systems - without permission in writing from Douglas G. Olson, Jensen & Olson Land Surveying, LLC.


I hereby certify that I have surveyed the above described property and the map hereon is correct to the best of my professional knowledge and belief and shows the size and location of the property, its exterior boundaries, the location and dimensions of all visible structures thereon, boundary fences, apparent easements and roadways and visible encroachments, if any.

This survey is made for the exclusive use of the present owners of the property, and also those who purchase, mortgage or guarantee title thereto, within one year from the date hereof.


Douglas G. Olson
Wisconsin Registered Land Surveyor - 2093

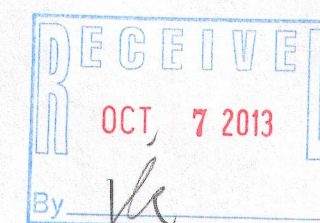

Devils Lane

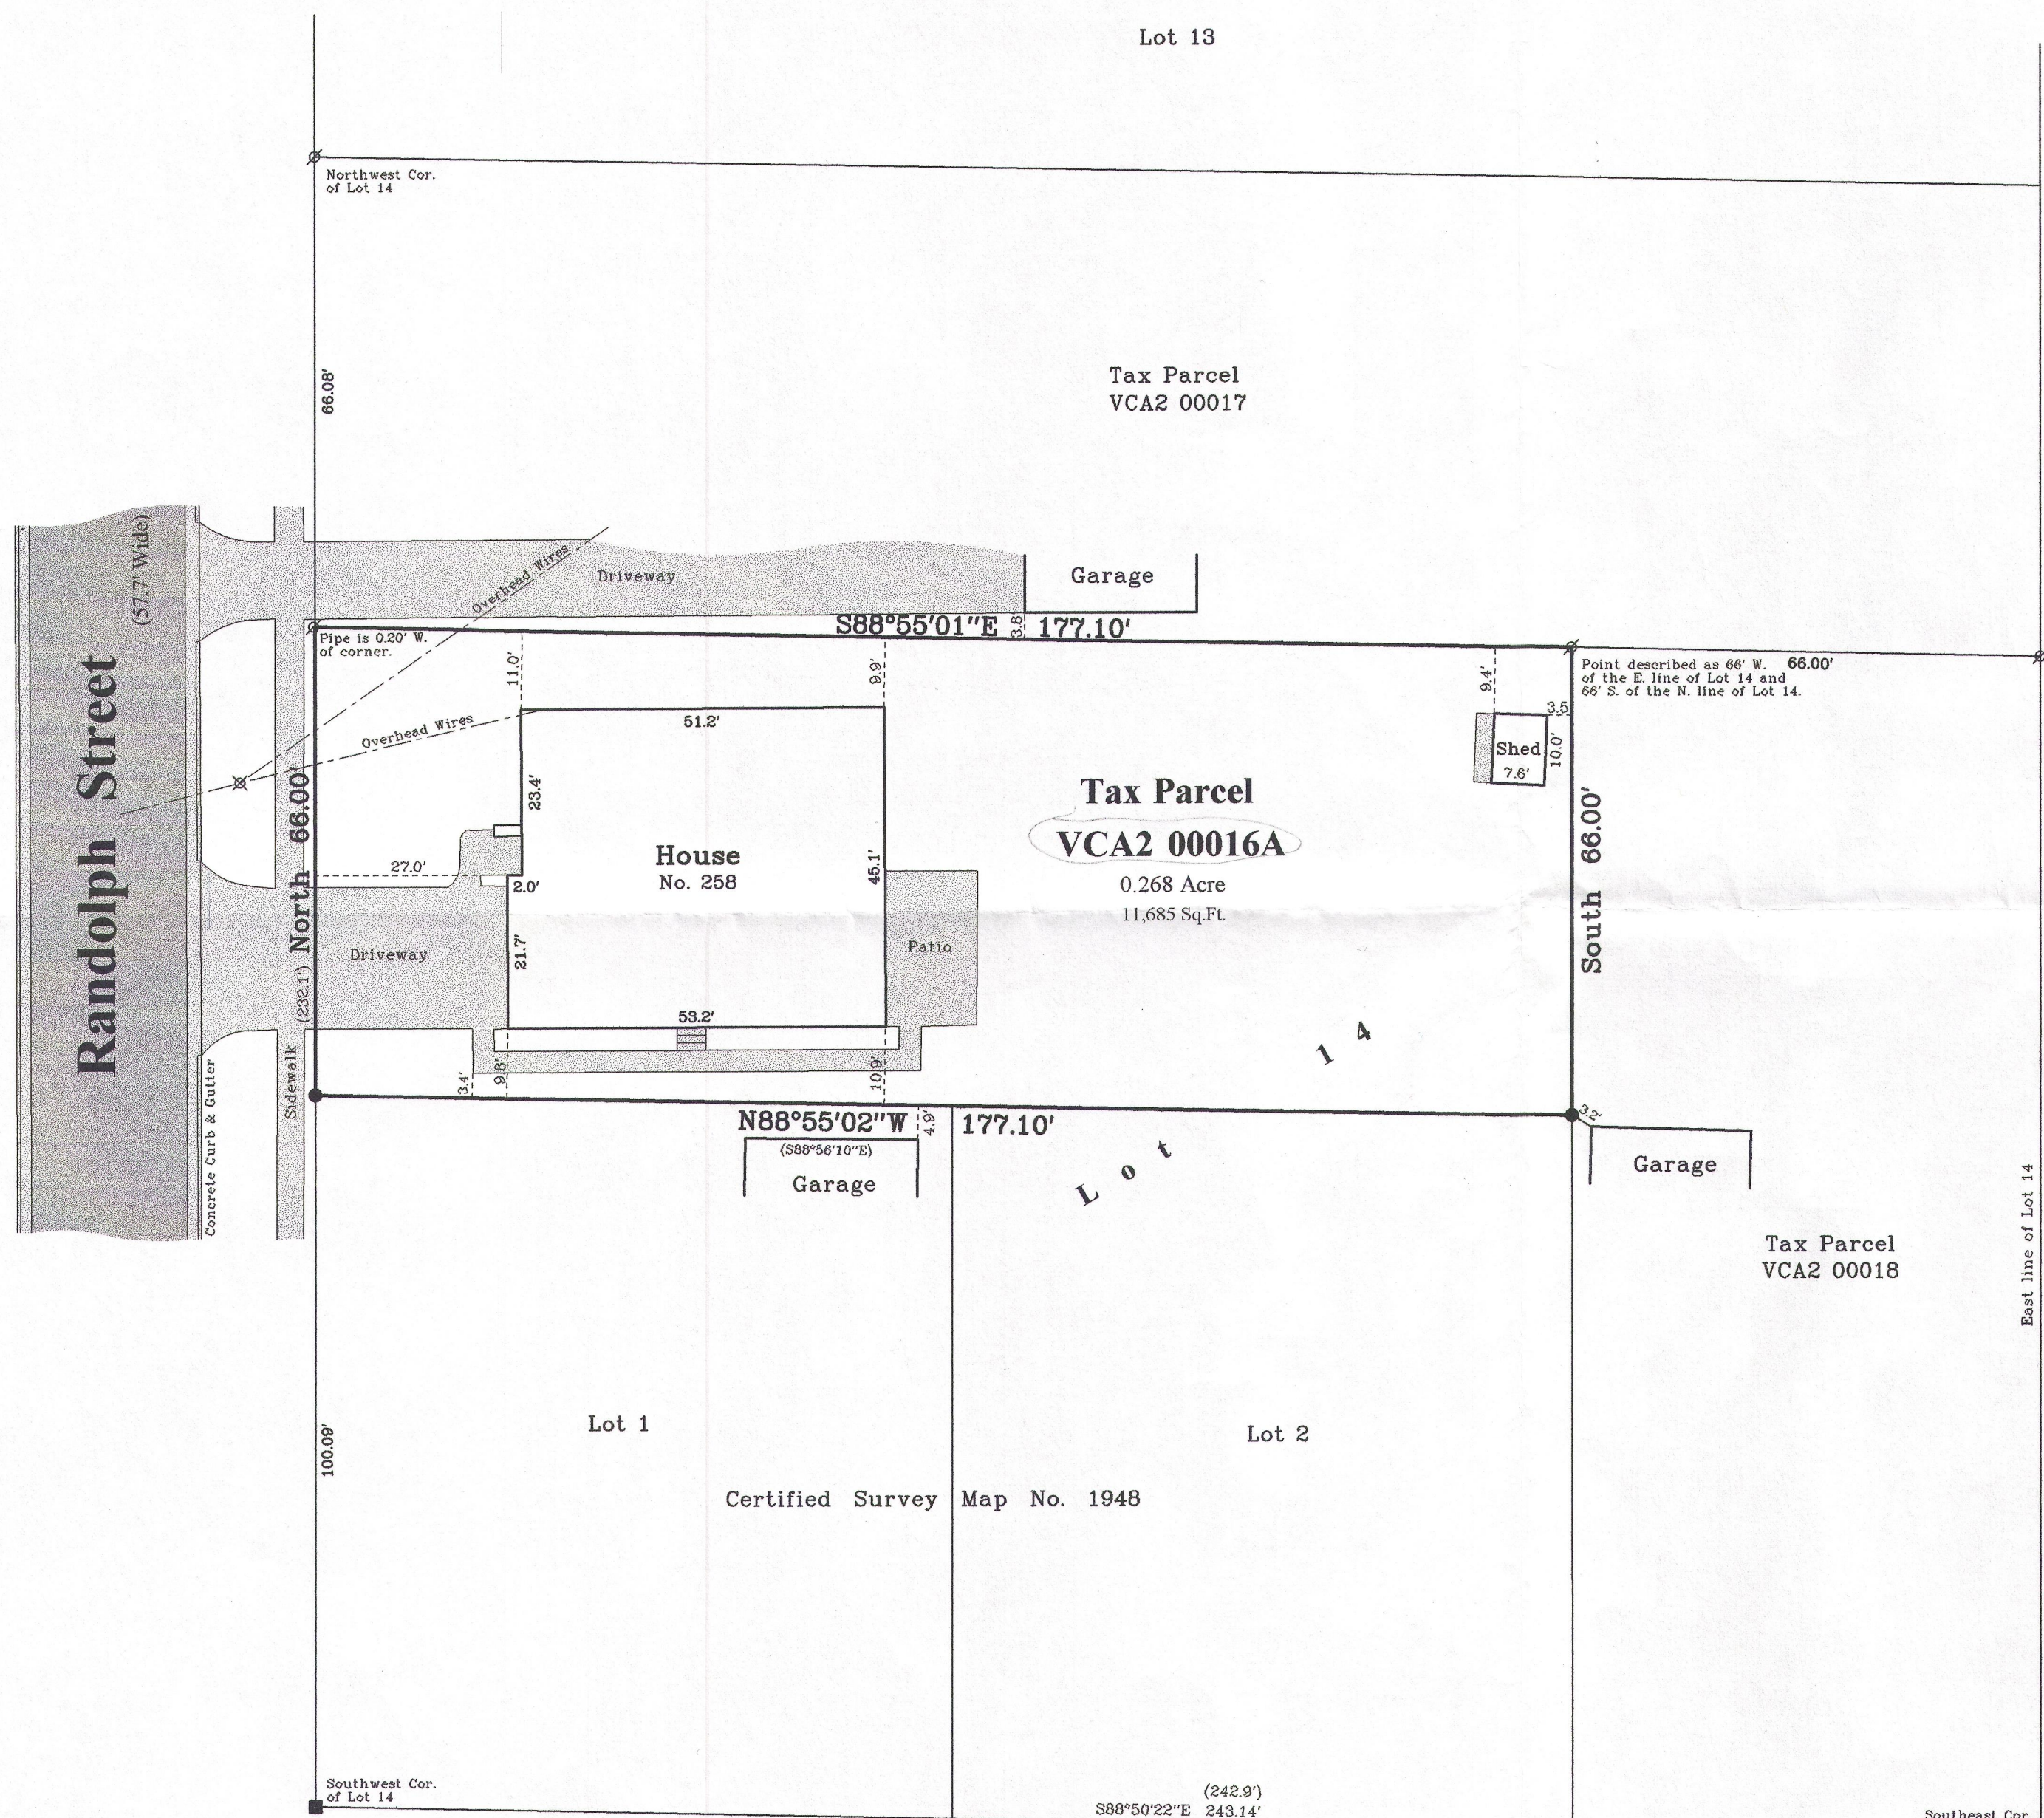

Survey Date: April 30, 2013.
Revisions:

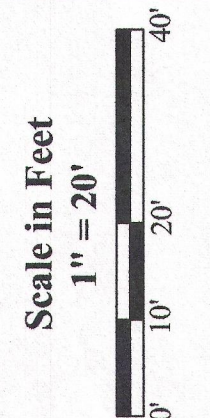

Jensen & Olson Land Surveying, LLC
45 South Wisconsin Street * P.O. Box 322 * Elkhorn, Wisconsin. 53121
Telephone: (262) 723-3434 * Facsimile: (262) 723-8044
Email: jensen.olson@elknet.net

Legend
Found Concrete Monument
Found Iron Pipe
Found Iron Rod
Recorded Information
Utility Pole
Asphalt Surface
Concrete Surface

Sheet 1 of 1 Sheets
Drawing Name: 1416-2013027-2013027Plat.scd
Job Reference Number
2013.027

2013.027

009-1168