


DUNHAM SURVEYING, S.C.
SURVEYING & SUBDIVIDING

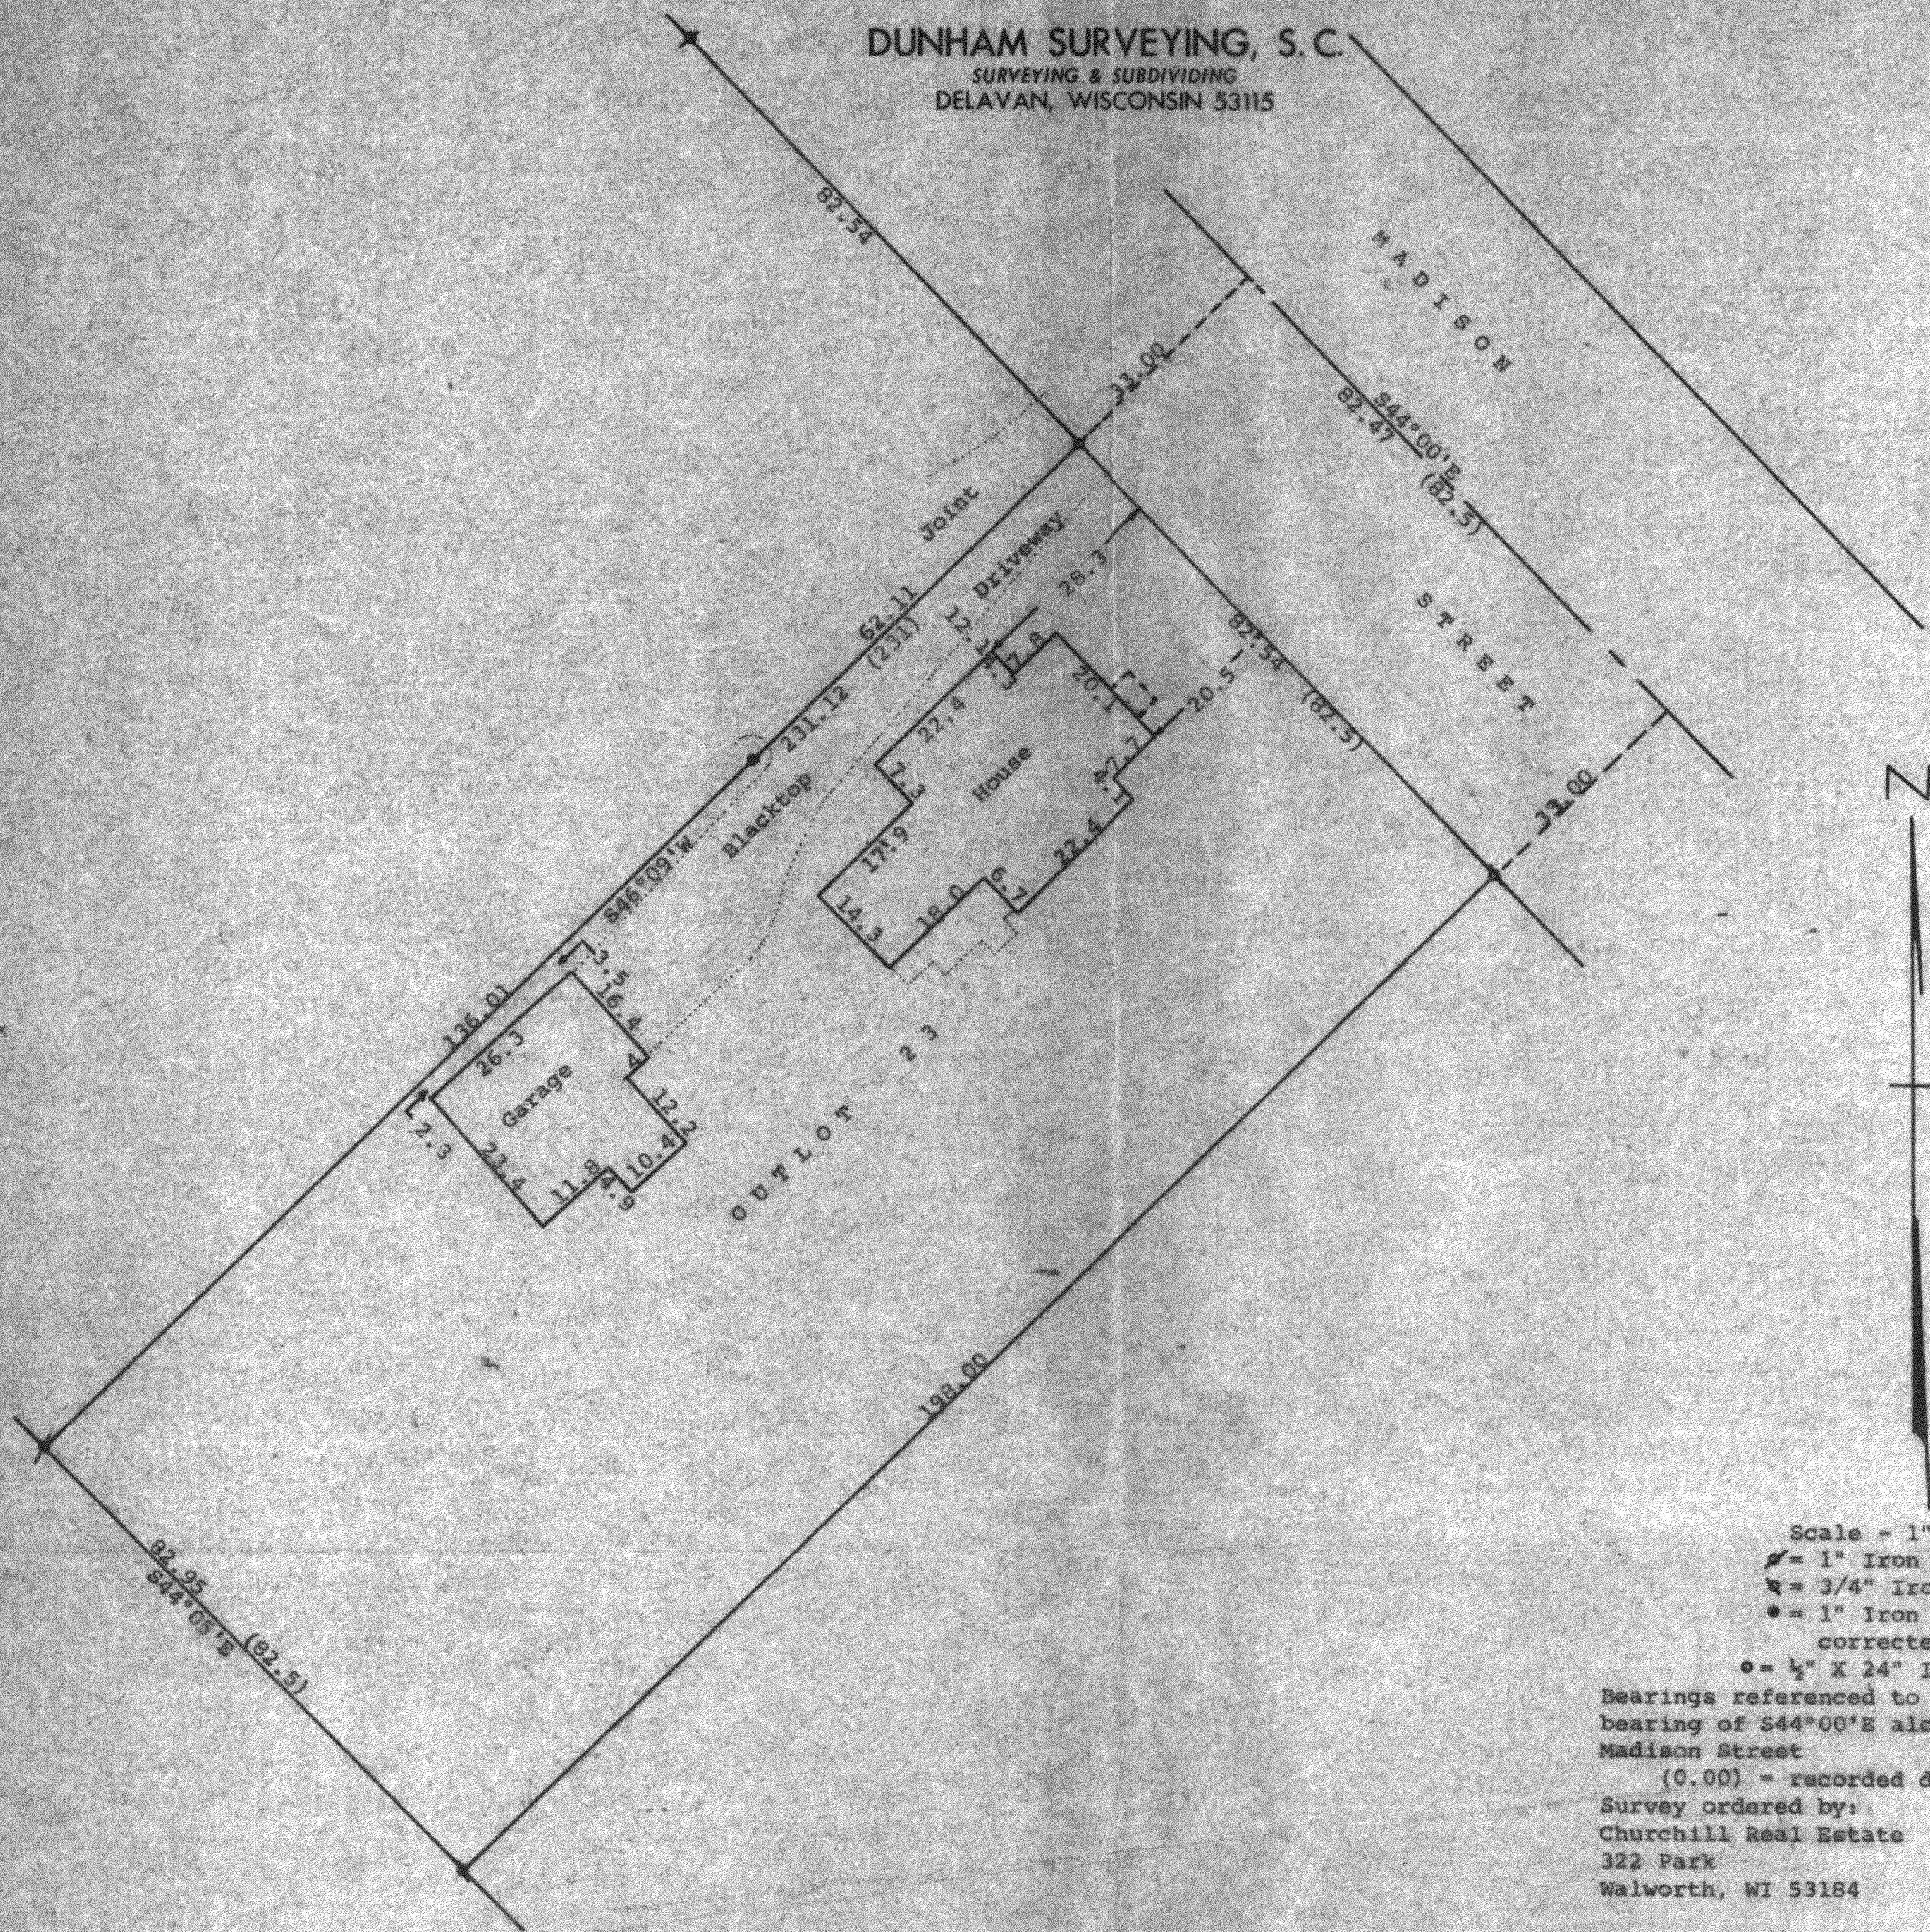

Scale = 1" = 20'
 ⚭ = 1" Iron Pipe Found
 ⚭ = 3/4" Iron Pipe Found
 ● = 1" Iron Pipe Found bent and corrected.
 ○ = 1/2" X 24" Iron Pipe Set
 Bearings referenced to the previously recorded bearing of S44°00'E along the centerline of Madison Street
 (0.00) = recorded distance
 Survey ordered by:
 Churchill Real Estate
 322 Park
 Walworth, WI 53184

STATE OF WISCONSIN)
 COUNTY OF WALWORTH)

I, George T. Dunham, Surveyor, certify that I have surveyed the property described as follows:
 and that the plat shown hereon is a correct representation thereof and shows the size and location of the property, its exterior boundaries, the location of all visible structures and dimensions of all principal buildings thereon, boundary fences, apparent easements, roadways and visible encroachments, if any, and that I have surveyed the property hereon described, according to the official records, to the best of my knowledge and belief.
 December 19, 1990

George T. Dunham
 George T. Dunham, Surveyor

