#56-66

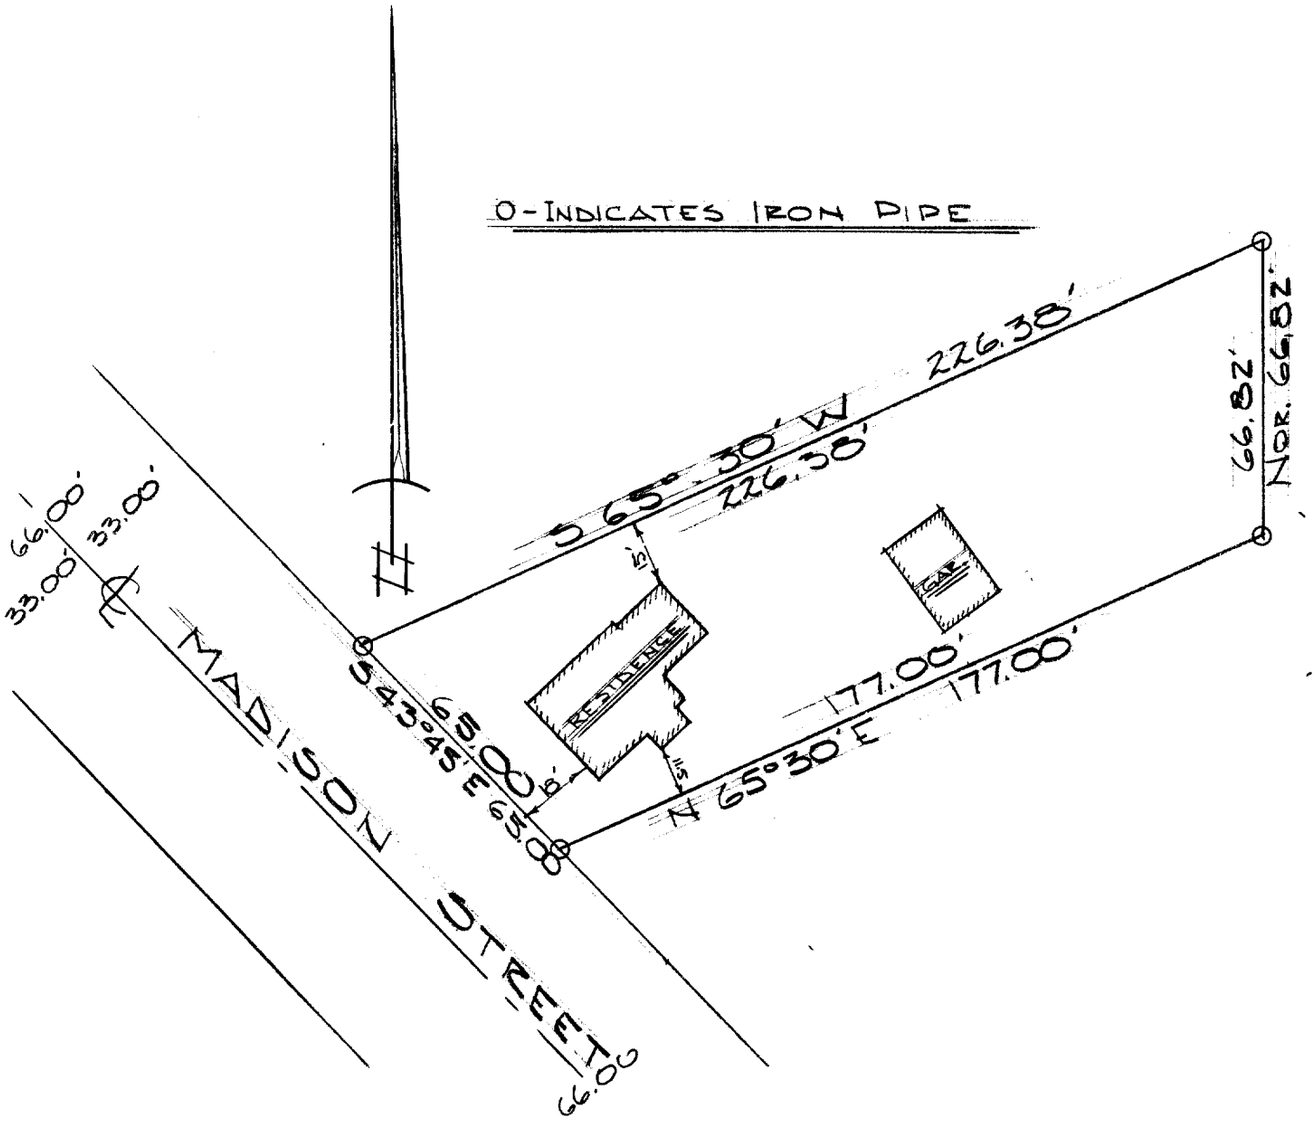

DESCRIPTION: Lot 3 and the Southeasterly 15 feet of Lot 4, D.A. Rollos Addition, in the Village of Walworth, Walworth County, Wisconsin.

CERTIFICATE: I, hereby certify that I have surveyed the above mentioned property and that the hereon portrayed is an accurate survey and a true representation thereof and correctly shows the exterior boundary lines and the location of the buildings and the other improvements thereof.

April 20, 1966.

James F. Biagi

James F. Biagi, RLS 272

WISCONSIN
JAMES F.
BIAGI
MILWAUKEE,
WIS.
LAND SURVEYOR

VRA-9

9-5B