PARTS OF LOTS 9 AND 10, ORIGINAL PLAT
CITY OF WHITEWATER, WISCONSIN

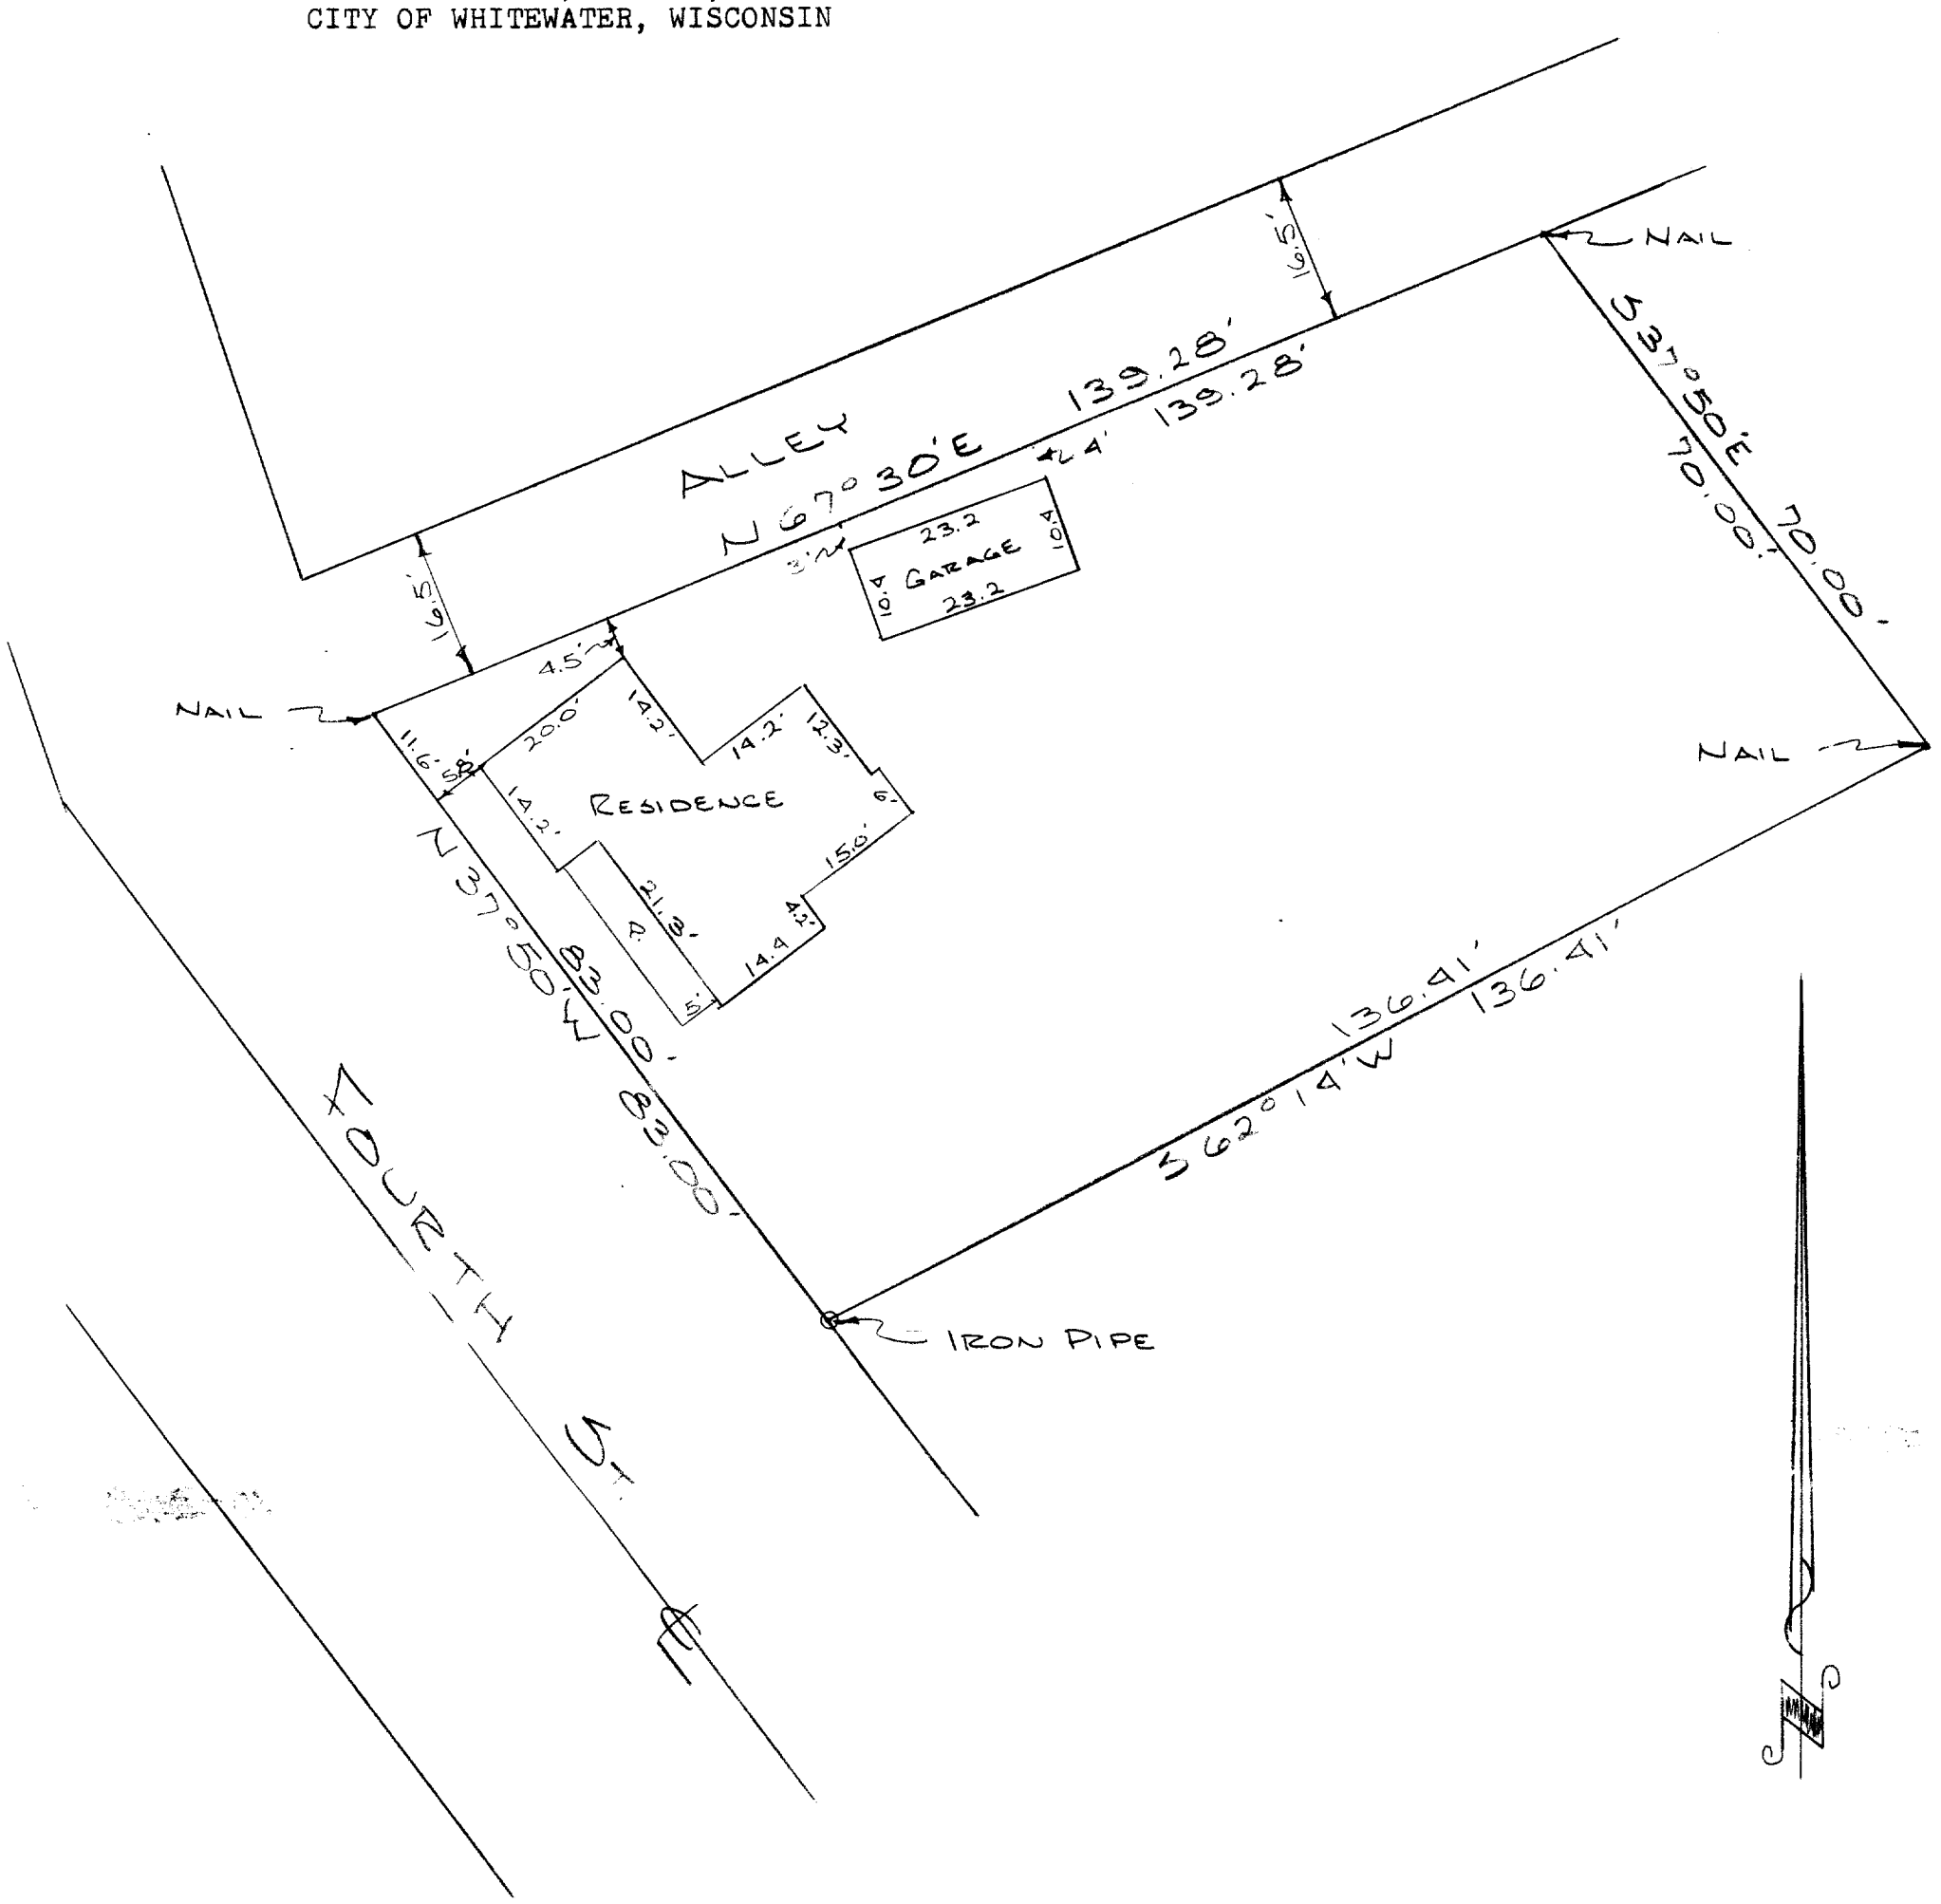

DESCRIPTION: Commencing at the NW corner of Lot 10, Original Plat, City of Whitewater, Walworth County, Wisconsin, thence N 67°30' E along the north line of Lots 9 and 10, 139.28 feet, thence S 37°50' E along the East line of said Lot 9, 70.00 feet, thence S 62°14' W, 136.41 feet to the West line of said Lot 10, thence N 37°50' W along said West line, 83.00 feet to the Place of Beginning.

CERTIFICATE: I, James F. Biagi, surveyor, do hereby certify that I have surveyed the lands hereon described.

DATED: October 7, 1970

James F. Biagi R.L.S. 272

WISCONSIN JAMES F. BIAGI MILWAUKEE, WIS. LAND SURVEYOR

REVISIONS			Part of Lots 9 and 10, Orig. Plat, Whitewater, Wisconsin		
NO.	DATE	BY			
1			Sam Soffa		
2					
3			DRAWN BY AR	SCALE 1" = 20'	MATERIAL
4			CHK'D JFB	DATE 10/7/70	DRAWING NO.
5			TRACED	APP'D	