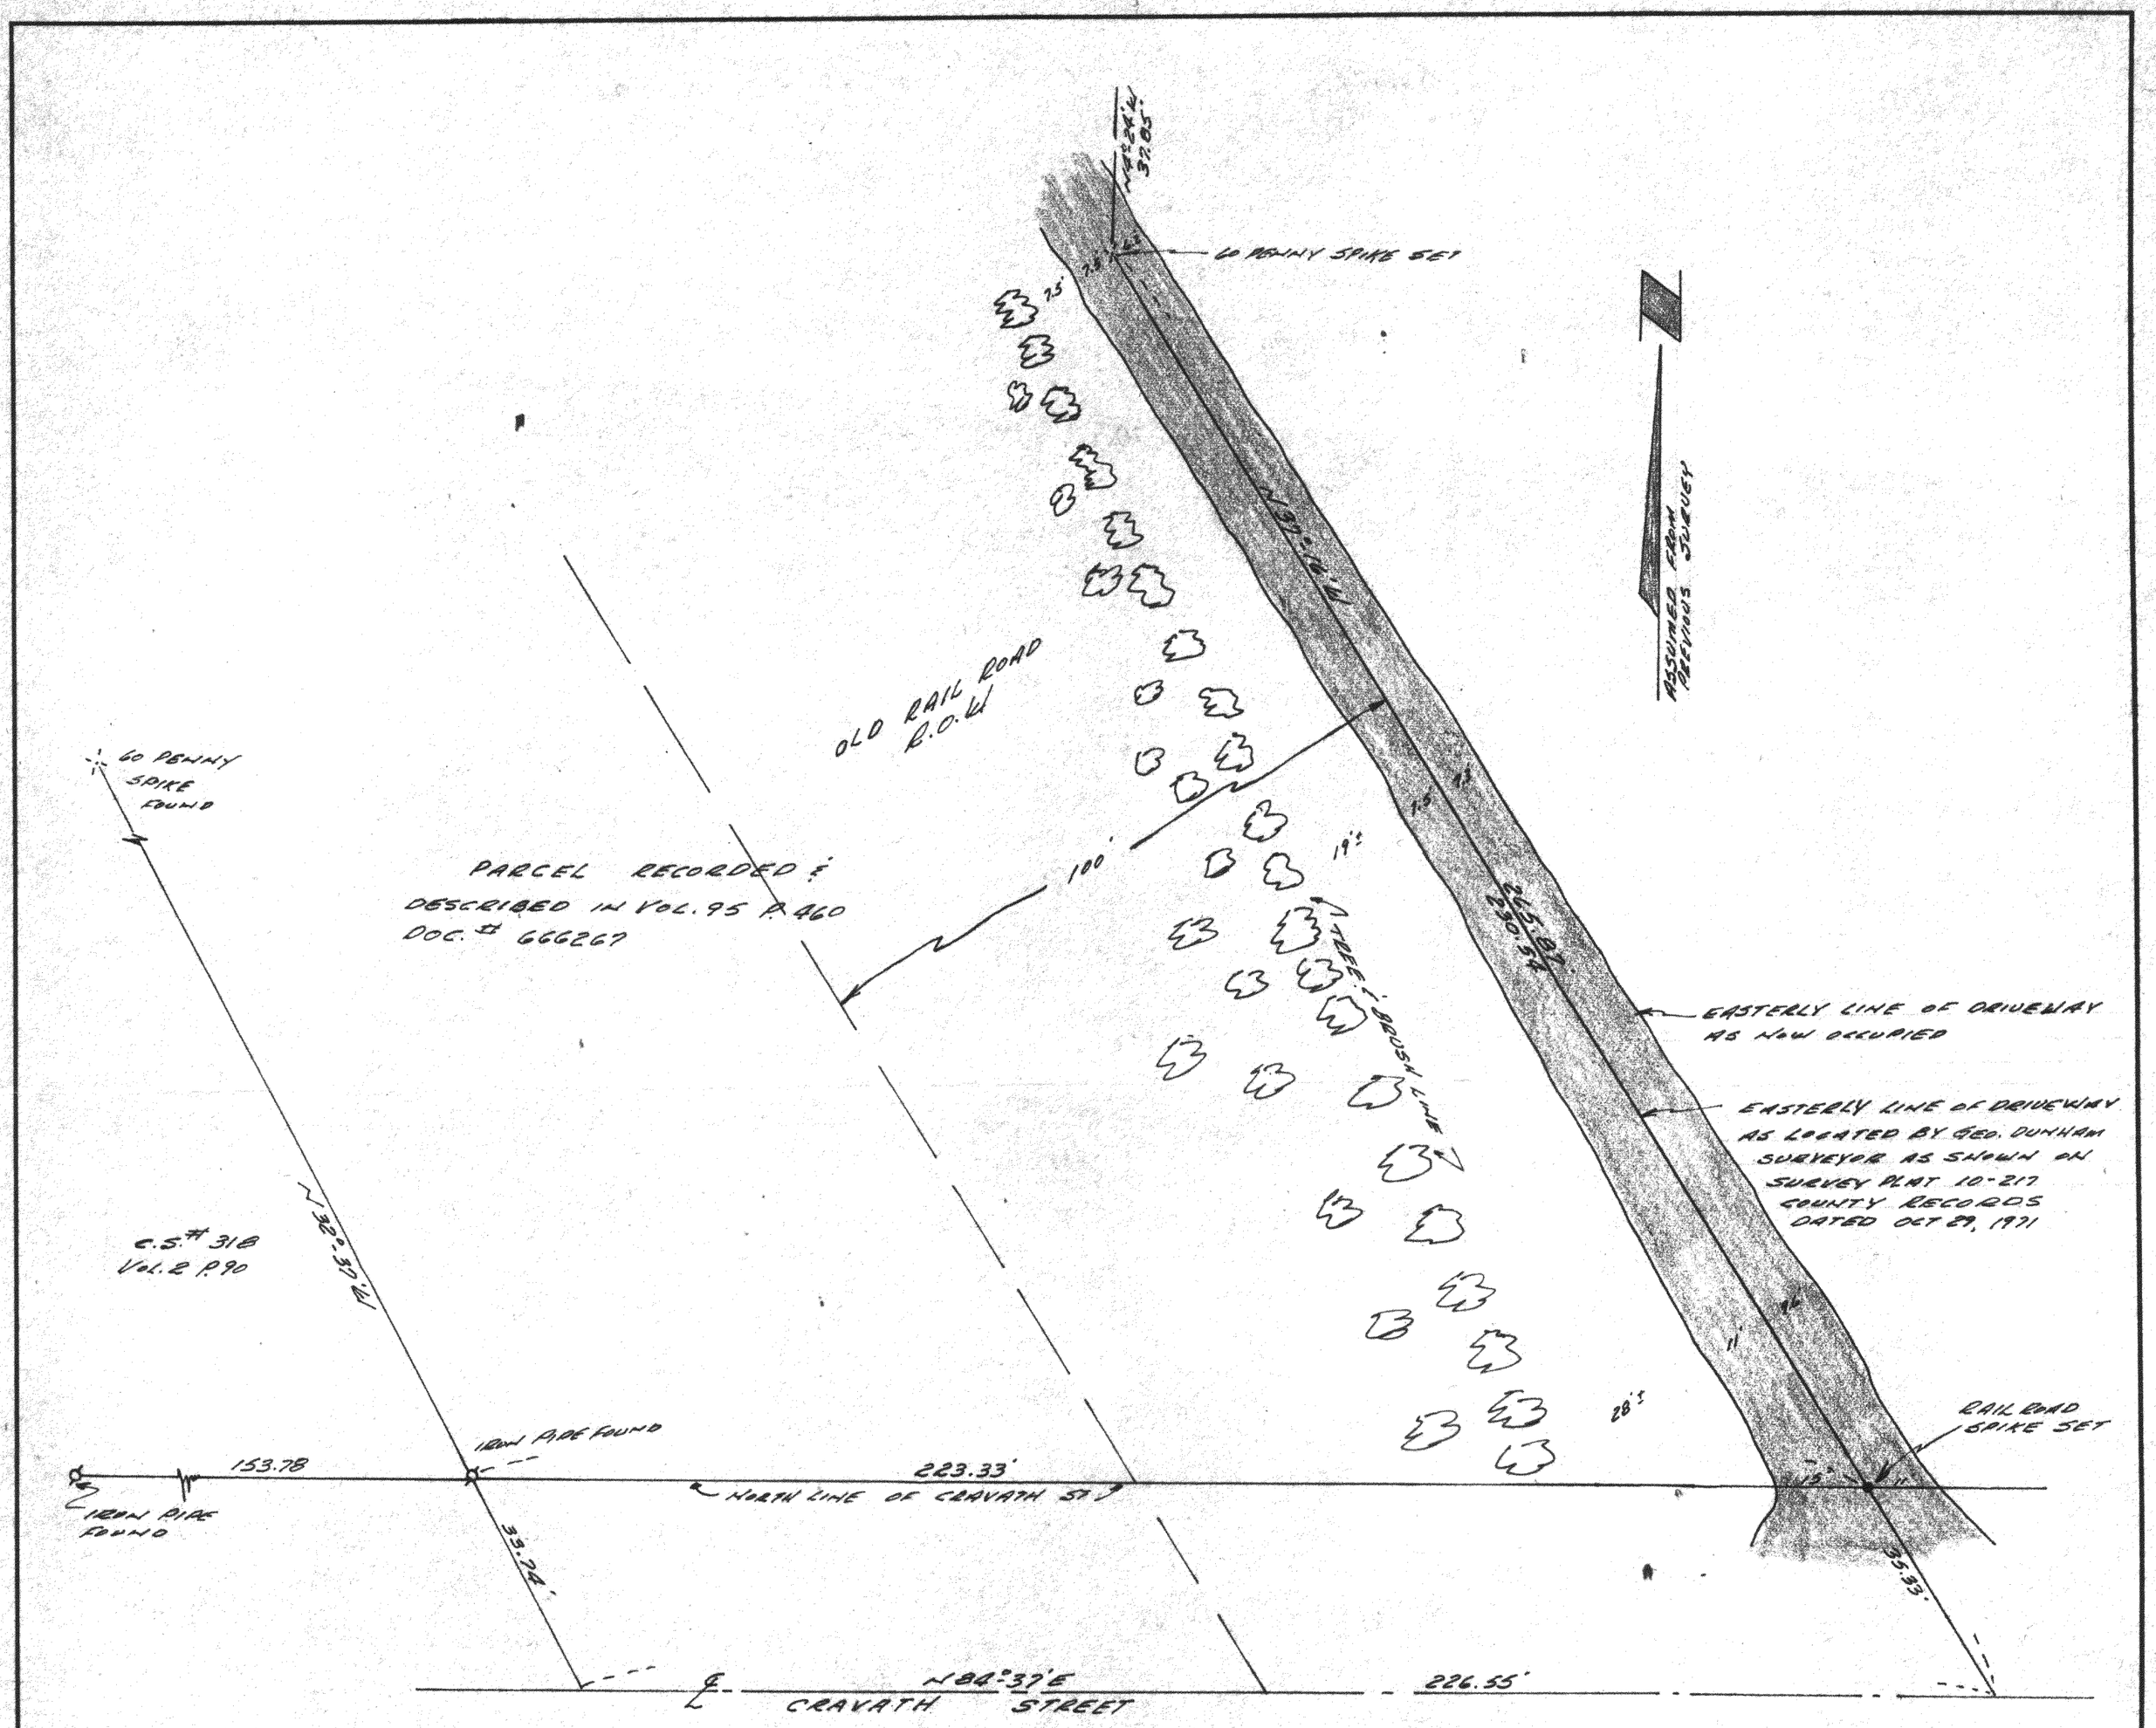

PLAT OF SURVEY

OF

RIGHT OF WAY (DRIVEWAY) FOR LAND LOCATED IN THE SOUTH ½ OF THE NE ¼ OF SEC. 4, T4N R15E, CITY OF WHITEWATER, WALWORTH COUNTY, WISCONSIN.

OWNER: DANIEL L. SCHROEDL, WHITEWATER, WIS

SURVEYED FOR: L. SWEET, ELKHORN, WIS

WISCONSIN THOMAS P. A. JENSEN S-1084 ELKHORN, WIS. LAND SURVEYOR

Thomas P.A. Jensen
SURVEYOR

SCALE 1" = 20'

DATE 1-7-77

1658.082

NO. 175H 300 9-68

U.P-24

10-291 J