


PRAIRIE STREET

N 0°00' E 206.25'

A part of the East 1/2 of the Northeast 1/4 of Section 5, Town 4 North, Range 15 East, Walworth County, Wisconsin, bounded as follows, to-wit: Beginning on the N. line of Main Street in the City of Whitewater, at a point 9 rods East of the East line of Prairie Street and the S.W. corner of lands formerly owned by G.W. Esterly, and running thence N. on the N. line of said Esterly place 11 rods and 4 3/4 feet; thence West 36 feet; thence North 20 feet; thence West 30 feet and 3 inches; thence South parallel with said Esterly's West line 12 1/2 rods to the North line of Main Street; thence East on the North line of Main Street to the place of beginning. Grantor also grants and conveys unto grantees all rights of grantor to the use of a right-of-way or easement from the barn located on the North end of the above described premises to Prairie Street or used and occupied at the time of execution and delivery of Sheriff's deed on foreclosure dated March 17, 1934, recorded April 3, 1934 in Vol. 232 of Deeds on Page 611, Walworth County Records.

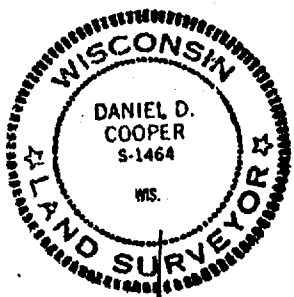

SCALE 1" = 20'

I hereby certify that I have surveyed the property described hereon and that the map shown hereon is a true and accurate representation thereof to the best of my professional knowledge and belief.

Dated this 24 day of Oct., 1989

Daniel D. Cooper  
Daniel D. Cooper, RLS No. S-1464

(82.50)  
82.59

SET 3/4" X 24" IRON ROD

(REC. 66)  
66.08'

N 88° 25' E


SIDEWALK

SURVEY ORDERED BY RAULAND AGENCY

WEST MAIN STREET

DRAWING NO. 3540

Reduced

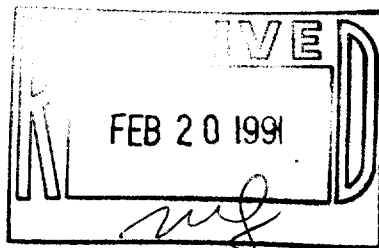

TAX KEY #

1WUP 00101

10-434