


ALTA / ACSM LAND TITLE SURVEY

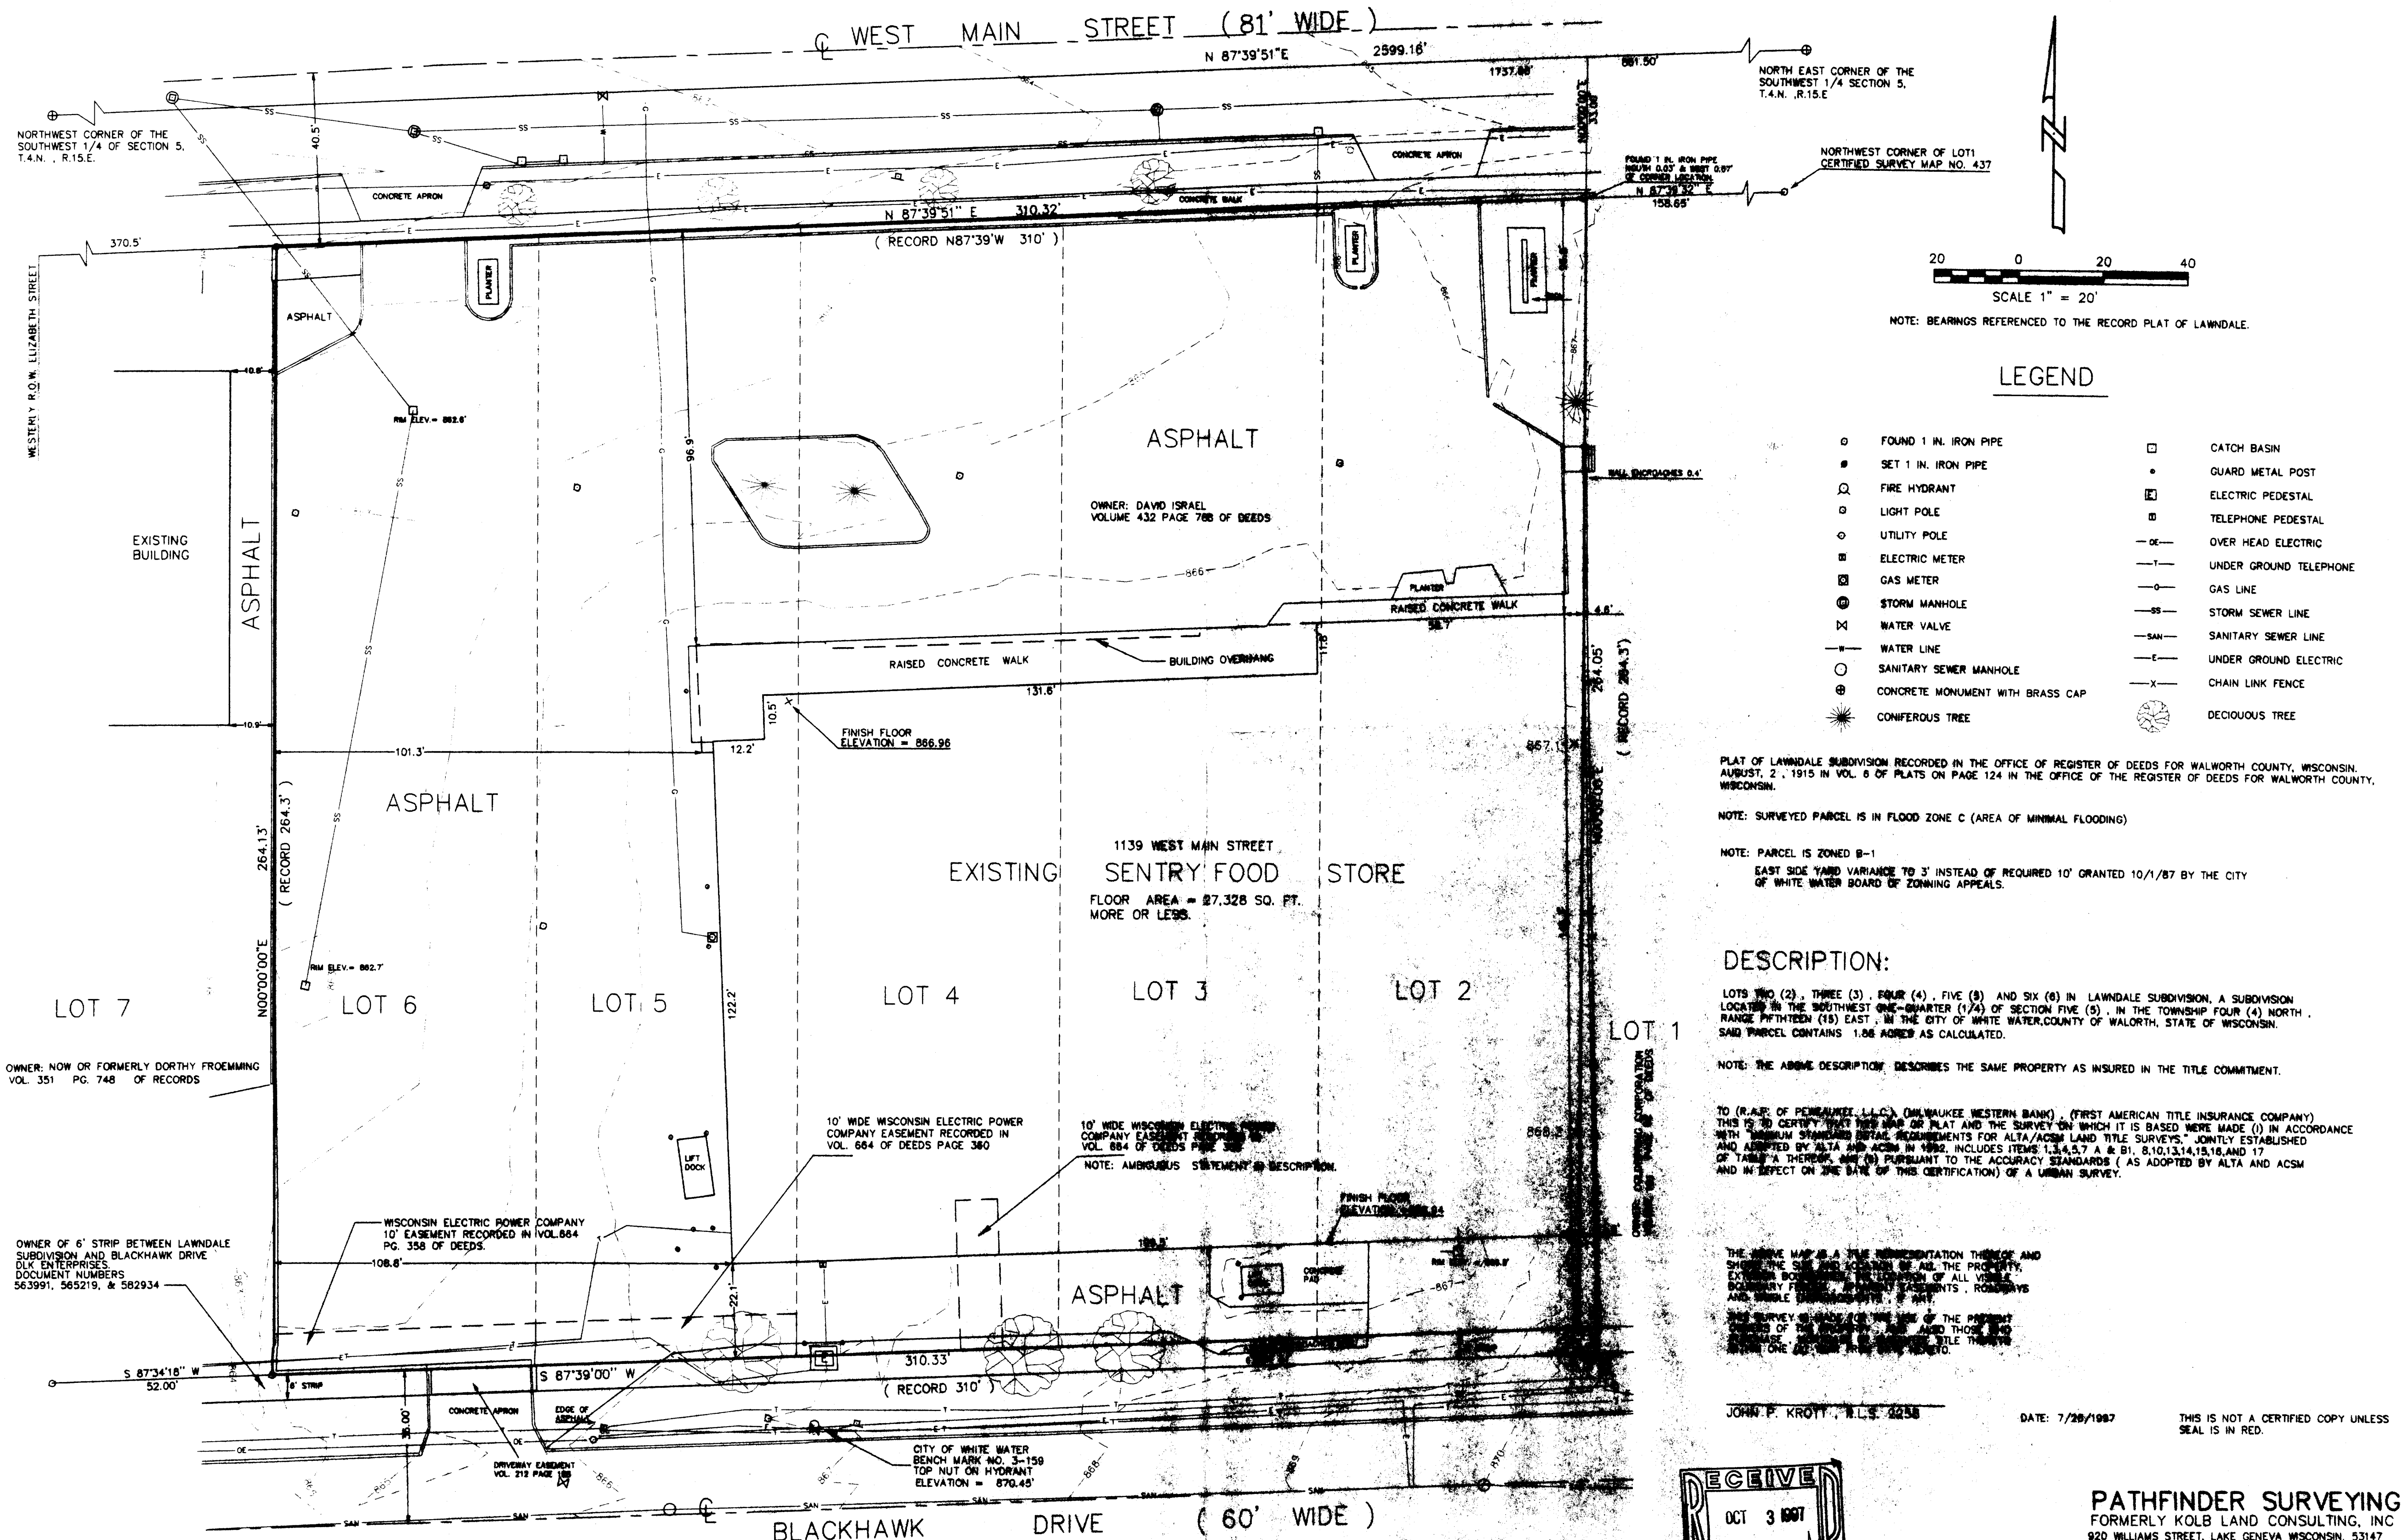

JOHN P. KROTT, M.L.S. 2238

DATE: 7/26/1987

THIS IS NOT A CERTIFIED COPY UNLESS
SEAL IS IN RED.

PATHFINDER SURVEYING
FORMERLY KOLB LAND CONSULTING, INC
920 WILLIAMS STREET, LAKE GENEVA WISCONSIN. 53147
(414) 248-3897

JOB NUMBER 97048 / 4/15/5/ A-2