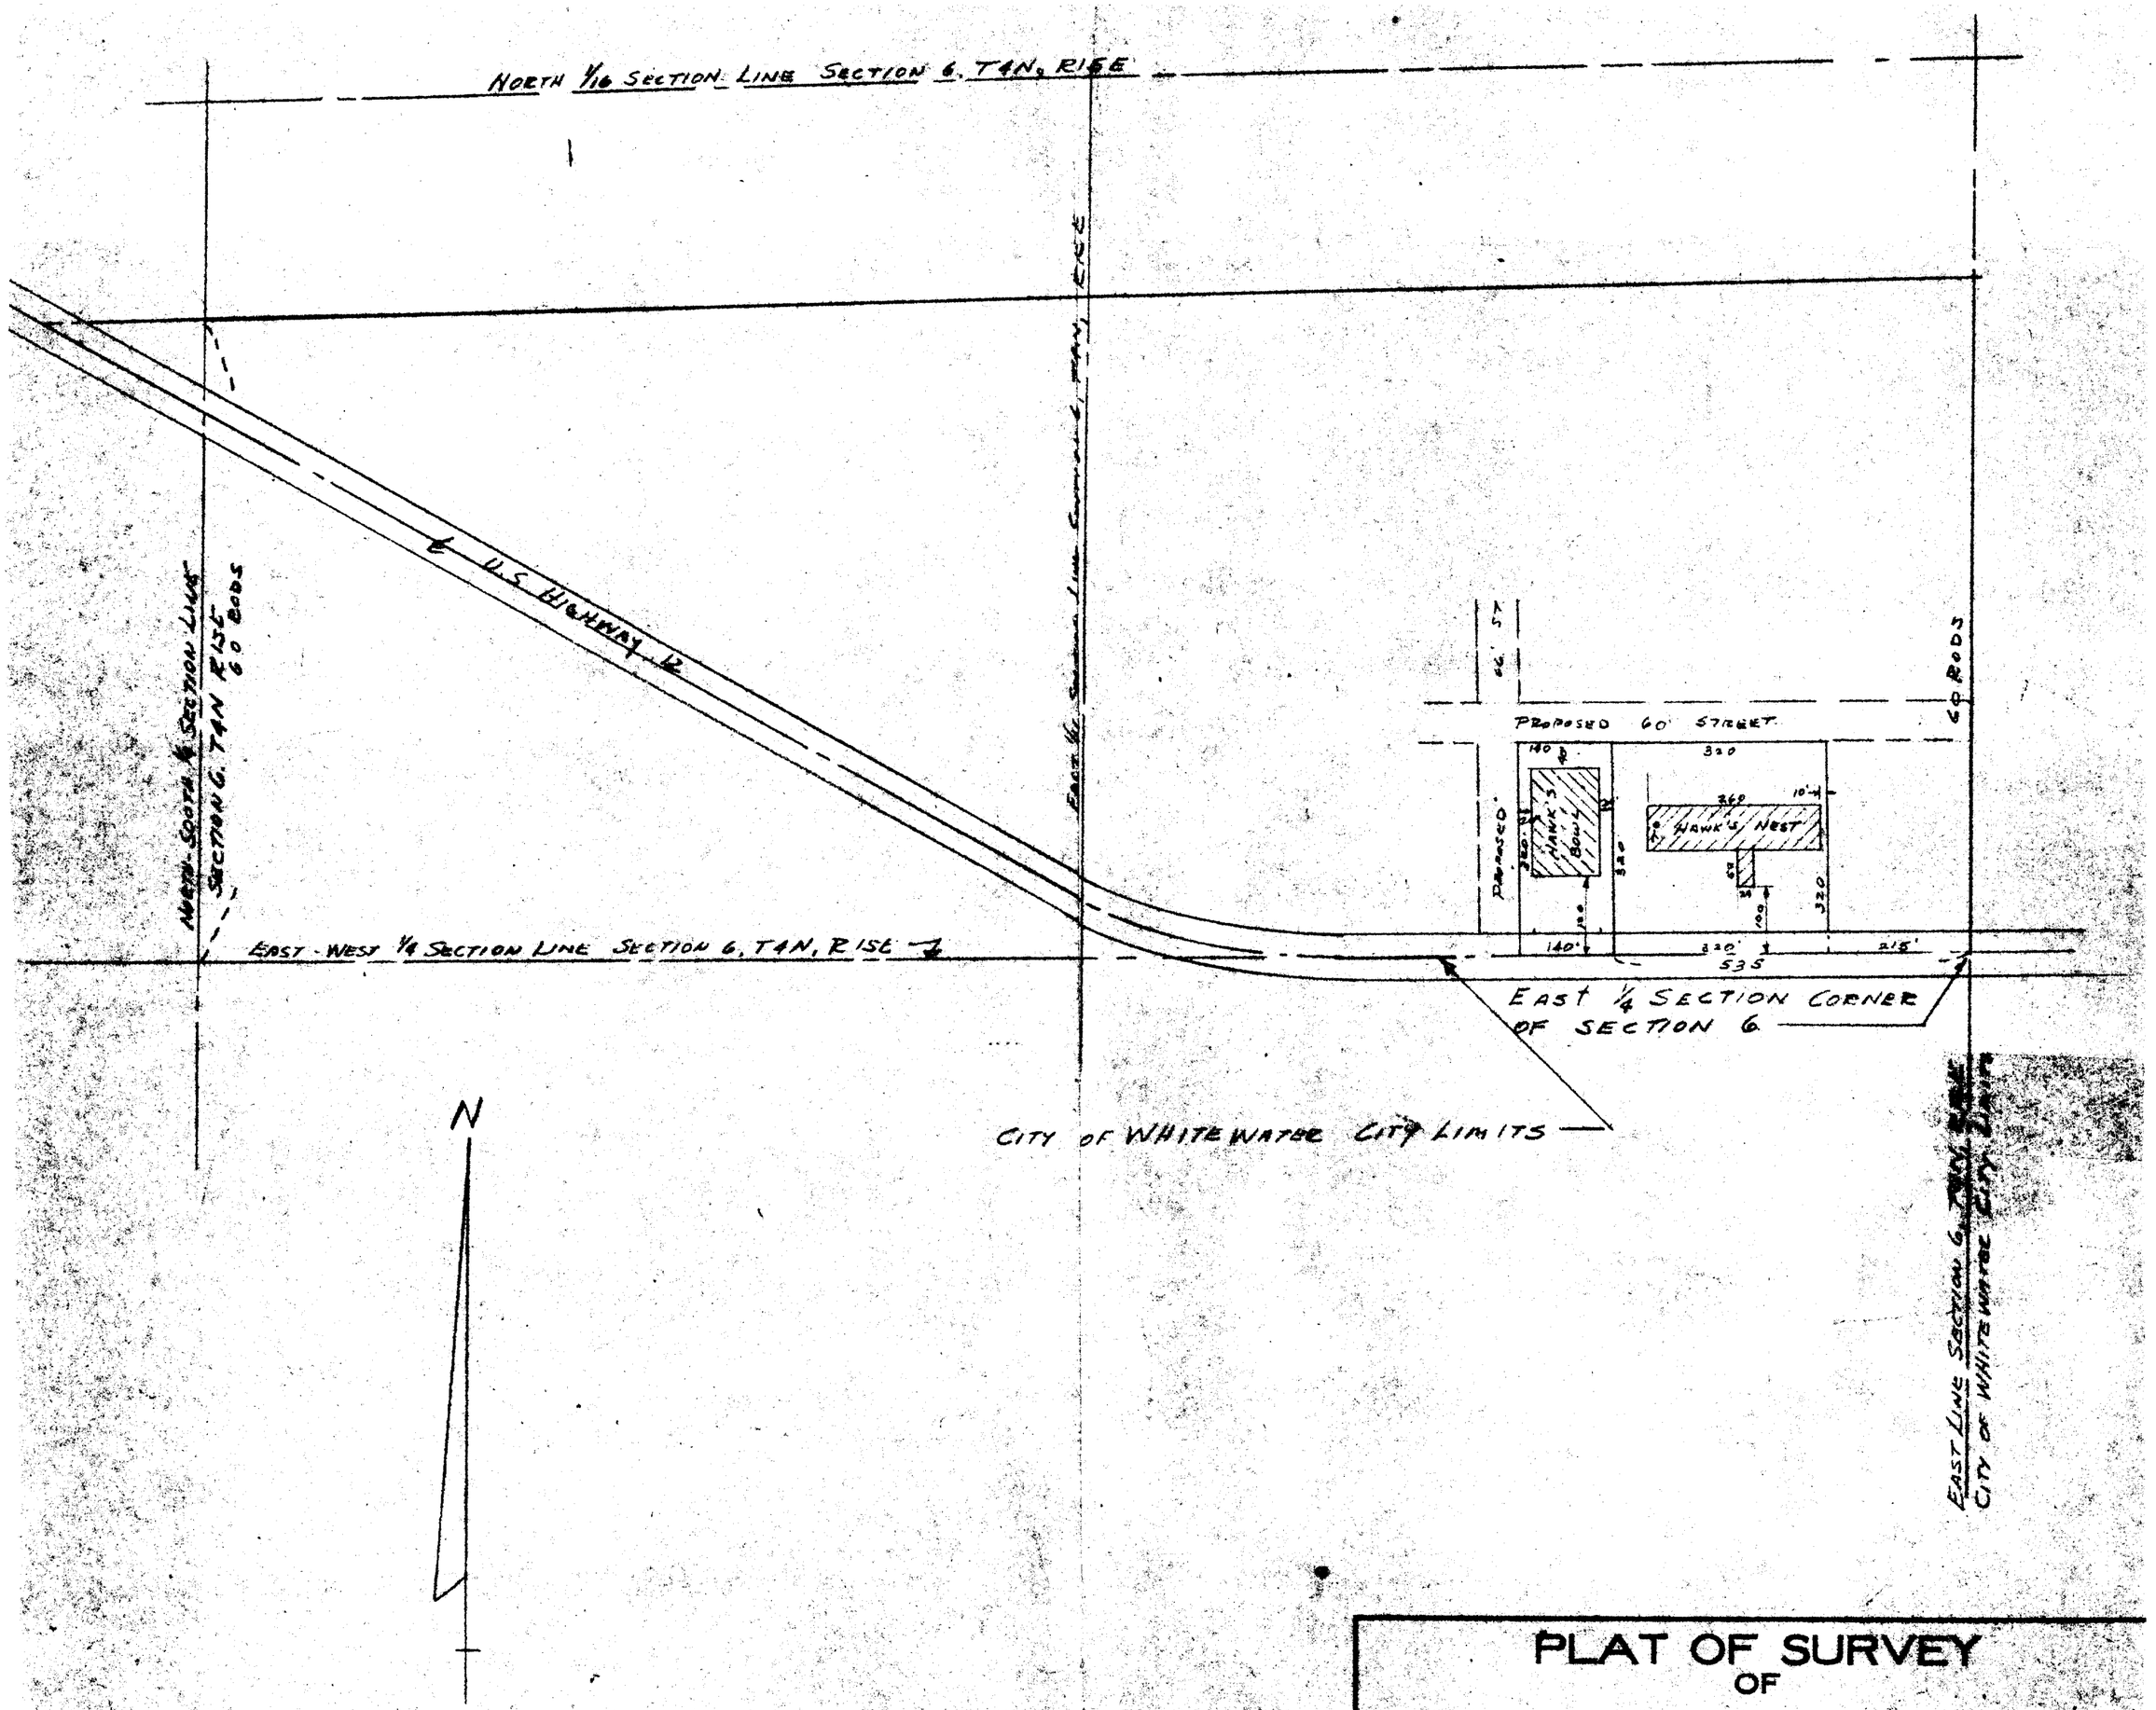

PLAT OF SURVEY
OF

LAND LOCATED IN SECTION 6, T4N R15E OF WALWORTH COUNTY, WISCONSIN.

Lloyd L. Jensen

SCALE 1" = 200'

DATE JUNE 17, 19[illegible]

UP-160 B + UP-160 C

10-~~709~~ 757 J