


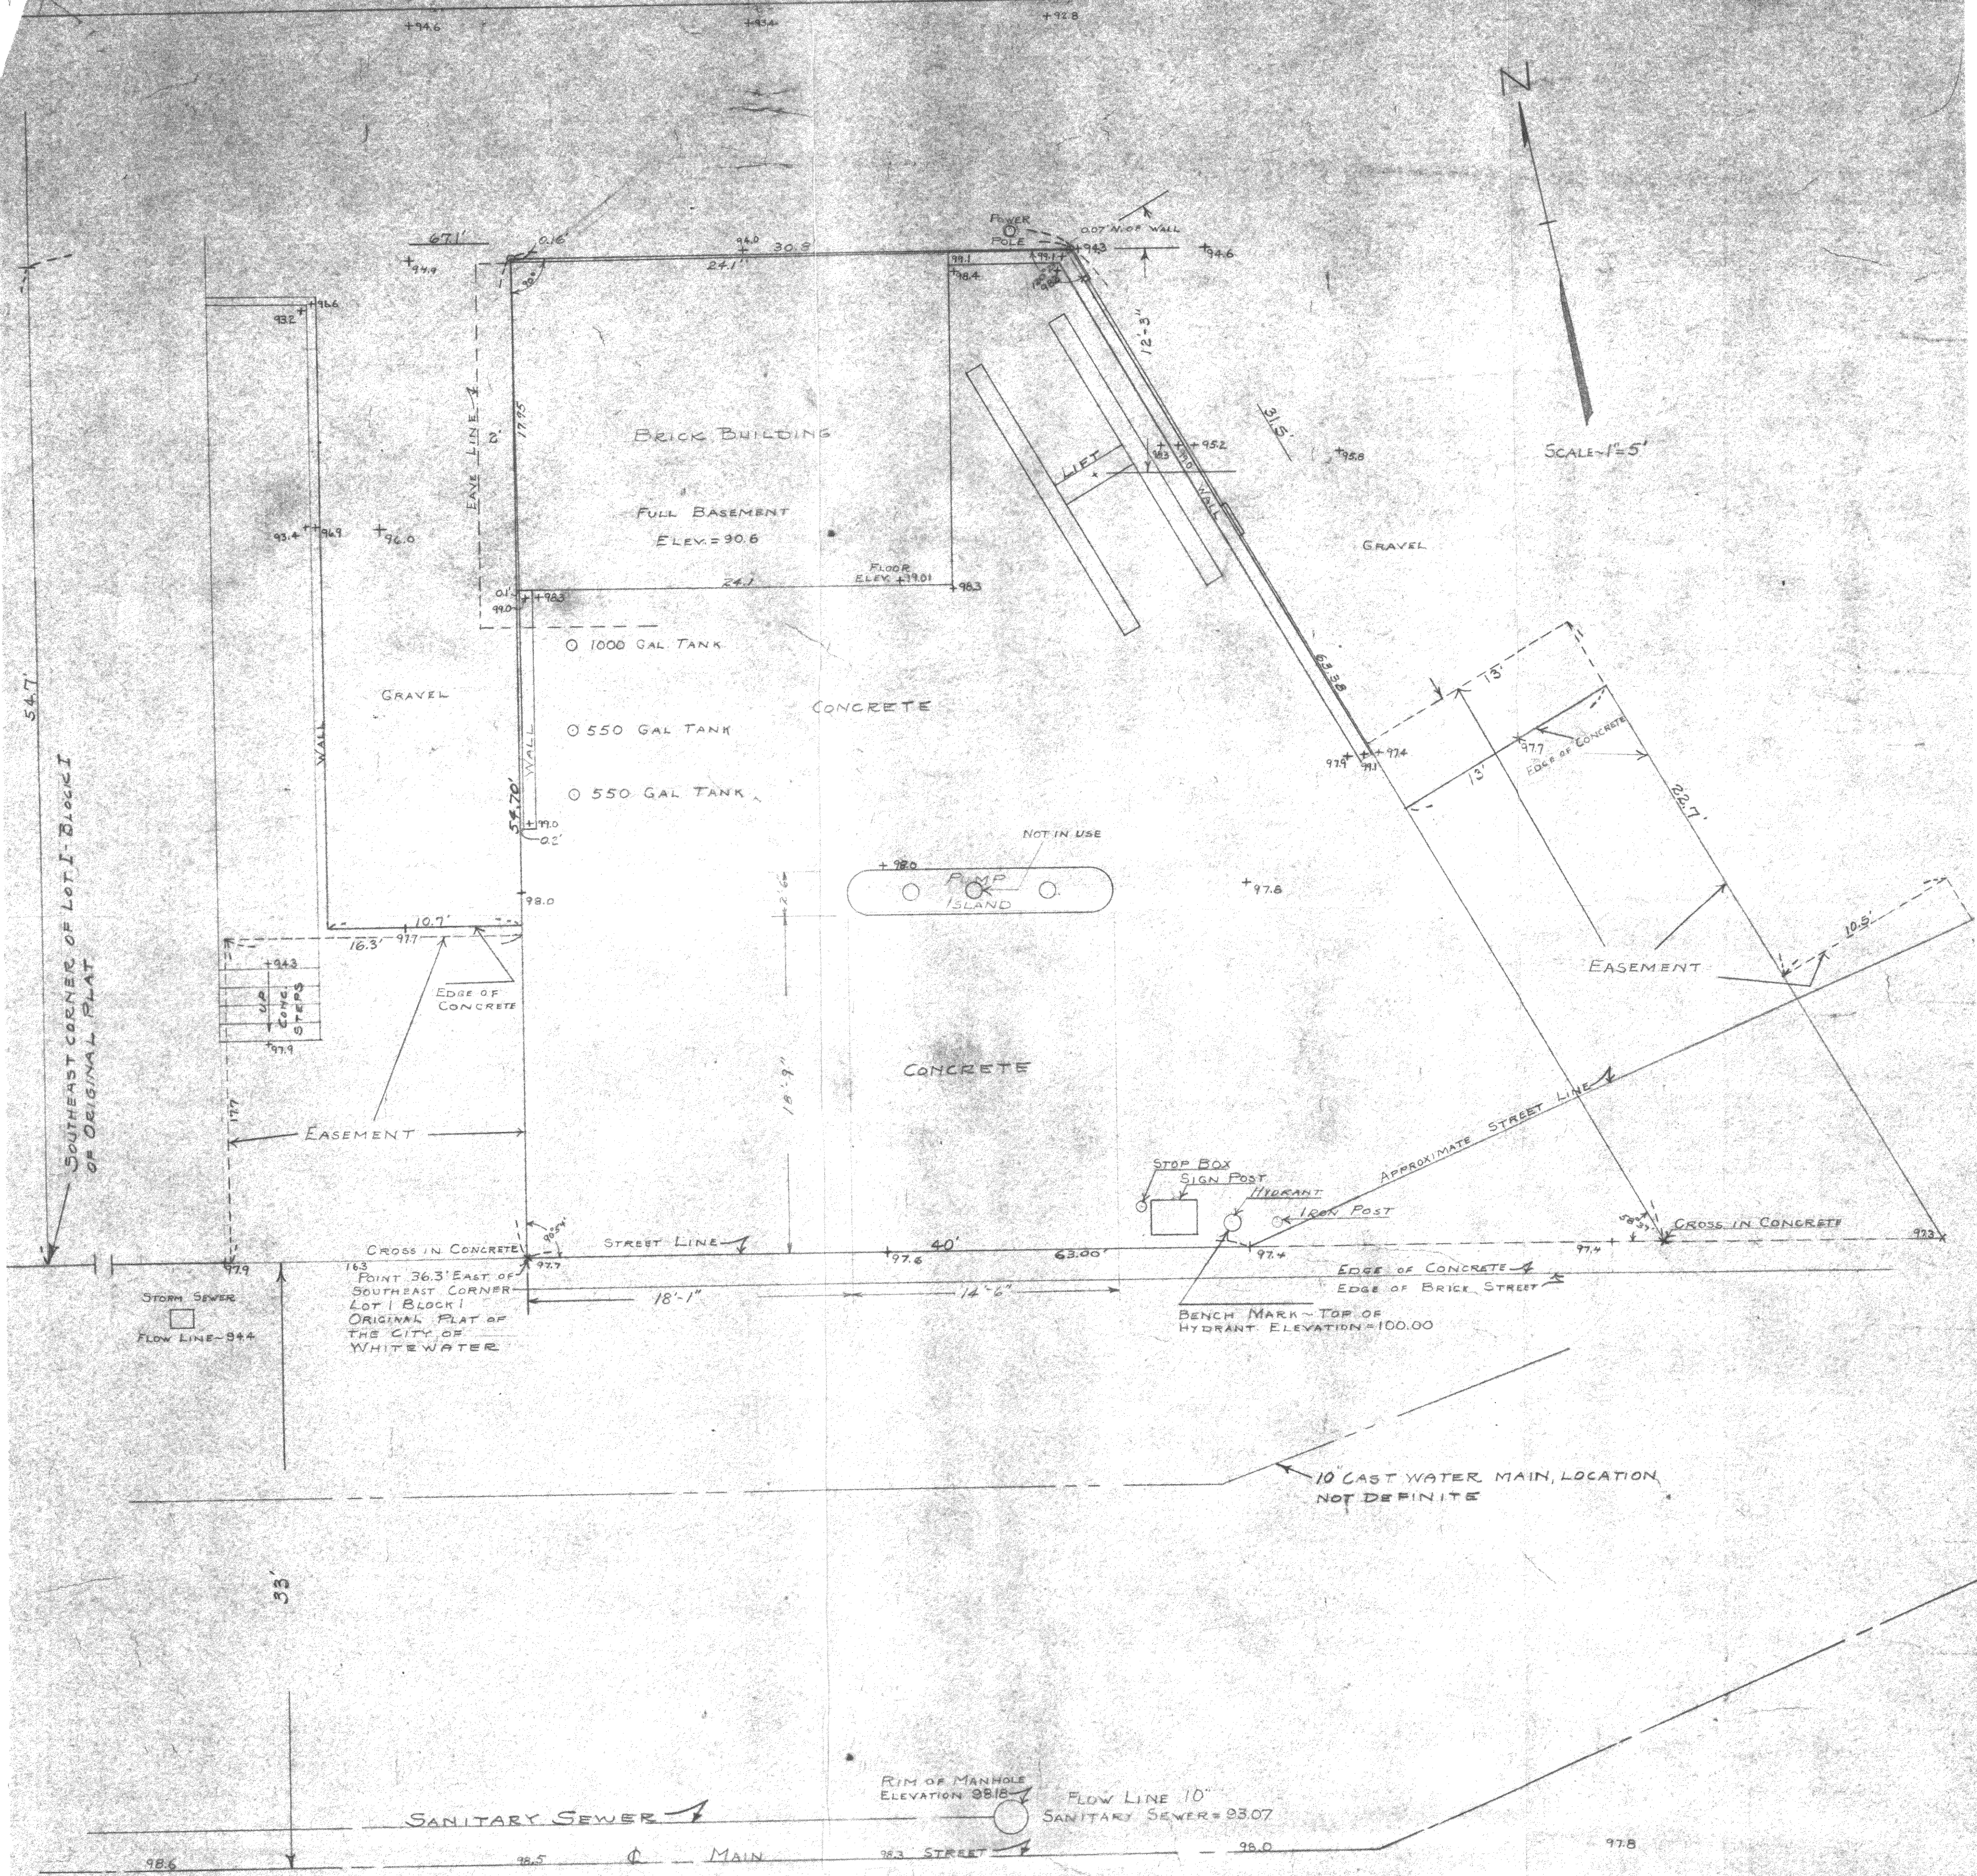

PLAT OF SURVEY OF PURE OIL COMPANY PROPERTY
 LOCATED IN THE SOUTHWEST 1/4 OF SECTION 4, T4N
 R15E, CITY OF WHITE WATER, WALWORTH COUNTY,
 WISCONSIN.

JUNE 1951
 WALWORTH COUNTY SURVEYOR

UP-256

10-75 J