


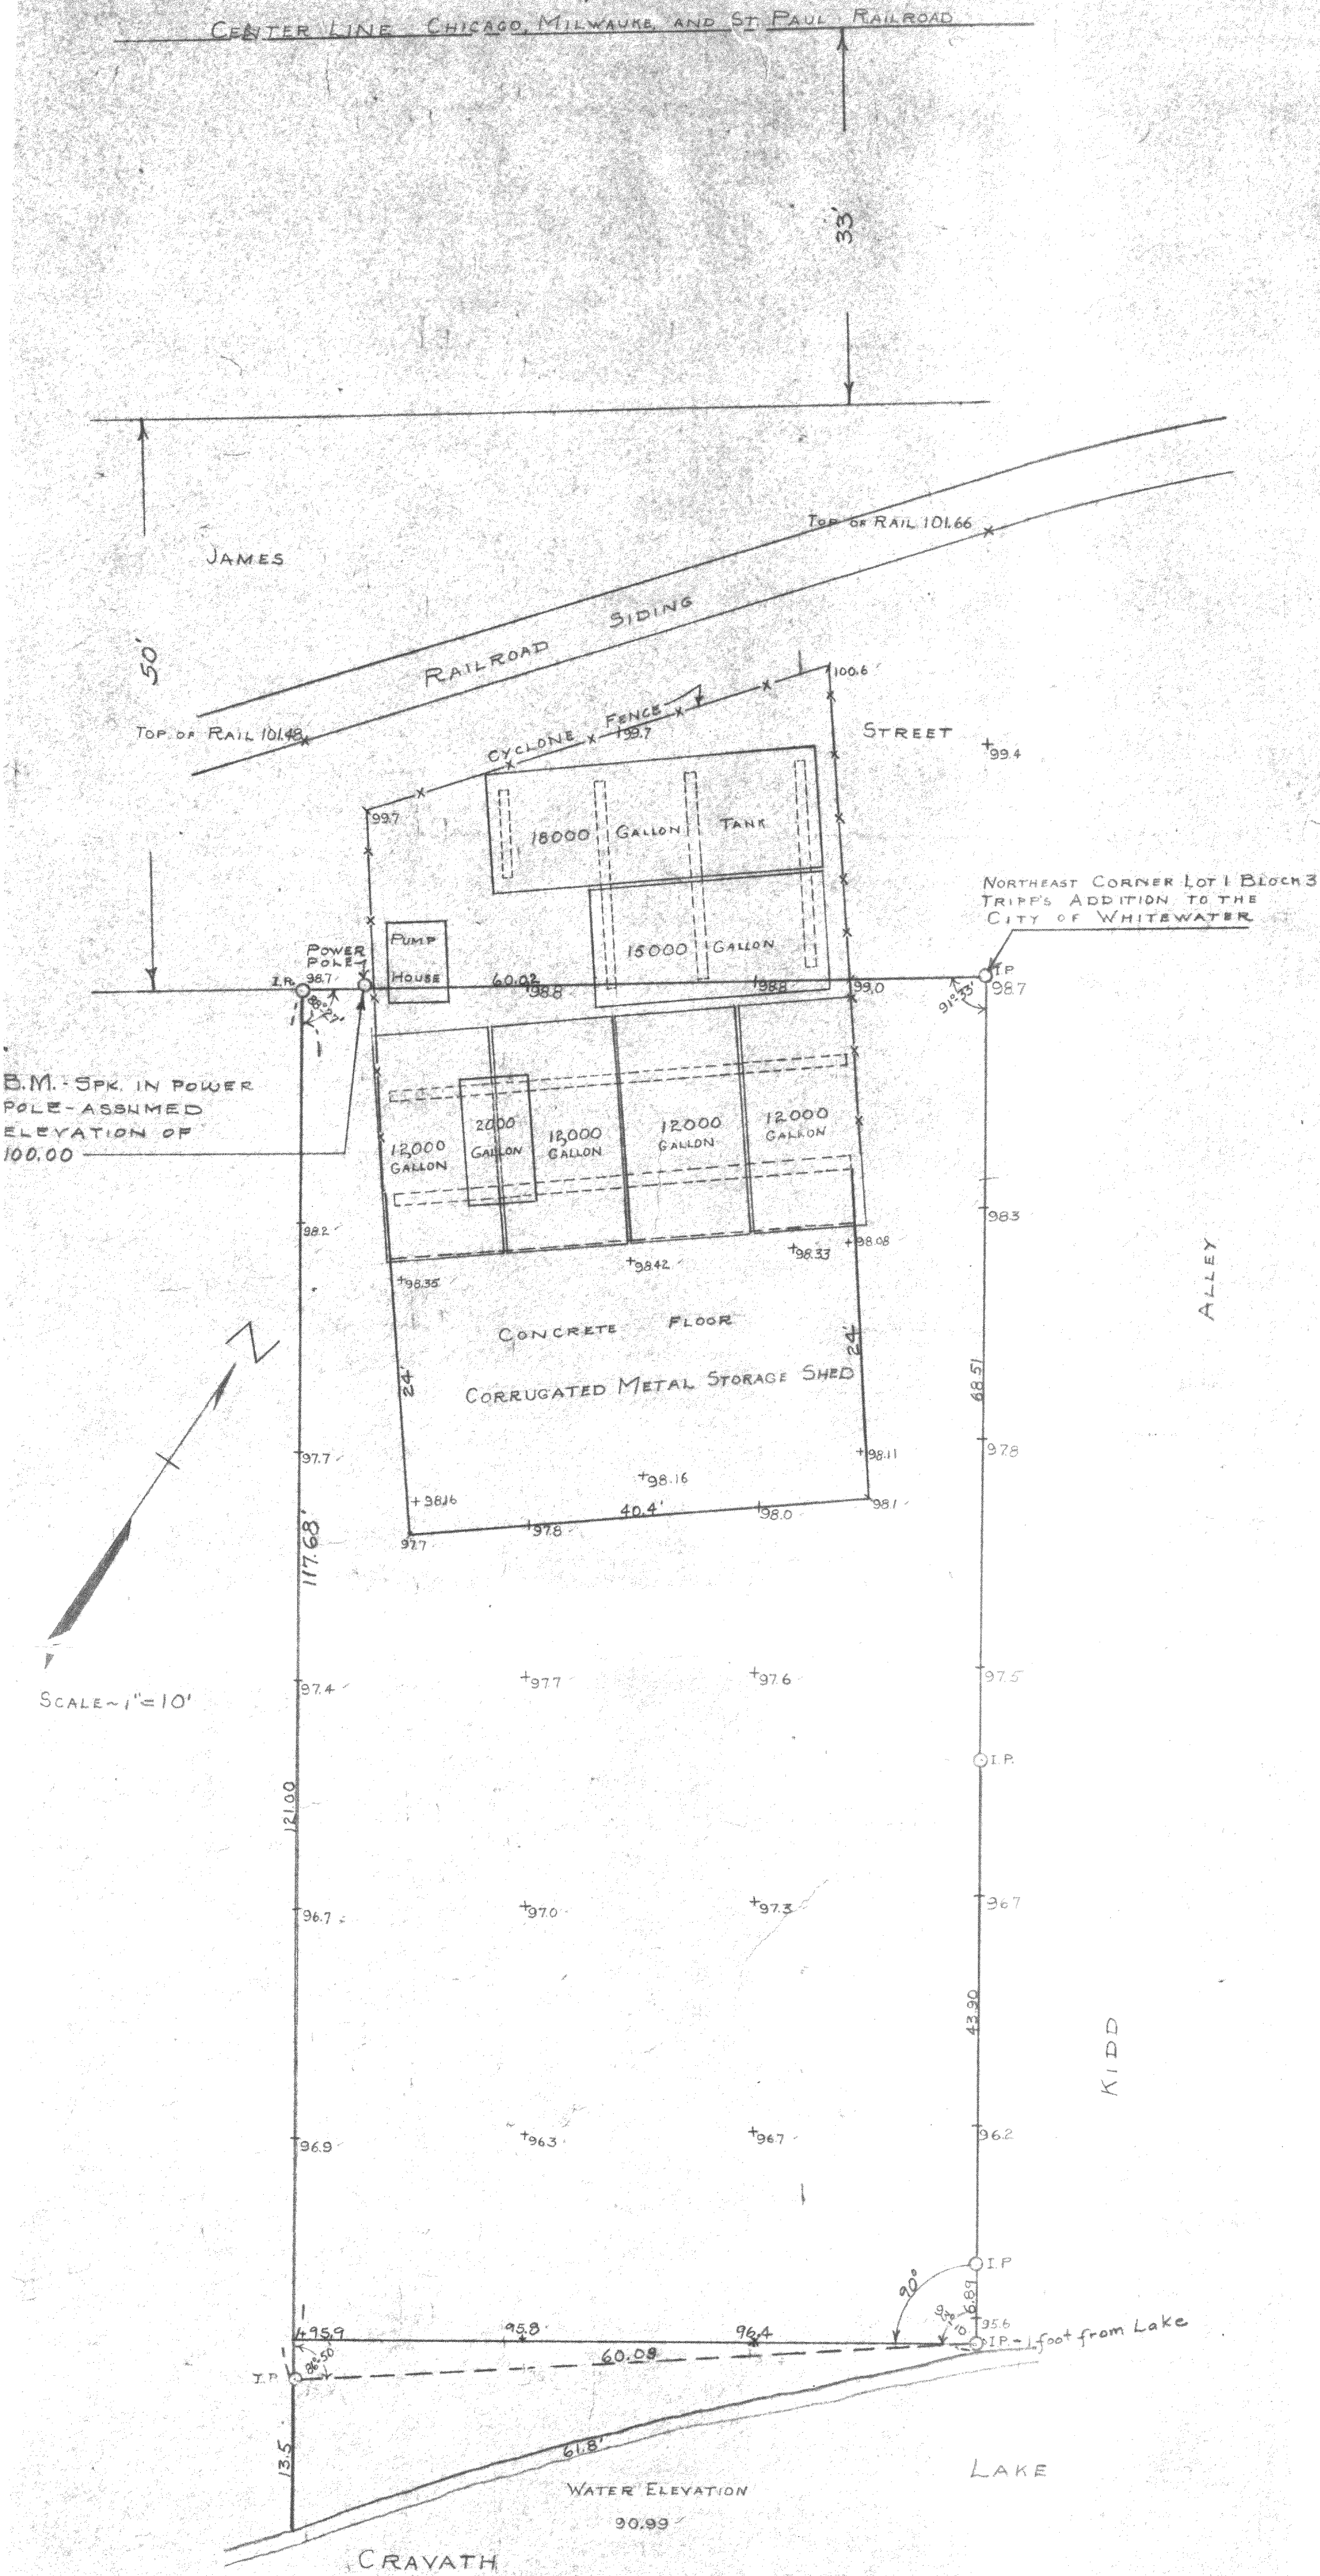

PLAT OF SURVEY OF PART OF LOT I OF BLOCK 3 OF
TRIPPS ADDITION, AND UNPLATTED LAND LOCATED
SOUTHERLY OF THAT PART OF LOT I, ALL OF THE CITY
OF WHITEWATER, WALWORTH COUNTY WISCONSIN, AS
OWNED BY THE PURE OIL COMPANY.

JUNE 1951

Lloyd L. Jensen
WALWORTH COUNTY SURVEYOR

10-76J