
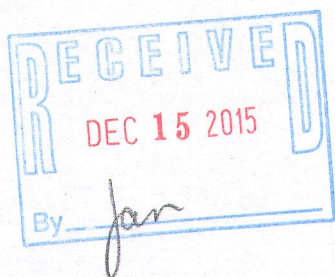
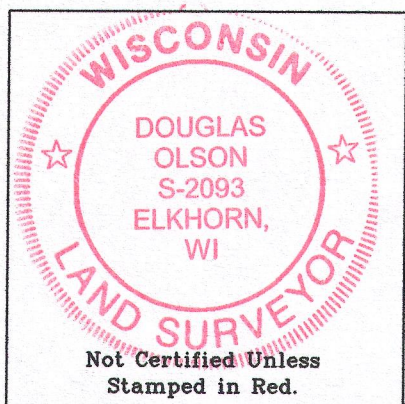


Plat of Survey

of
Lot 11 of Westpark Addition,
a subdivision located in the Southwest 1/4 of Section 5,
Town 4 North, Range 15 East, City of Whitewater, Walworth
County, Wisconsin.

Surveyed for: **Barbara Bren**
1236 West Kay Street
Whitewater, Wisconsin. 53190

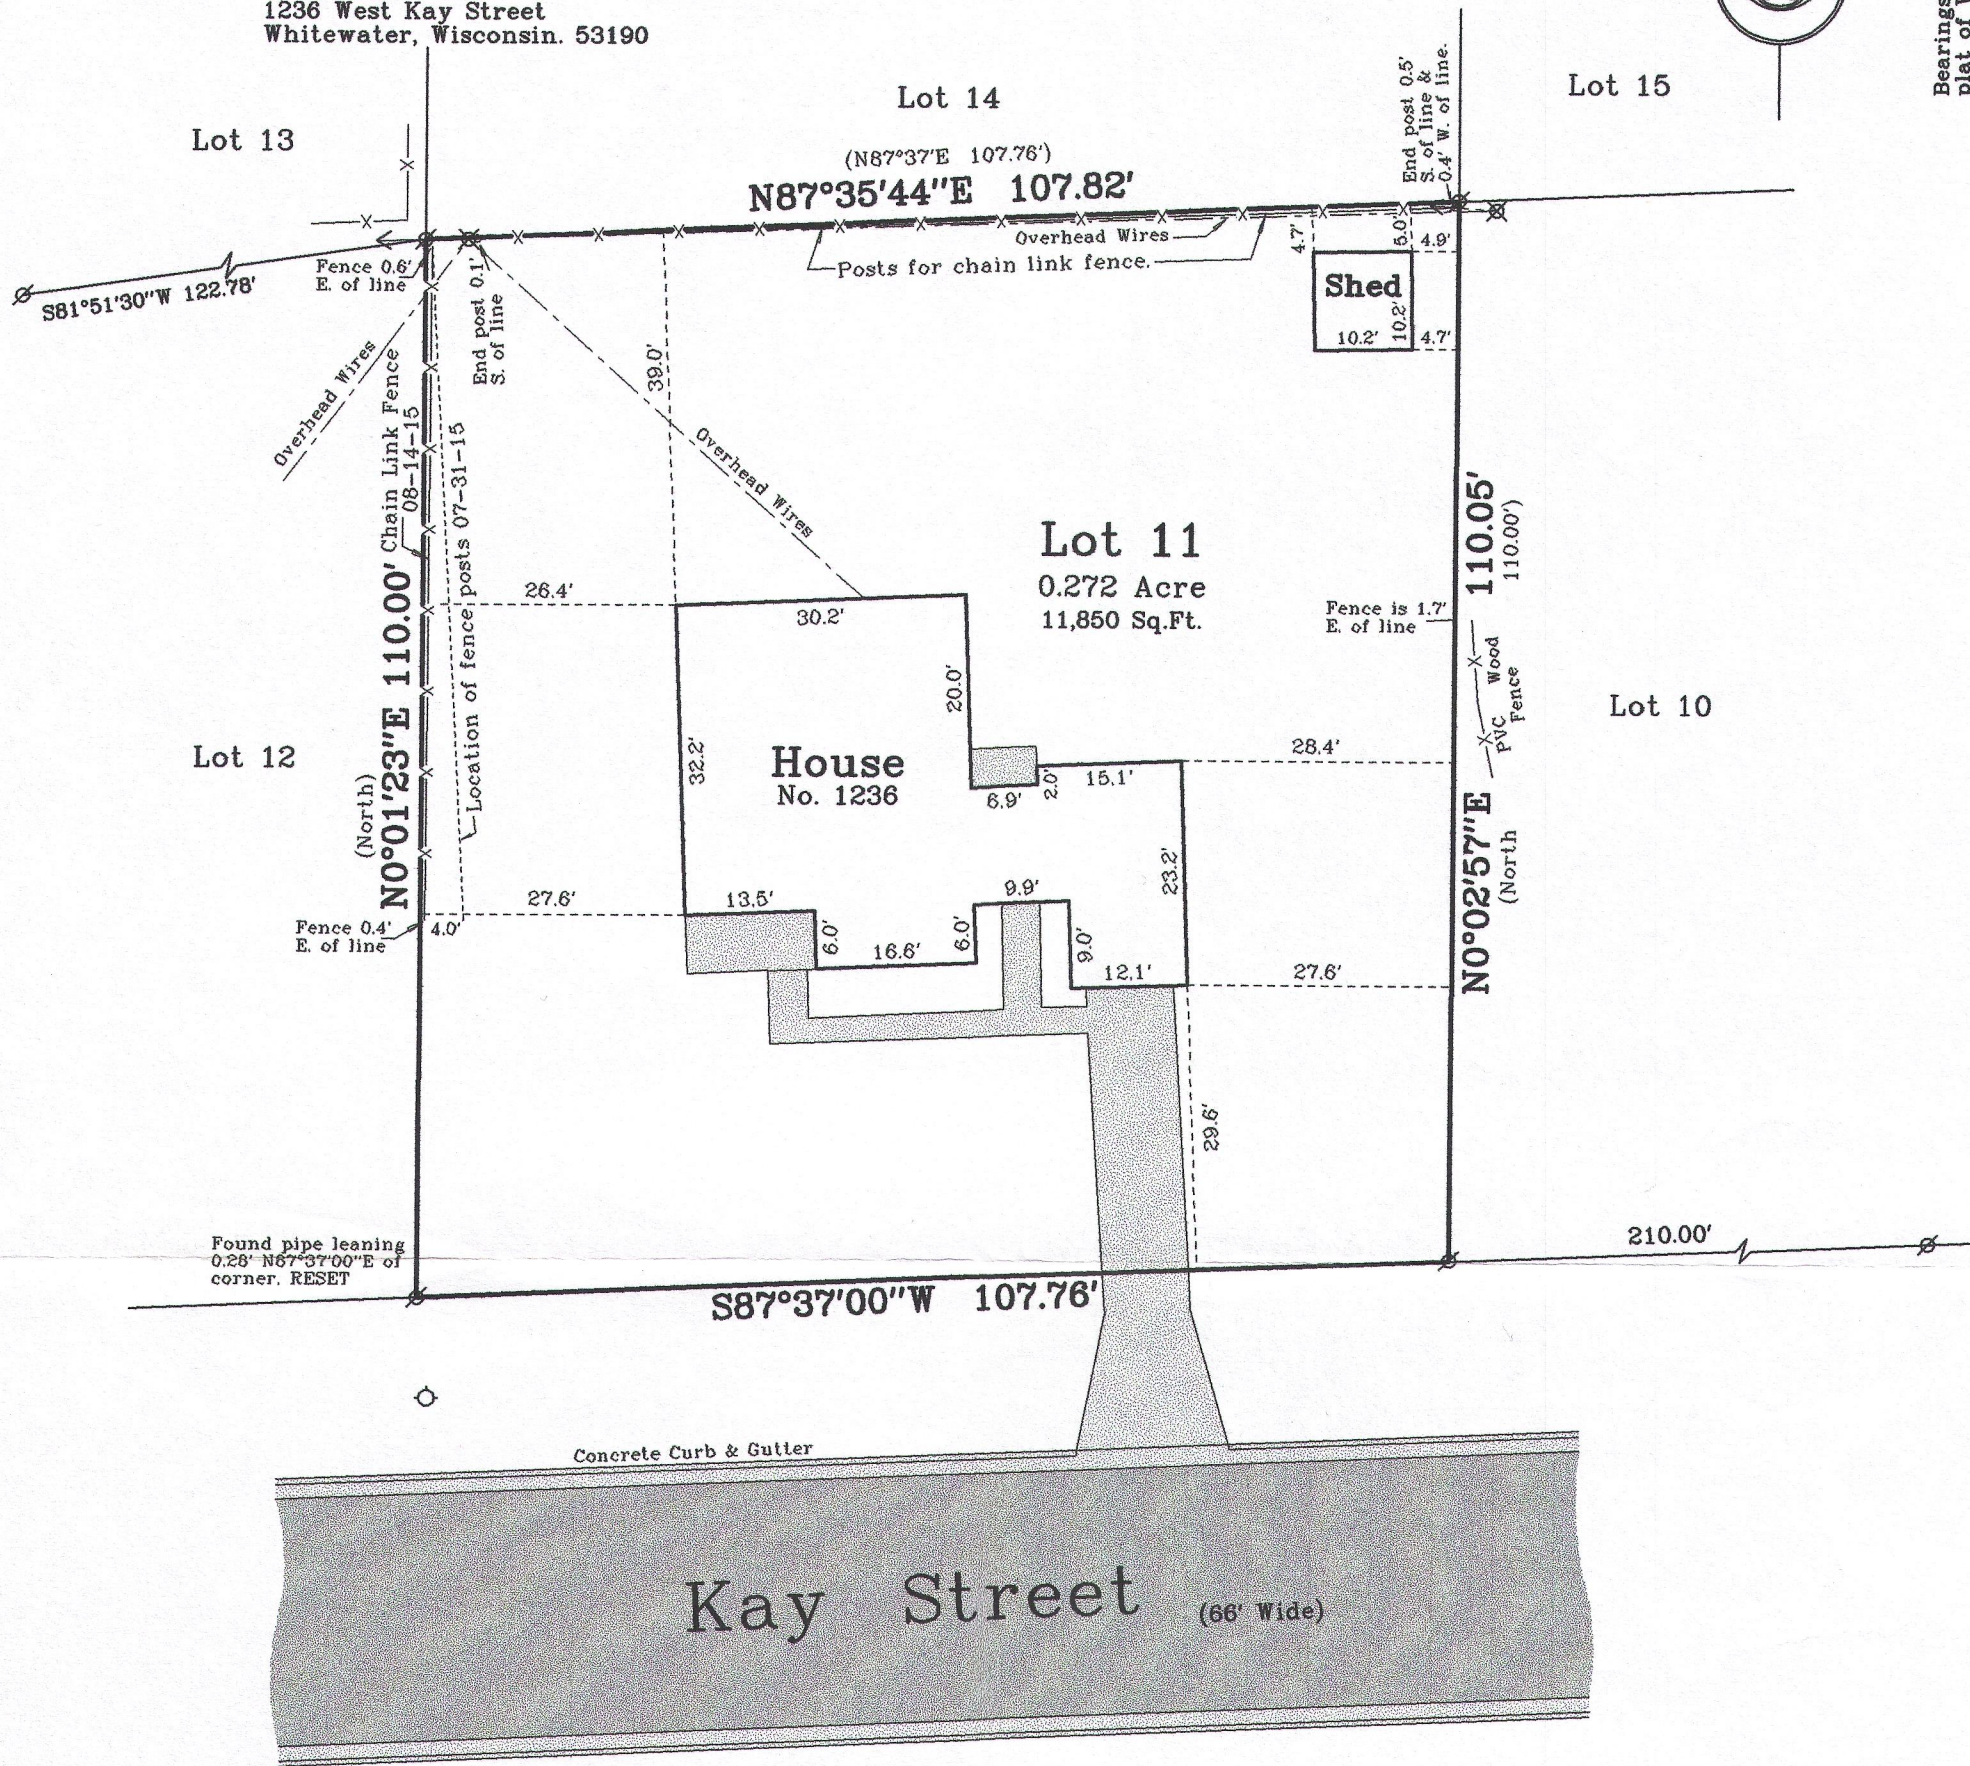

Copyright 2004 by Jensen & Olson Land Surveying, LLC.

All rights reserved. No part of this survey plat may be reproduced or transmitted in any form by any means - graphic, electronic, or mechanical, including photocopying, tracing, or information storage and retrieval systems - without permission in writing from Douglas G. Olson, Jensen & Olson Land Surveying, LLC.

I, Douglas G. Olson, Wisconsin Registered Land Surveyor, do hereby certify that this survey was performed by me or under my direction in full compliance with the owner's/agent's instructions and Chapter A-E 7 of the Wisconsin Administrative Code "Minimum Standards for Property Surveys"; and that this map is an accurate representation thereof to the best of my knowledge and belief.

DG Olson
Douglas G. Olson
Wisconsin Registered Land Surveyor - 2093

- Notes: 1) This survey plat is not certified unless signed and sealed in red ink.
2) This survey is subject to Wisconsin lien laws. This Plat of Survey is the notice of intent to file lien. Lien waiver required.

Legend

- ⊗ Found Iron Pipe
- () Recorded Information
- ⊗ Utility Pole
- Hydrant
- Asphalt Surface
- Concrete Surface

Olson Land Surveying, LLC

45 South Wisconsin Street P.O. Box 322
Elkhorn, Wisconsin. 53121
Telephone: (262) 723-3434
Facsimile: (262) 723-8044

Scale: 1" = 20'

Survey date: October 18, 2004.
Revisions: No. 1 - New Fence

Sheet 1 of 1 Sheets.

Job Reference Number:

WP-11