

LAND-MARK SURVEYING
Mark L. Miritz

N9330 Knuteson Drive
Whitewater, WI 53190
Phone: (262) 495-3284
MARKMIRITZ@
LAND-MARKSURVEYING.COM

Wisconsin Professional Land Surveyor S-2582

LEGAL DESCRIPTION



IN THE SOUTHEAST 1/4 OF THE SOUTHEAST 1/4, SECTION 6, TOWNSHIP 4 NORTH, RANGE 15 EAST, IN THE CITY OF WHITEWATER, WALWORTH COUNTY, WISCONSIN

LOTS 1 THRU 4 (INCLUSIVE) EVERGREEN PARK


PLAT OF SURVEY

WILDWOOD ROAD
(66' WIDE)

CEDAR COURT
(60' WIDE)

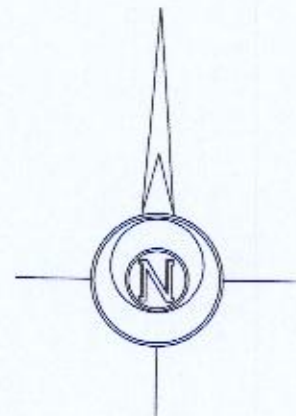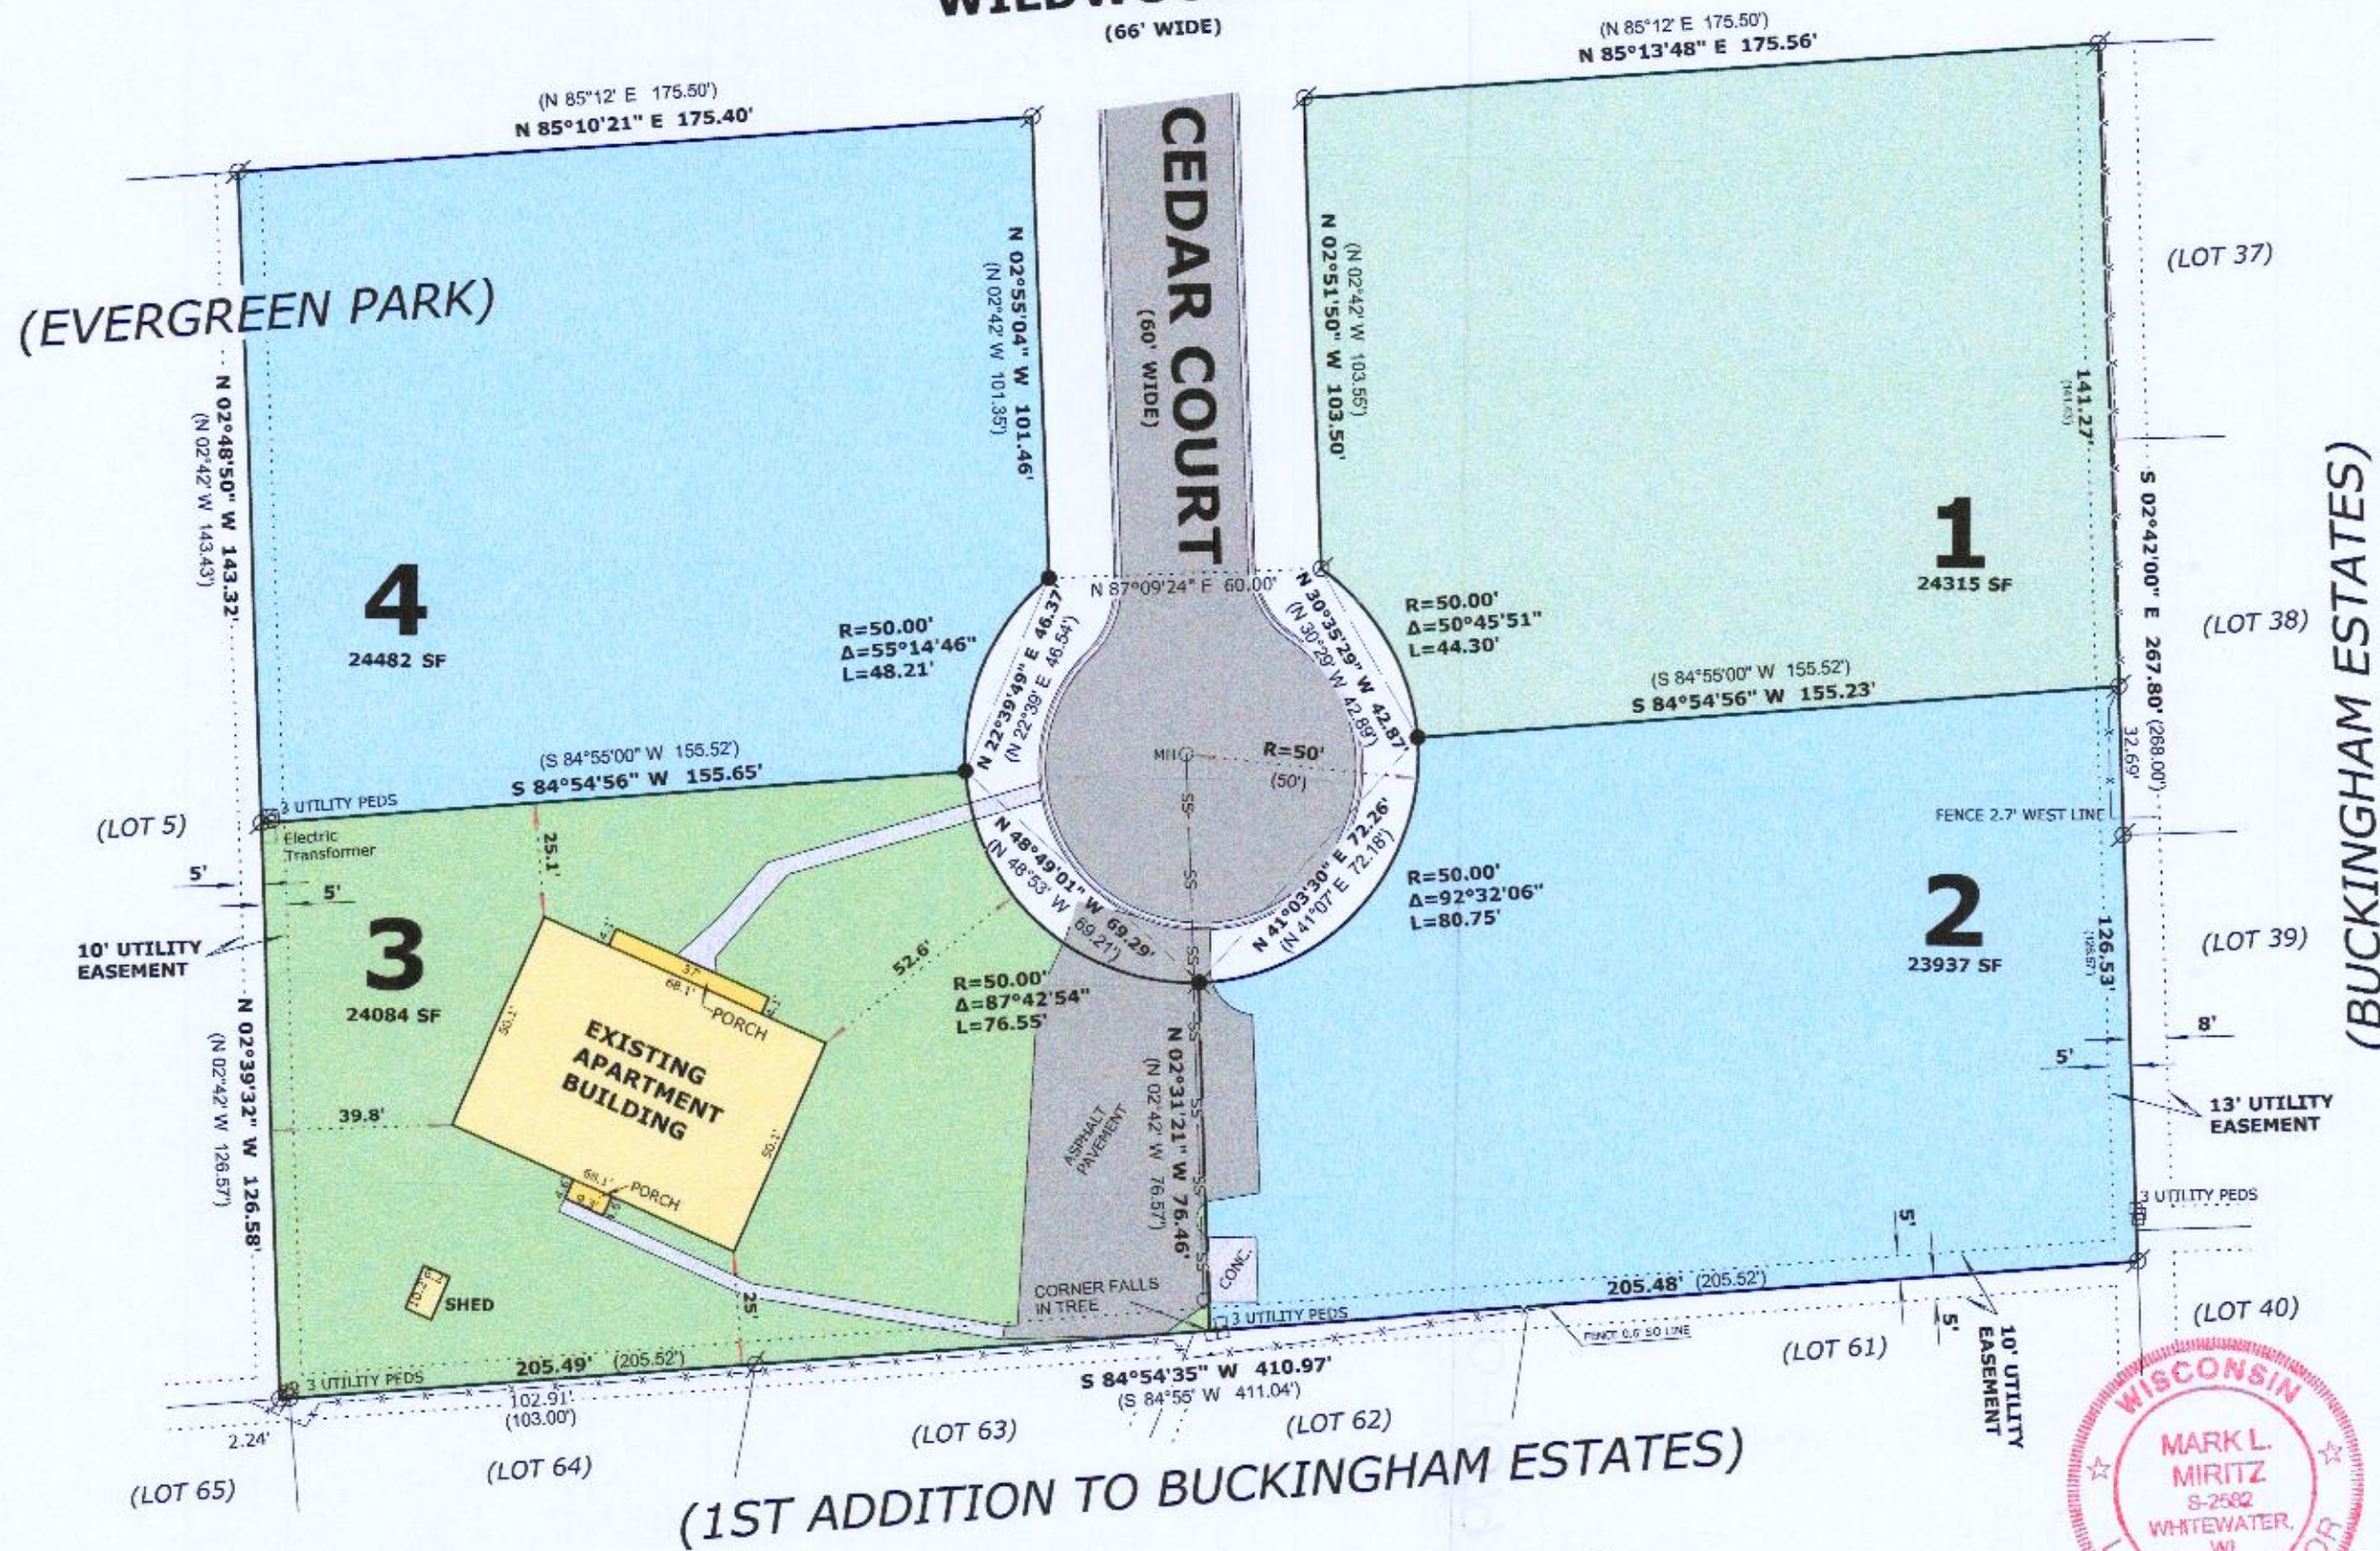

BASIS OF BEARINGS:
THE EAST LINE OF LOTS 1 & 2
BEING S 02°42'00" E

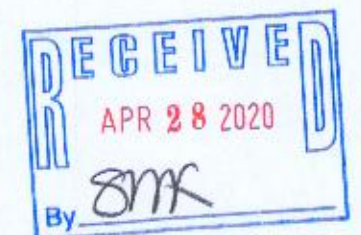

OWNER:
320 CEDAR COURT LLC
PO BOX 233
WHITEWATER, WI. 53190

LEGEND

- FOUND IRON PIPE
- SET IRON NAIL
- SET IRON ROD, 18" LONG, WEIGHING 1.5 LBS./LINEAL FT., 3/4" DIA.
- (x x) RECORDED AS DIMENSION
- X-X- EXISTING FENCE

SCALE: 1 INCH = 40 FEET

"I hereby certify that the above described property has been surveyed by me or under my direction and that the above map is a true representation thereof and shows the size and location of the property, its exterior boundaries, the location of all visible structures and dimensions of all principal buildings thereon, boundary fences, apparent easements, roadways and visible encroachments, if any."
"This survey is made for the use of the present owners of the property, and also those who purchase, mortgage, or guarantee the title thereto within one year from date hereof."



Mark L. Miritz
MARK L. MIRITZ
S-2582
WHITEWATER, WI
WISCONSIN PROFESSIONAL
LAND SURVEYOR S-2582

DATE: February 26, 2020 JOB NO. 18.204

(1ST ADDITION TO BUCKINGHAM ESTATES)

010-1079

1EV-1 1EV-2 1EV-3 1EV-4