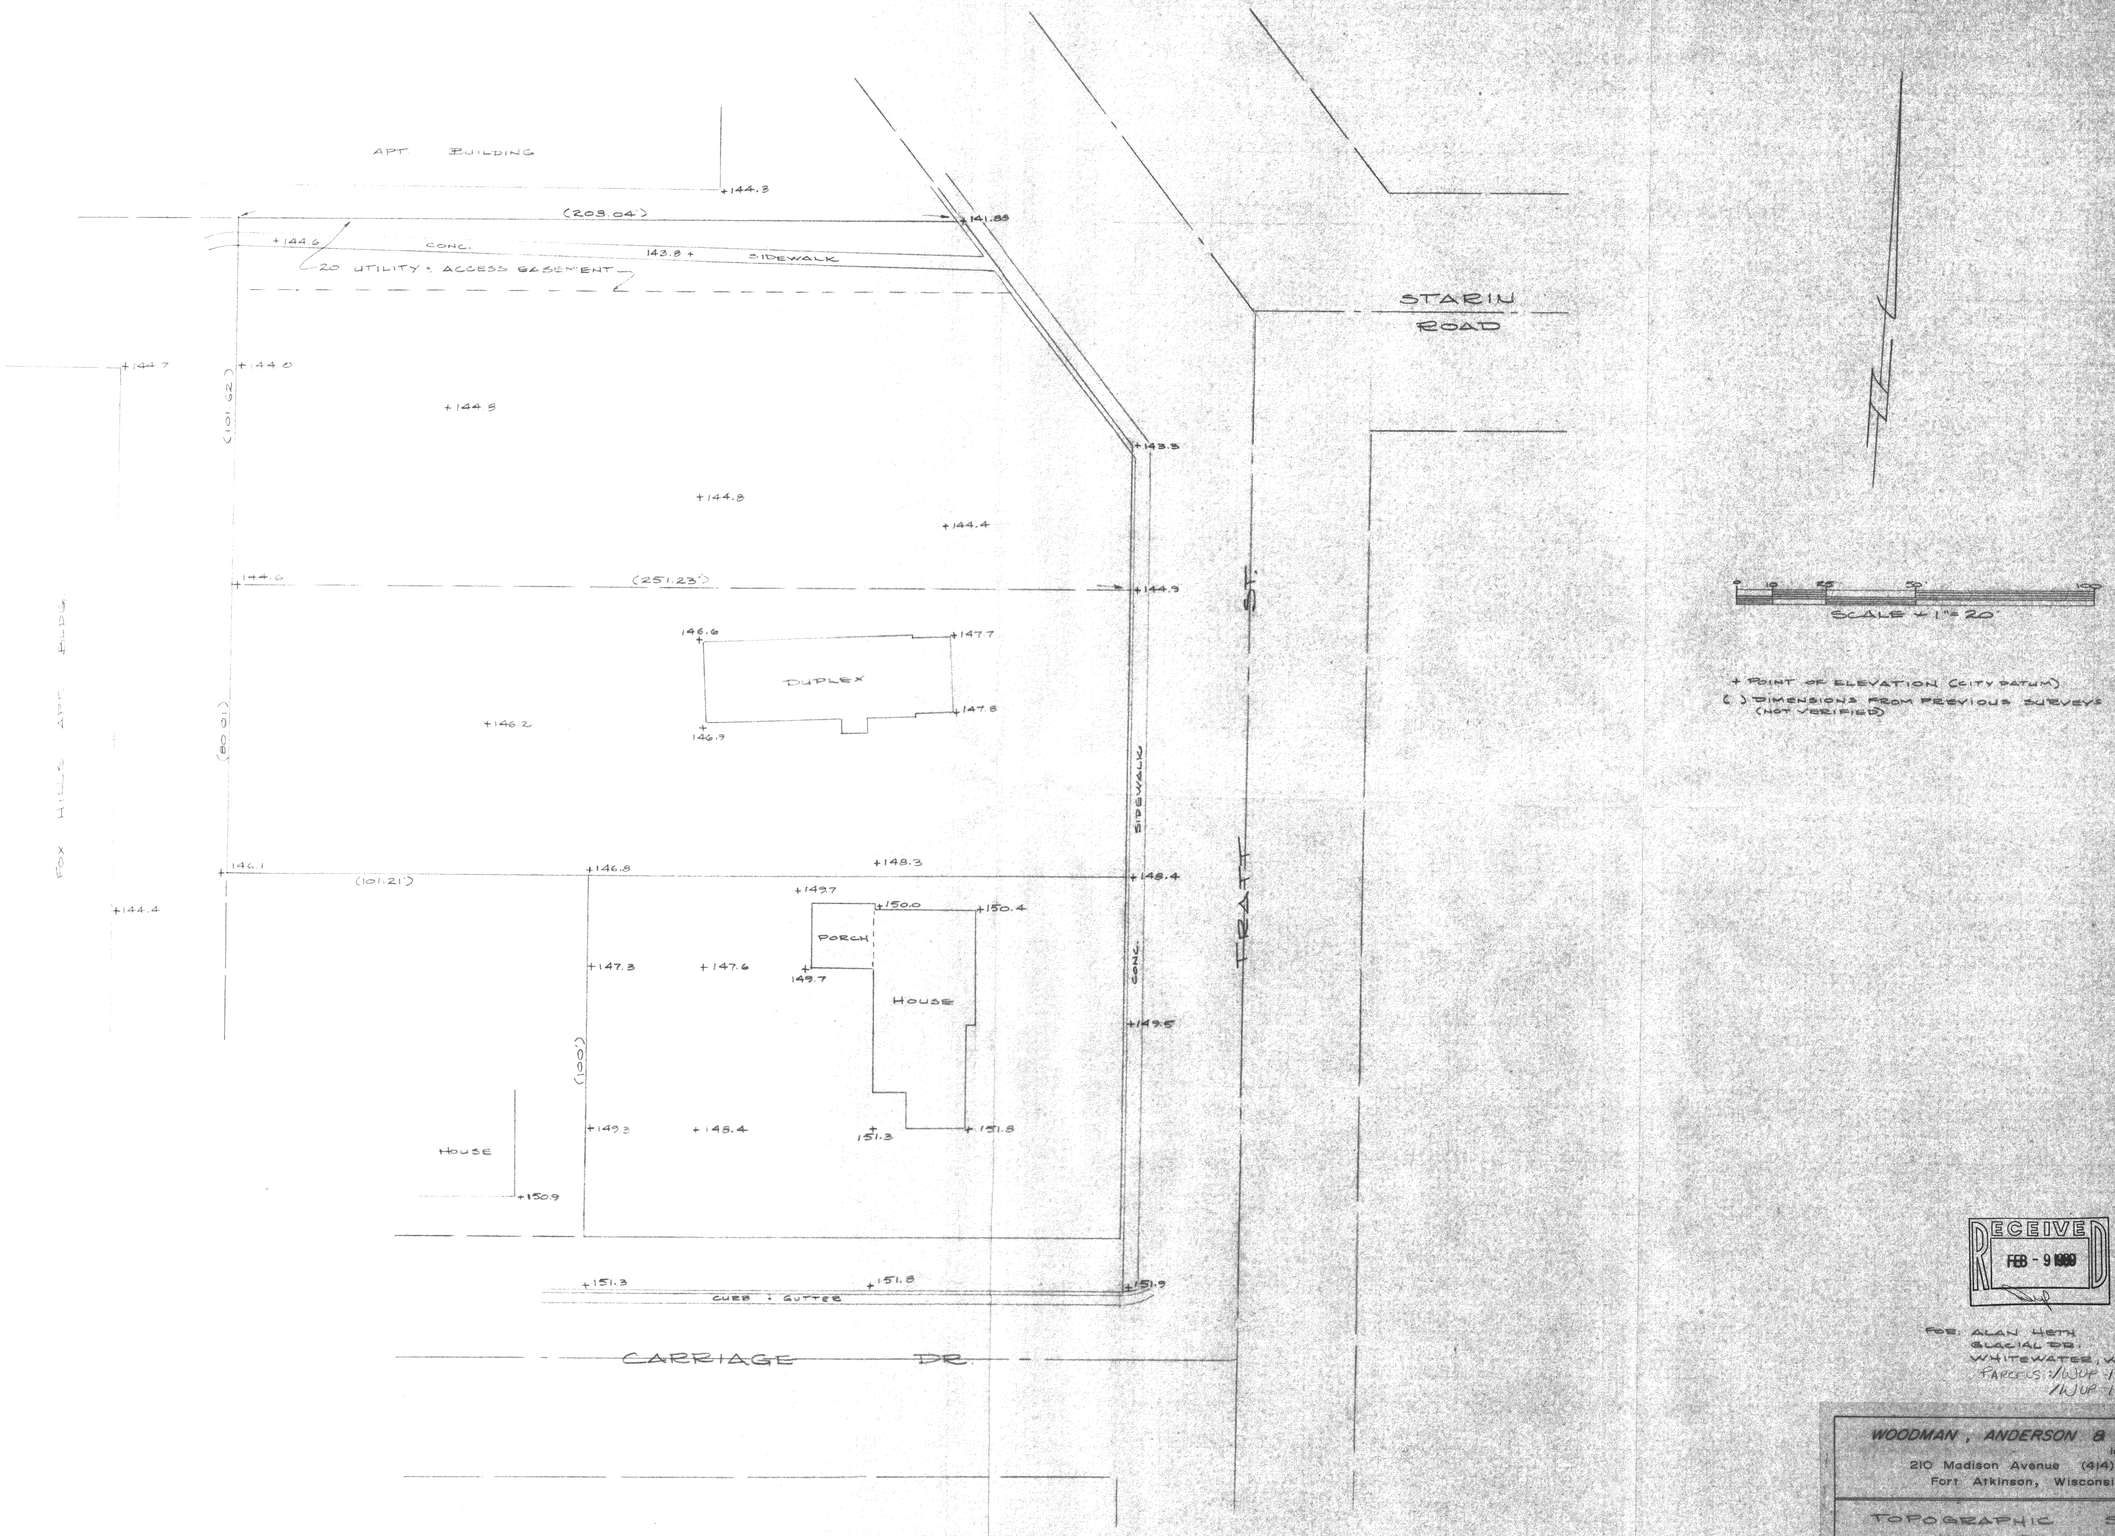

RECEIVED
FEB - 9 1989

FOR: ALAN HETH
GLACIAL DR.
WHITEWATER, WI
PARCELS: 1/WUP-156A
1/WUP-156B

10-419

WOODMAN, ANDERSON & ASSOCIATES
land surveyors
210 Madison Avenue (414) 563-8162
Fort Atkinson, Wisconsin 53538

TOPOGRAPHIC SURVEY
HETH PROPERTY
PART OF SECTION 5, T4N R15E, CITY OF WHITEWATER, WALWORTH CO., WI

		DATE		DATE		
DSN.			REV.		SCALE	1" = 20'
DRN.	JW-MA	1-19-89	REV.		JOB NO.	885-108
APPR.	JBW	1-20-89	REV.		SHEET	1 OF 1