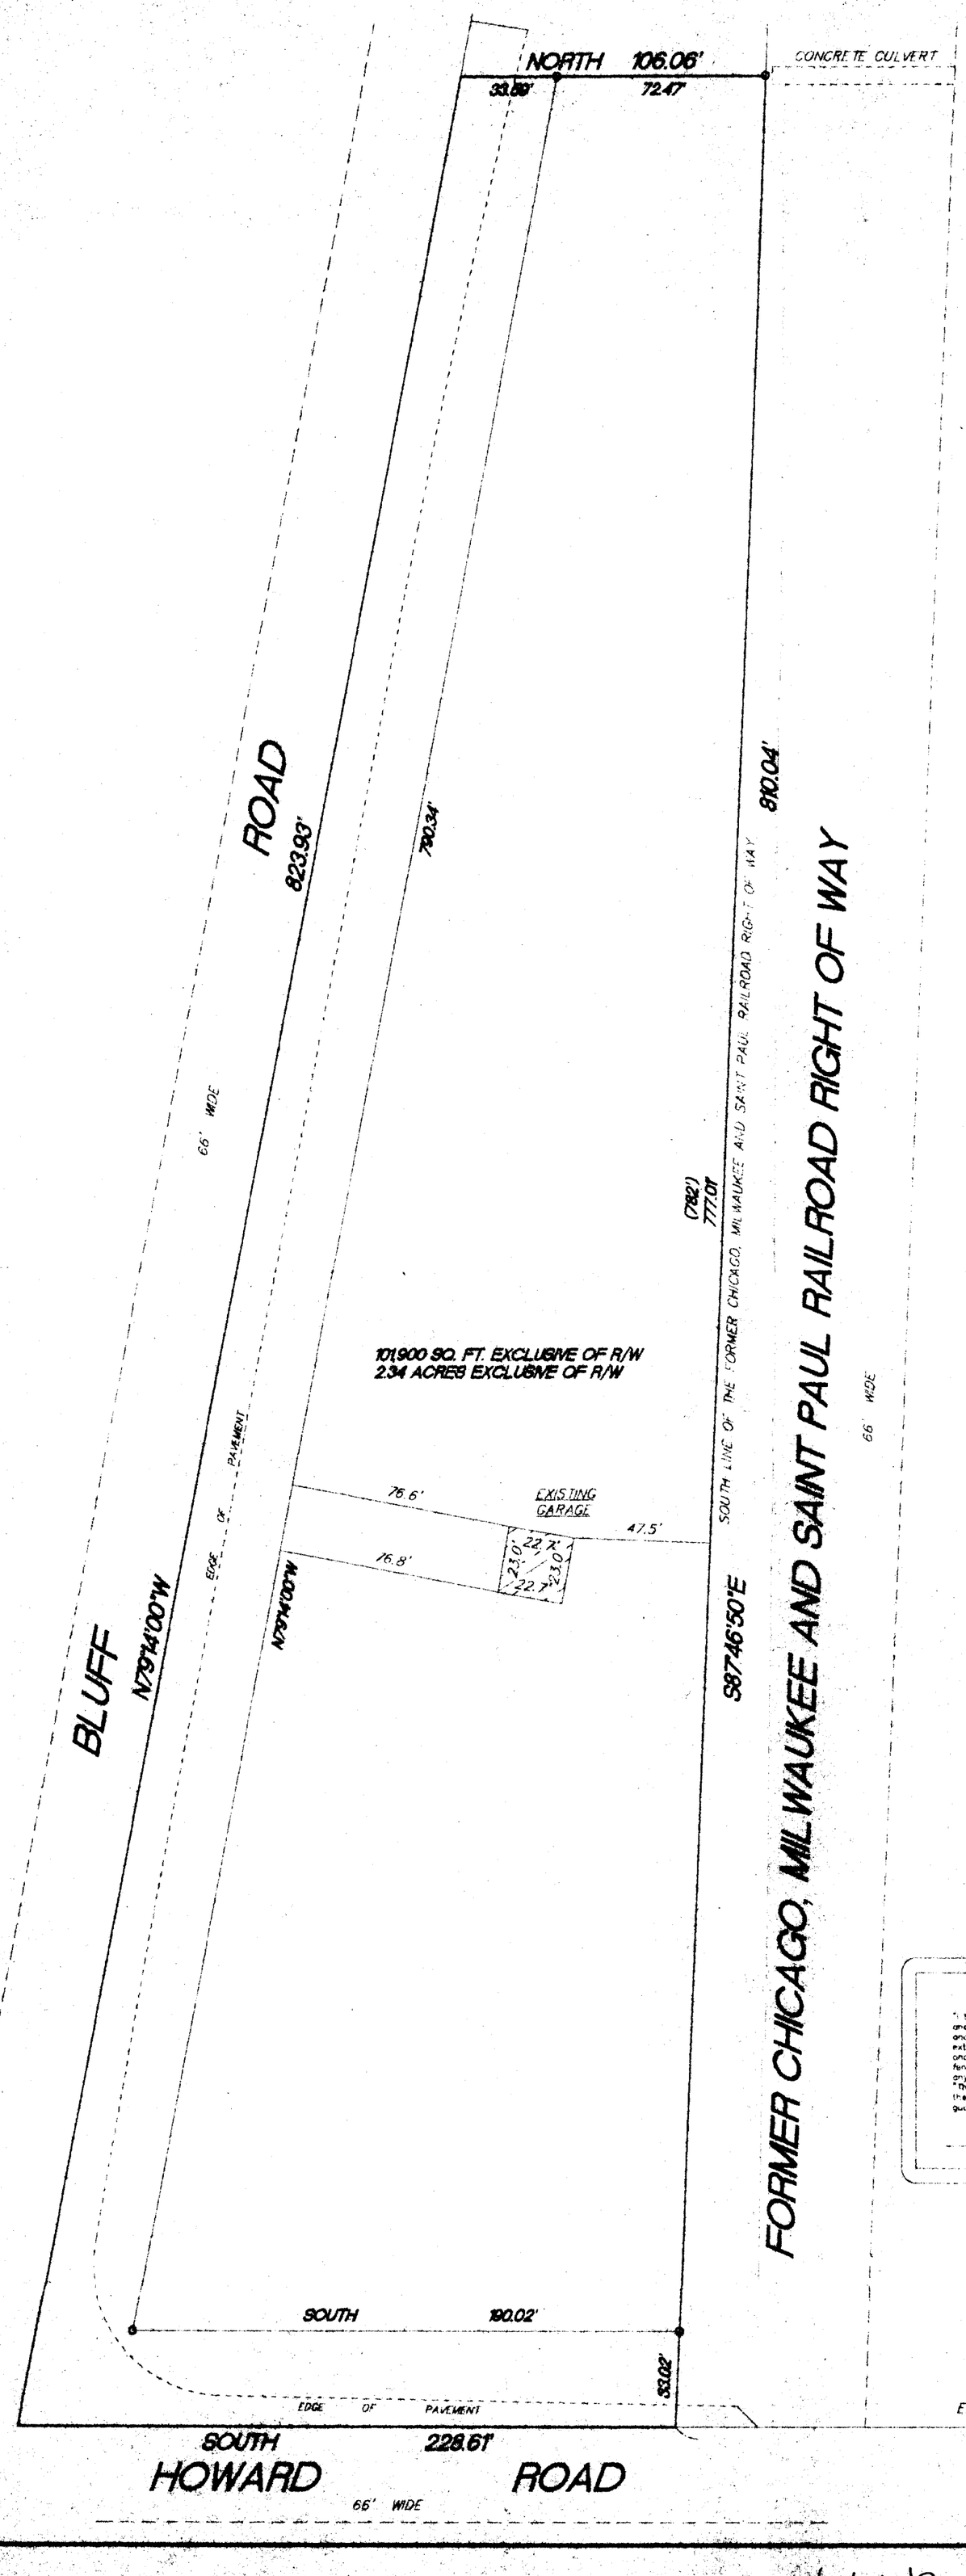


## PLAT OF SURVEY

A PARCEL OF LAND LOCATED IN THE SOUTHEAST 1/4 OF SECTION 3, TOWN 4 NORTH, RANGE 15 EAST, TOWN OF WHITEWATER, WALWORTH COUNTY, WISCONSIN, DESCRIBED AS FOLLOWS, TO-WIT: BEGINNING AT THE INTERSECTION OF THE SOUTH LINE OF THE CHICAGO, MILWAUKEE AND SAINT PAUL RAILROAD RIGHT OF WAY AND THE EAST LINE OF SAID SOUTHEAST 1/4; THENCE WEST IN SAID SOUTH LINE, 782 FEET MORE OR LESS TO A CONCRETE CULVERT; THENCE SOUTH TO THE CENTER LINE OF THE HIGHWAY; THENCE SOUTHEASTERLY IN SAID HIGHWAY TO THE EAST SECTION LINE OF SAID SOUTHEAST 1/4; THENCE NORTH ON SAID EAST LINE TO THE PLACE OF BEGINNING.

SURVEYED FOR: TINCHER REALTY

- FOUND COUNTY MON.
- o SET 1" IRON PIPE
- ( ) RECORDED AS

SCALE 1"=40'

RECEIVED
OCT 15 1998

WISCONSIN
TERRANCE E. PISAREK
S-1930
EAGLE, WISCONSIN
LAND SURVEYOR

"I hereby certify that I have surveyed the above property and that the above map is a true representation thereof and shows the size and location of the property exterior boundaries, the location of all visible structures and dimensions of all principal buildings thereon, boundary fences, apparent easements, roadways and encroachments if any."
"This survey is made for the use of the present owners of the property, and also those who purchase, mortgage or guarantee the title thereto within one year from date hereof."

KETTLE MORAINE SURVEYING
W362 S10227 Lewin Lane
Eagle WI. 53119
(414)594-3484

THIS IS NOT AN ORIGINAL SURVEY UNLESS THE SEAL IS RED.

| 8/24/98 | TEP/PG | TEP | 98188 |
|---|---|---|---|
| DATE | FIELD WORK BY | DRAWN BY | JOB NUMBER |

010-648 /WUP-334