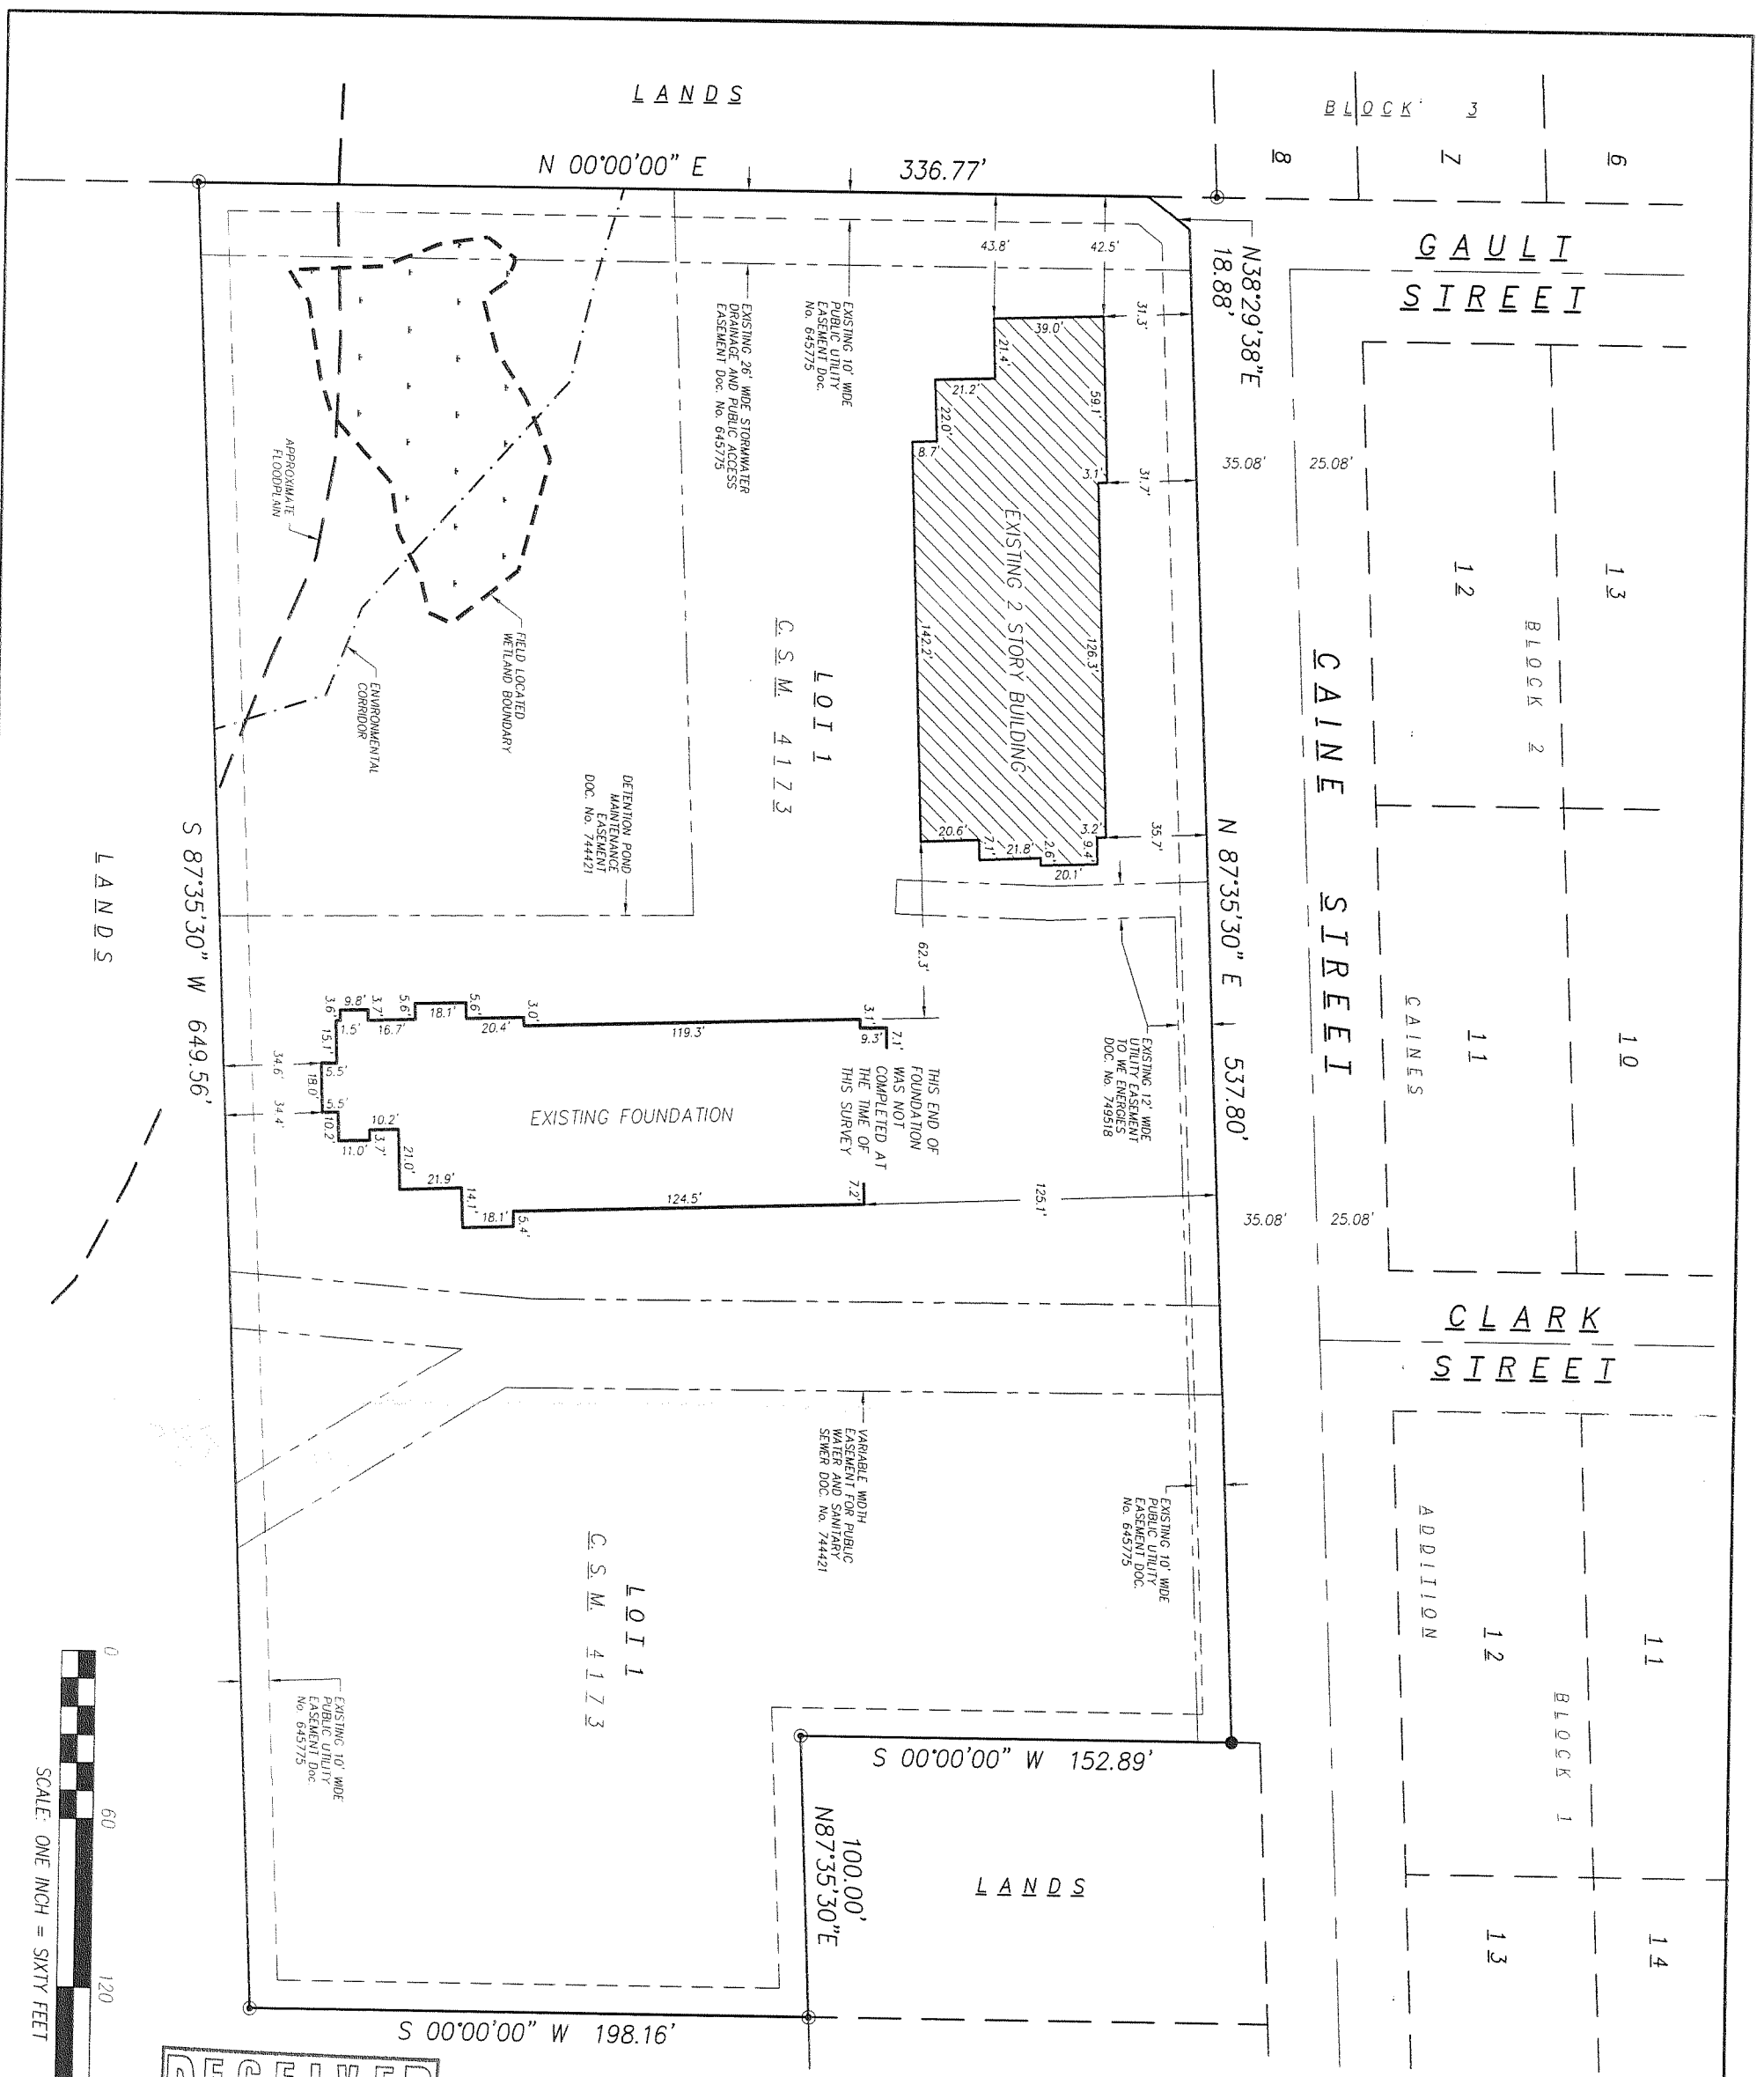

RECEIVED
JUL 27 2009
By SHF

NORTH

BEARINGS ARE BASED UPON C.S.M. No. 4173

LEGEND

⊙ 1" IRON PIPE FOUND

● 1-1/4" SOLID IRON ROD FOUND

DISTANCES ARE MEASURED TO THE NEAREST HUNDREDTH OF A FOOT.

SURVEYOR'S CERTIFICATE

I, Michael J. Ziehr, professional land surveyor, hereby certify to the present owner of the property and also those who purchase, mortgage, or guarantee the title thereto within one year from the date hereon, that the foregoing survey was executed under my direction and control and that the lot mapped hereon is according to the description furnished and that to the best of my knowledge and belief, the map hereon is a correct representation of the exterior boundaries of said lot and of existing buildings. This survey is for mortgage purposes only, to be used by the present owners and/or their assigns.

Dated this 15TH day of MAY, 2009.

Signed: Michael J. Ziehr
Michael J. Ziehr, P.L.S. 2401

WISCONSIN
MICHAEL J. ZIEHR
S-2401
McFARLAND WIS.
LAND SURVEYOR

Calkins Engineering, LLC
Civil Engineers & Land Surveyors

Date of Field Survey: May 12, 2009

Note: The location of parking lots, driveways, sidewalks, utilities and other improvements are not determined by this survey. This map is solely to represent the location of the buildings.

DRAWING NAME: P:\PROJECTS\C\GIL01\dwg\csm\Foundation Survey\GIL01-survey.dwg

SURVEYED FOR:
Gil-Her Ltd.
115 King Street
Sun Prairie, WI 53590

SURVEYED BY:
Calkins Engineering, LLC
5010 Voges Road
Madison, WI 53718
(608) 838-0444
www.calkinsengineering.com

FOUNDATION SURVEY

LOT 1, CERTIFIED SURVEY MAP NUMBER 4173 AS RECORDED IN VOLUME 26 OF CERTIFIED SURVEY MAPS, ON PAGES 205-208, AS DOCUMENT NUMBER 744421, WALWORTH COUNTY REGISTRY AND LOCATED IN THE NORTHEAST QUARTER OF THE NORTHEAST QUARTER OF SECTION 8, TOWNSHIP 4 NORTH, RANGE 15 EAST, CITY OF WHITEWATER, WALWORTH COUNTY, WISCONSIN.

FN: GIL01
DATE: 05-13-09

REVISIONS:
05-15-2009

SHEET 1 OF 1

IA4173-1

10-885