



Plat of Survey

of


Lot 5 in Block 6 of Waters Edge South,

a subdivision located in the Northeast 1/4 of Section 9, Town 4 North,
Range 15 East, City of Whitewater, Walworth County, Wisconsin.

Surveyed for: **Tincher Realty, Inc.**
532 West Main Street
Whitewater, Wisconsin. 53190

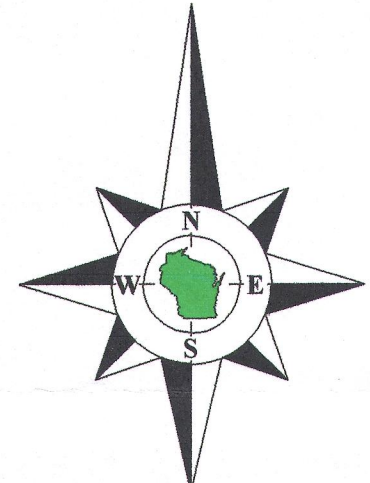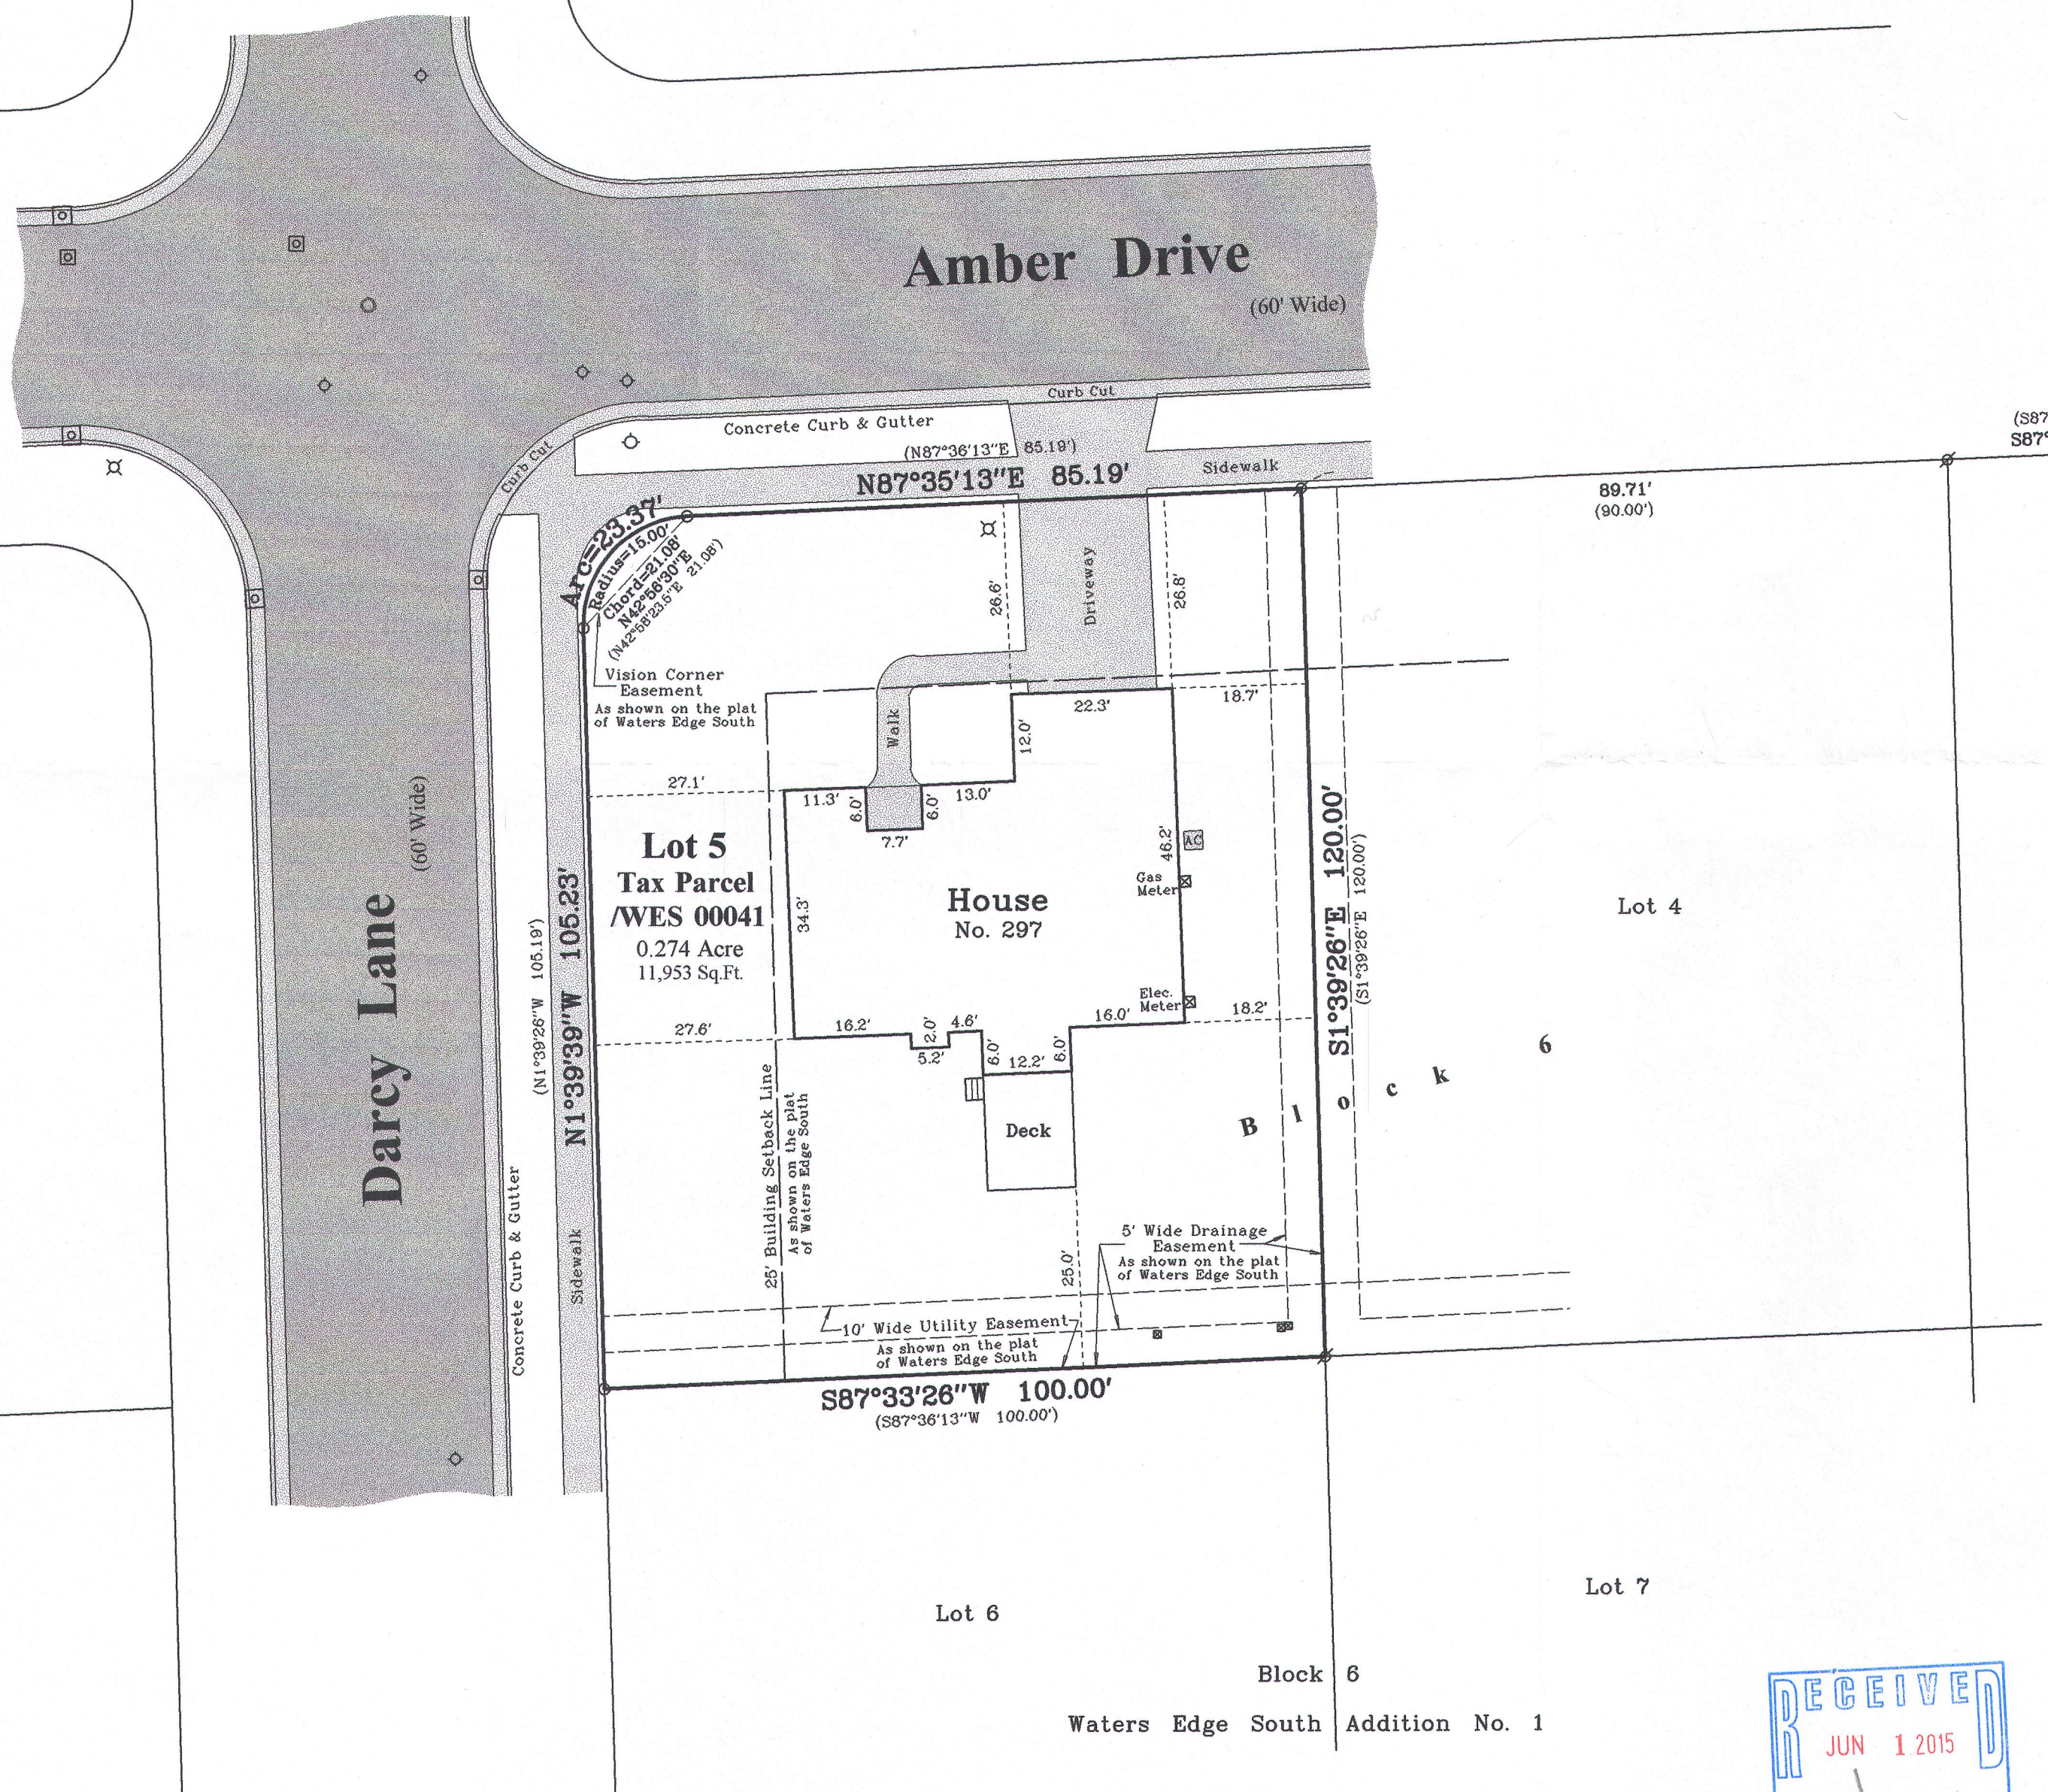

Bearings reference to the
plat of Waters Edge South.

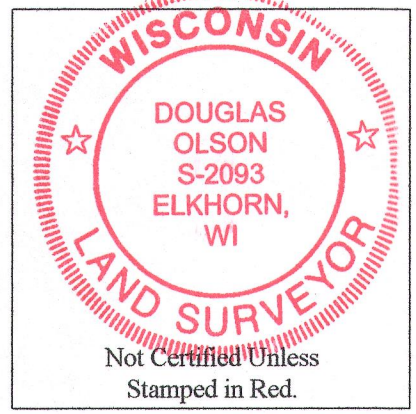

Notes:


- 1) This survey plat is not certified unless signed and sealed in red ink.
- 2) This survey is subject to Wisconsin lien laws. This Plat of Survey is the notice of intent to file lien. Lien waiver required.

Copyright 2015 by Olson Land Surveying, LLC.


All rights reserved. No part of this survey plat may be reproduced or transmitted in any form by any means - graphic, electronic, or mechanical, including photocopying, tracing, or information storage and retrieval systems - without permission in writing from Douglas G. Olson, Olson Land Surveying, LLC.

I hereby certify that I have surveyed the above described property and the map hereon is correct to the best of my professional knowledge and belief and shows the size and location of the property, its exterior boundaries, the location and dimensions of all visible structures thereon, boundary fences, apparent easements and roadways and visible encroachments, if any.
This survey is made for the exclusive use of the present owners of the property, and also those who purchase, mortgage or guarantee title thereto, within one year from the date hereof.

Douglas G. Olson
Wisconsin Professional Land Surveyor - 2093

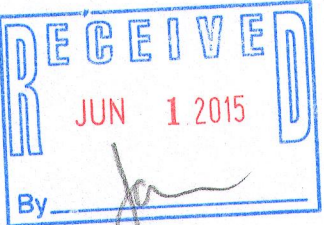

Survey Date: March 20, 2015.
Revisions:

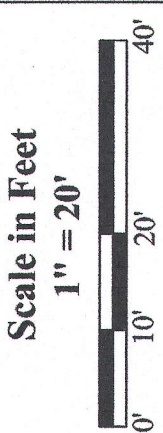

Olson Land Surveying, LLC

45 South Wisconsin Street * P.O. Box 322 * Elkhorn, Wisconsin. 53121
Telephone: (262) 723-3434 * Facsimile: (262) 723-8044
Email: doug@olsonsurveying.com



Legend

- Found Iron Pipe, 2" dia.
- Found Iron Pipe, 1" dia.
- Recorded Information
- ⊗ Light Pole or Lamp
- ⊗ Utility Pedestal
- ⊗ Fire Hydrant
- ⊗ Water Valve
- ⊗ Manhole
- ⊗ Catch Basin
- ⊗ Asphalt Surface
- ⊗ Concrete

Sheet 1 of 1 Sheets	Job Reference Number
Drawing Name:	2015.017

2015.017

WE8-41

010-968