


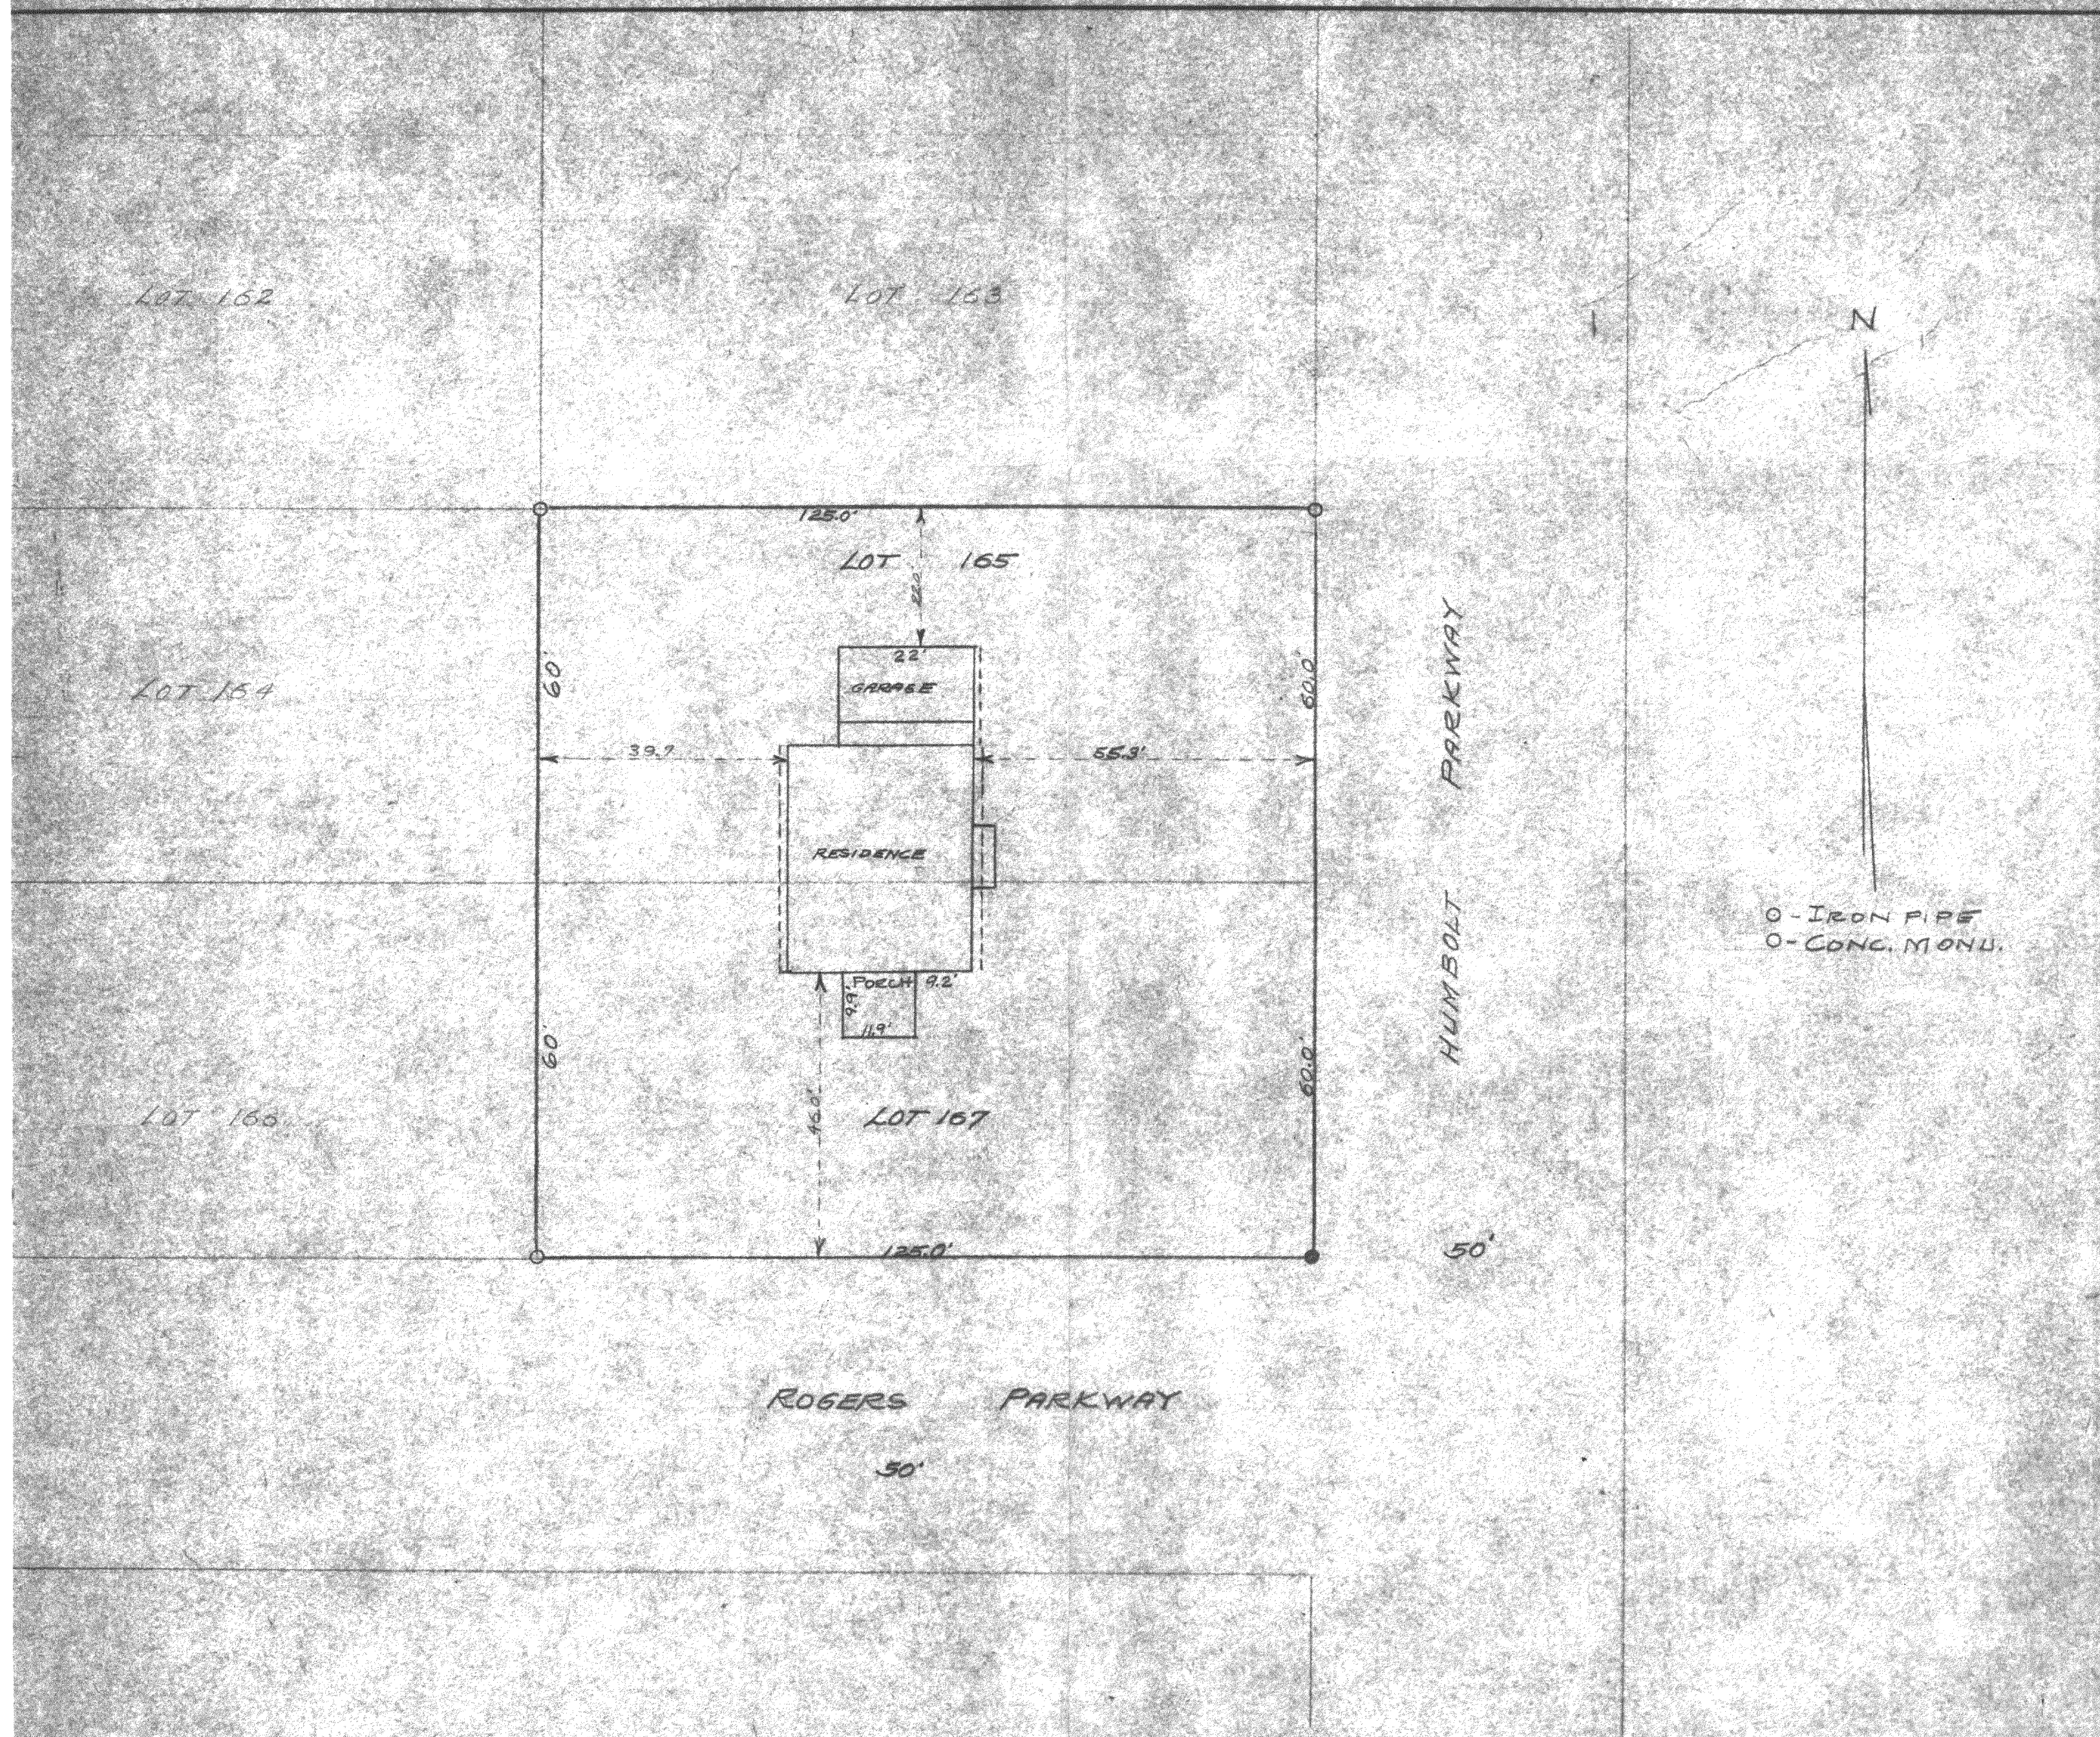

STATE OF WISCONSIN
COUNTY OF WALWORTH

I, LLOYD L. JENSEN, DO HEREBY CERTIFY THAT I
HAVE SURVEYED THE PROPERTY SHOWN HEREON
ACCORDING TO THE OFFICIAL RECORDS, AND THAT THE
PLAT HEREON IS A CORRECT REPRESENTATION OF
THE LOT LINES AND PRINCIPAL LINES OF BUILDINGS
THEREON.

JUNE 2, 1956

Lloyd L. Jensen
SURVEYOR

PLAT OF SURVEY OF

LOTS 165 AND 167 OF THE ORIGINAL
PLAT OF CEDAR POINT PARK
SUBDIVISION, WILLIAMS BAY,
WISCONSIN.

Lloyd L. Jensen
SURVEYOR

SCALE 1" = 20'

DATE JUNE 2, 1956

WER 138, 140

11-156