



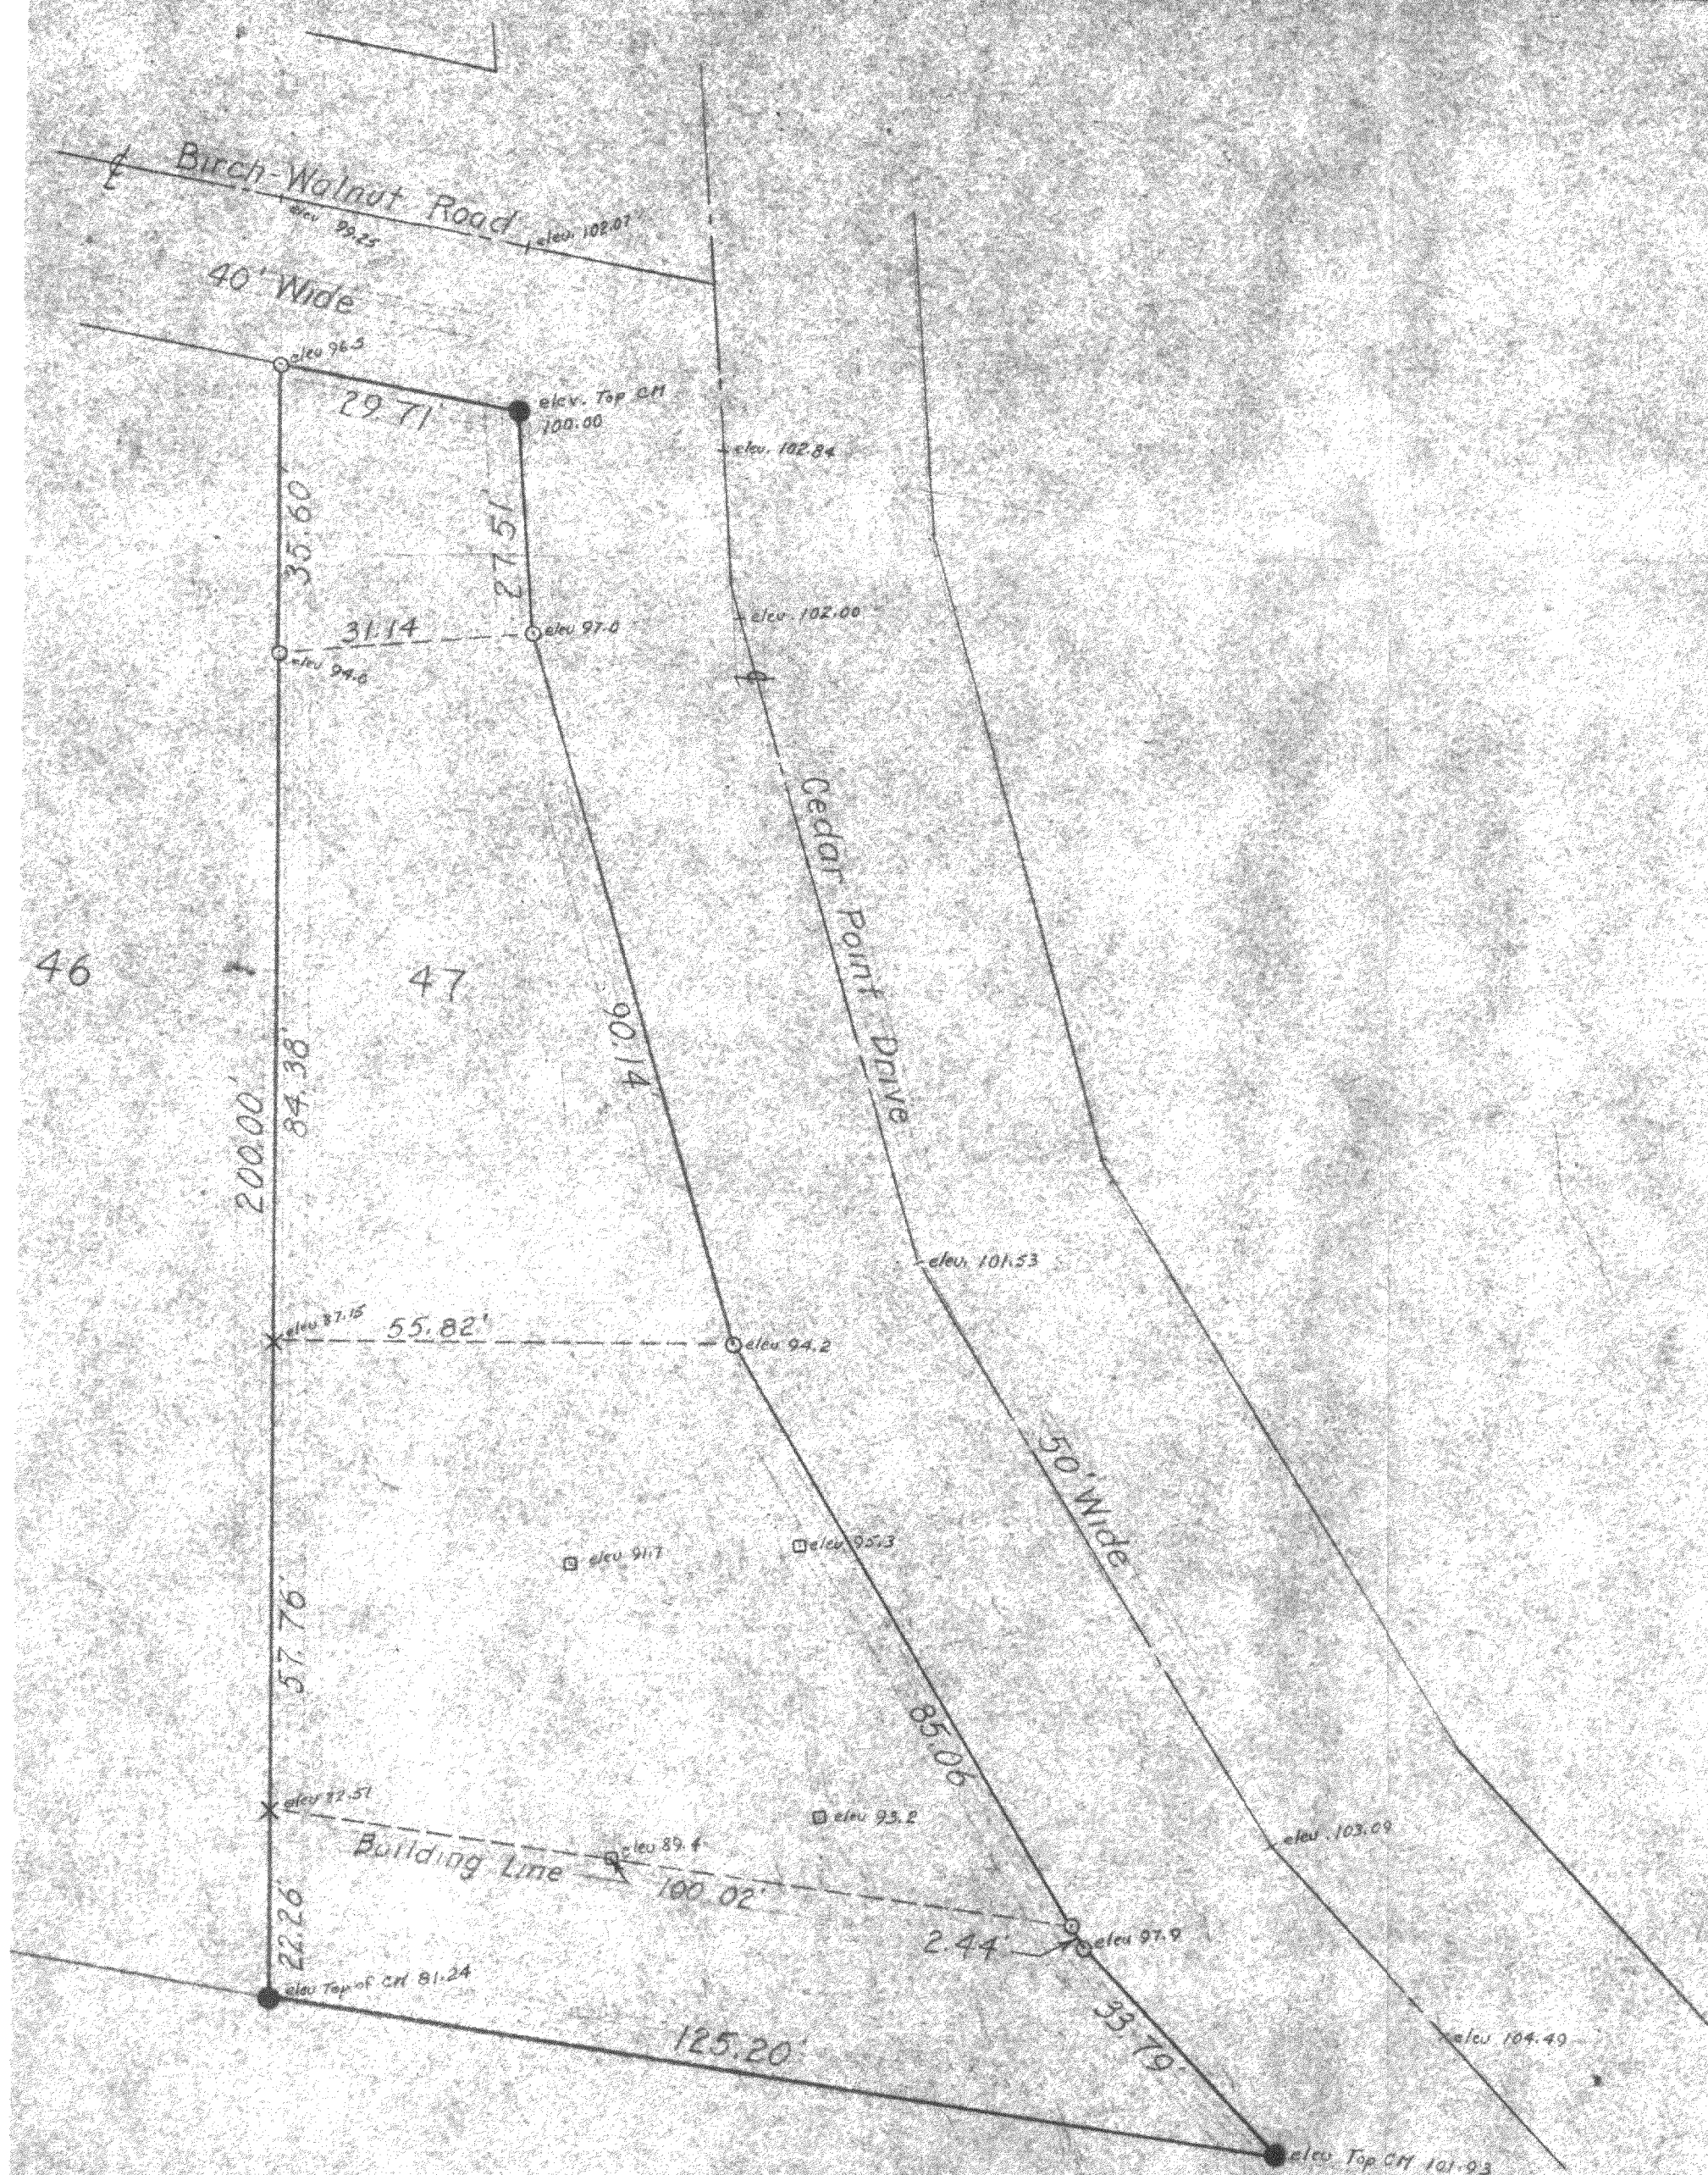

- - Iron Pipe
- - Concrete Monument
- ✕ - Cross Cut in Concrete
- - Wood Stake

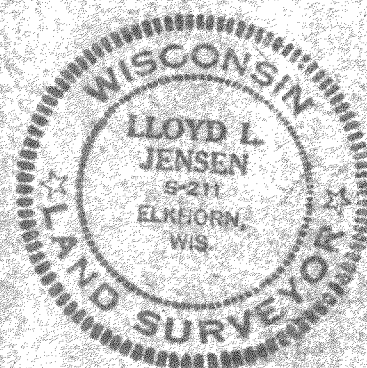

PLAT OF SURVEY OF

Lot 47, 1st Addition to Cedar Point
Park, Village of Williams Bay,
Walworth County, Wisconsin

Lloyd L. Jensen
SURVEYOR

SCALE 1" = 20'

DATE April, 1957

WCP-43

11-1575