


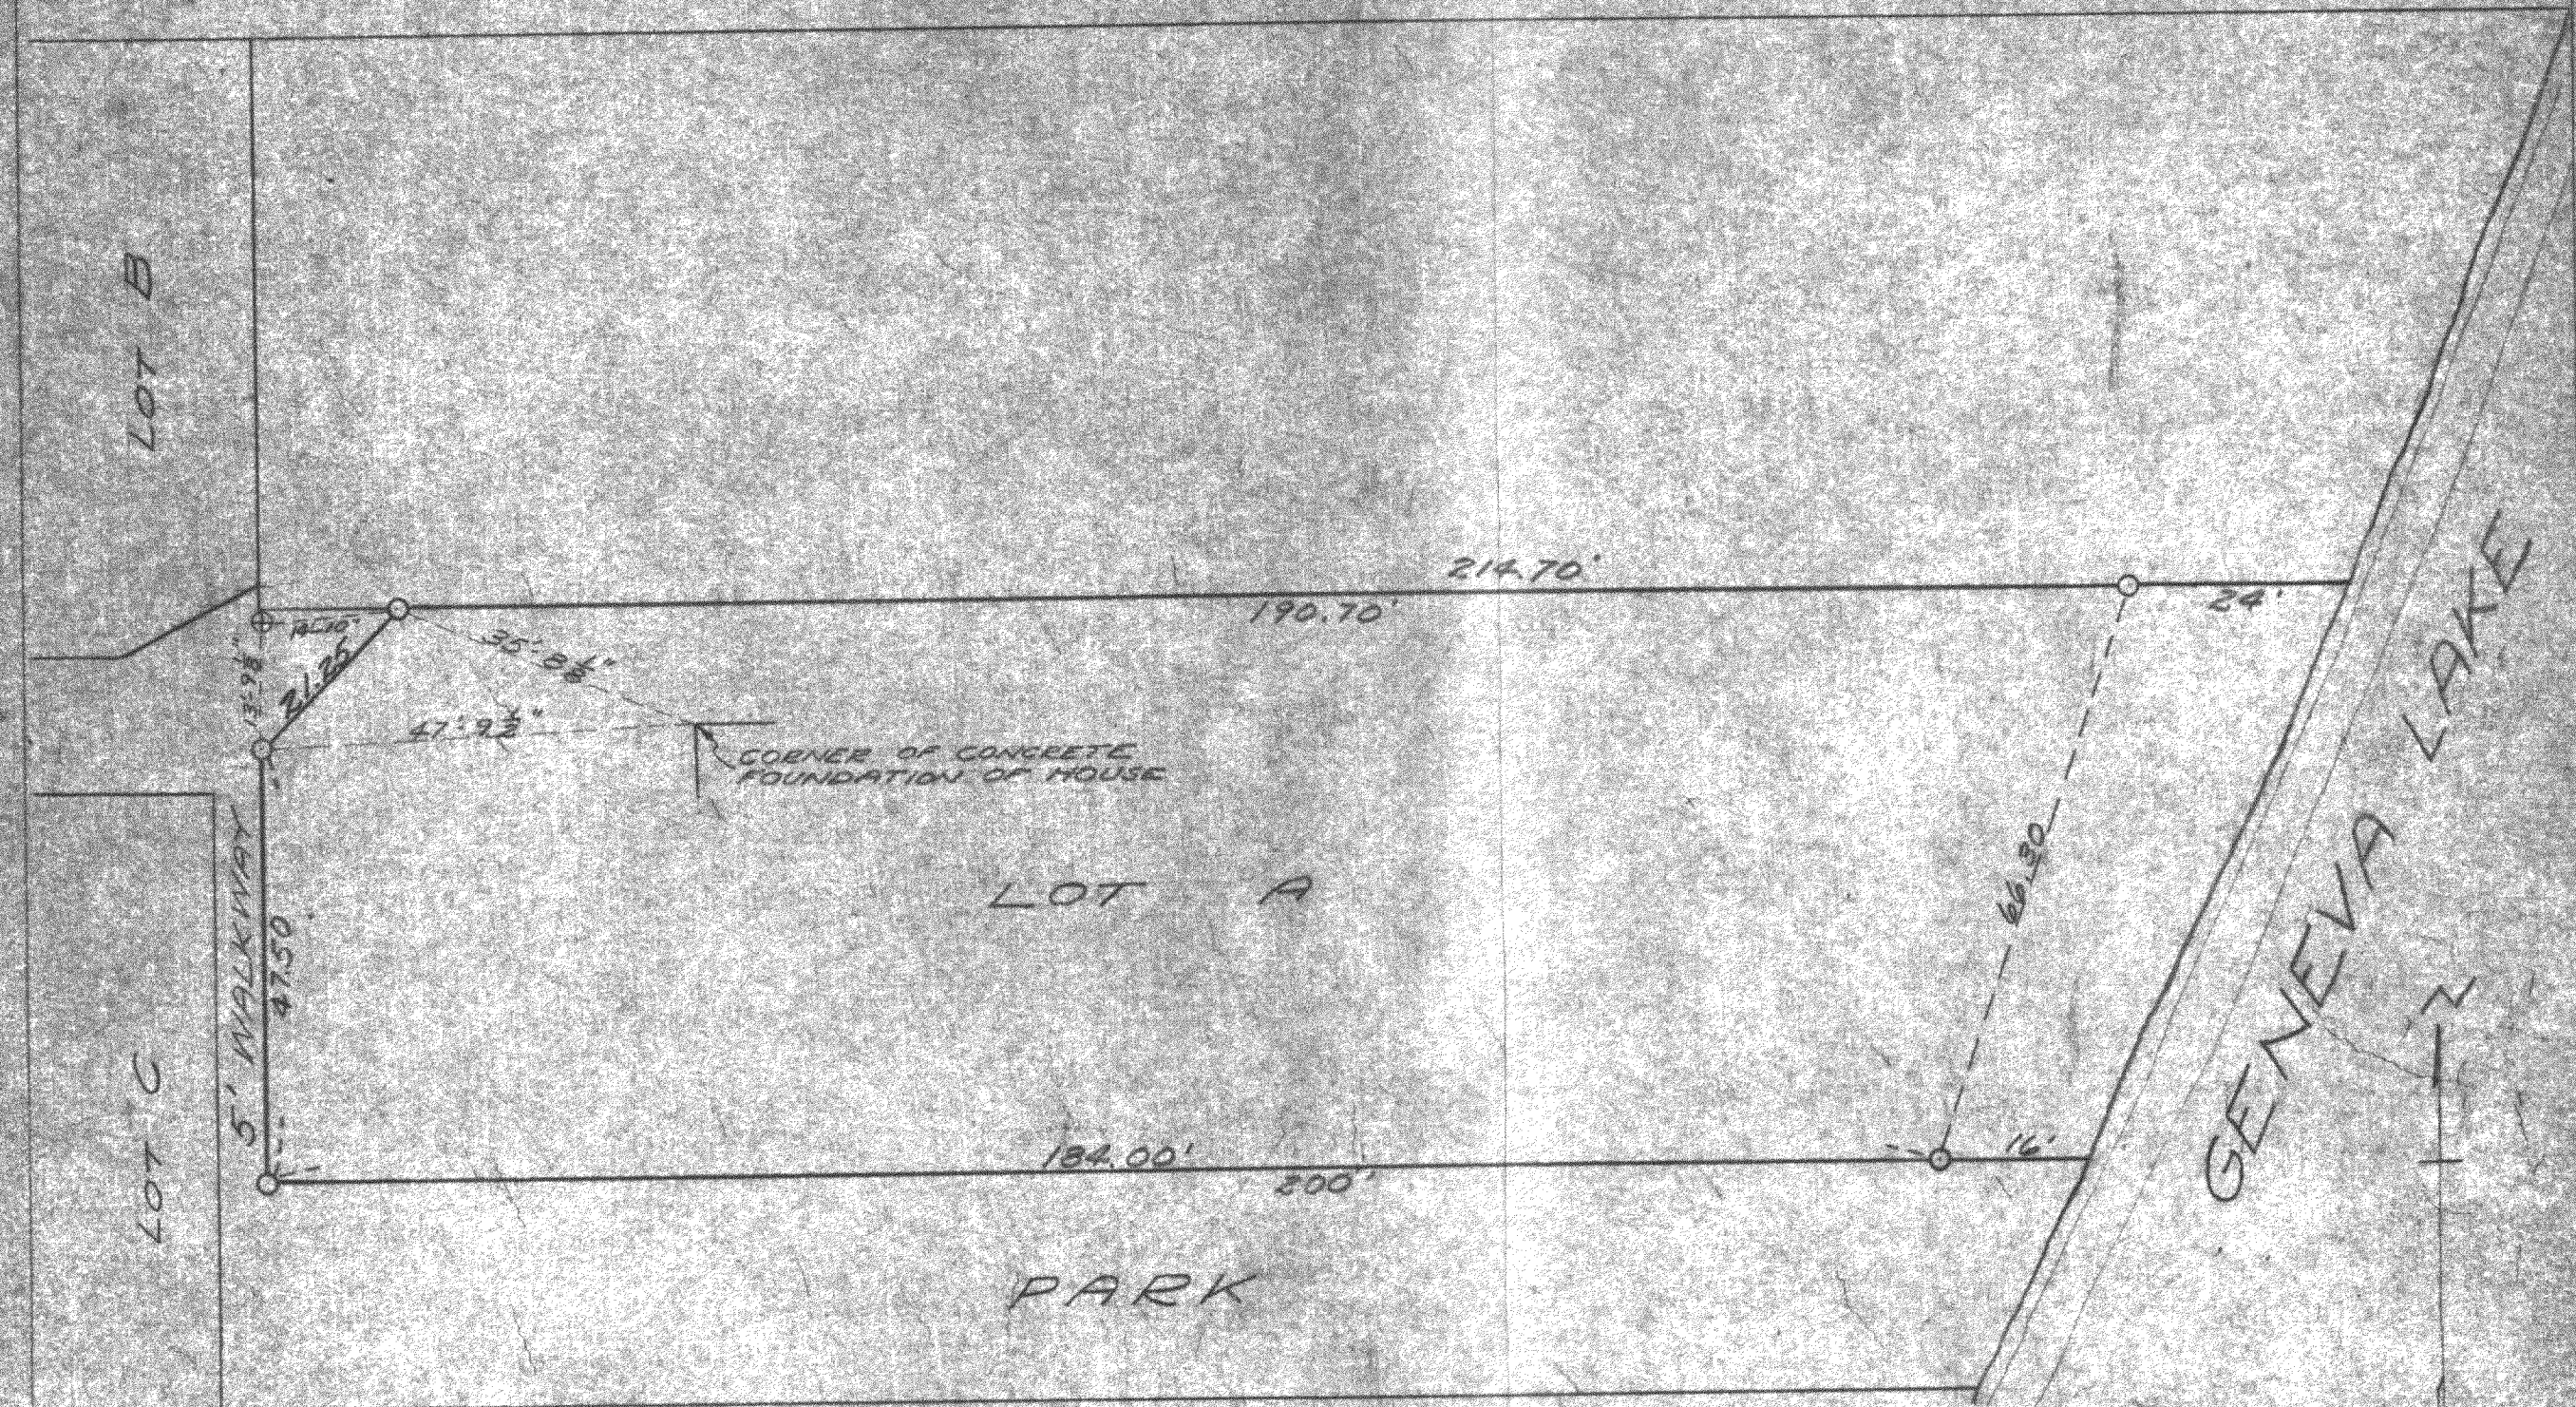

PLAT OF SURVEY OF LOT "A" OF LOCH VISTA SUBDIVISION NO. 2
 IN THE VILLAGE OF WILLIAMS BAY, WALWORTH COUNTY, WISCONSIN.
 OCTOBER 18, 1945

Ployd L. Jensen
 COUNTY SURVEYOR

SCALE - 1" = 20'
 O = IRON PIPE