


PLAT OF SURVEY

OF

$N\frac{1}{2}$ LOT 234 AND LOT 235 EXCEPT THE NORTH $2\frac{1}{2}$ FEET THEREOF OF THE THIRD ADDITION TO CEDAR POINT PARK, VILLAGE OF WILLIAMS BAY, WALWORTH COUNTY WISCONSIN.

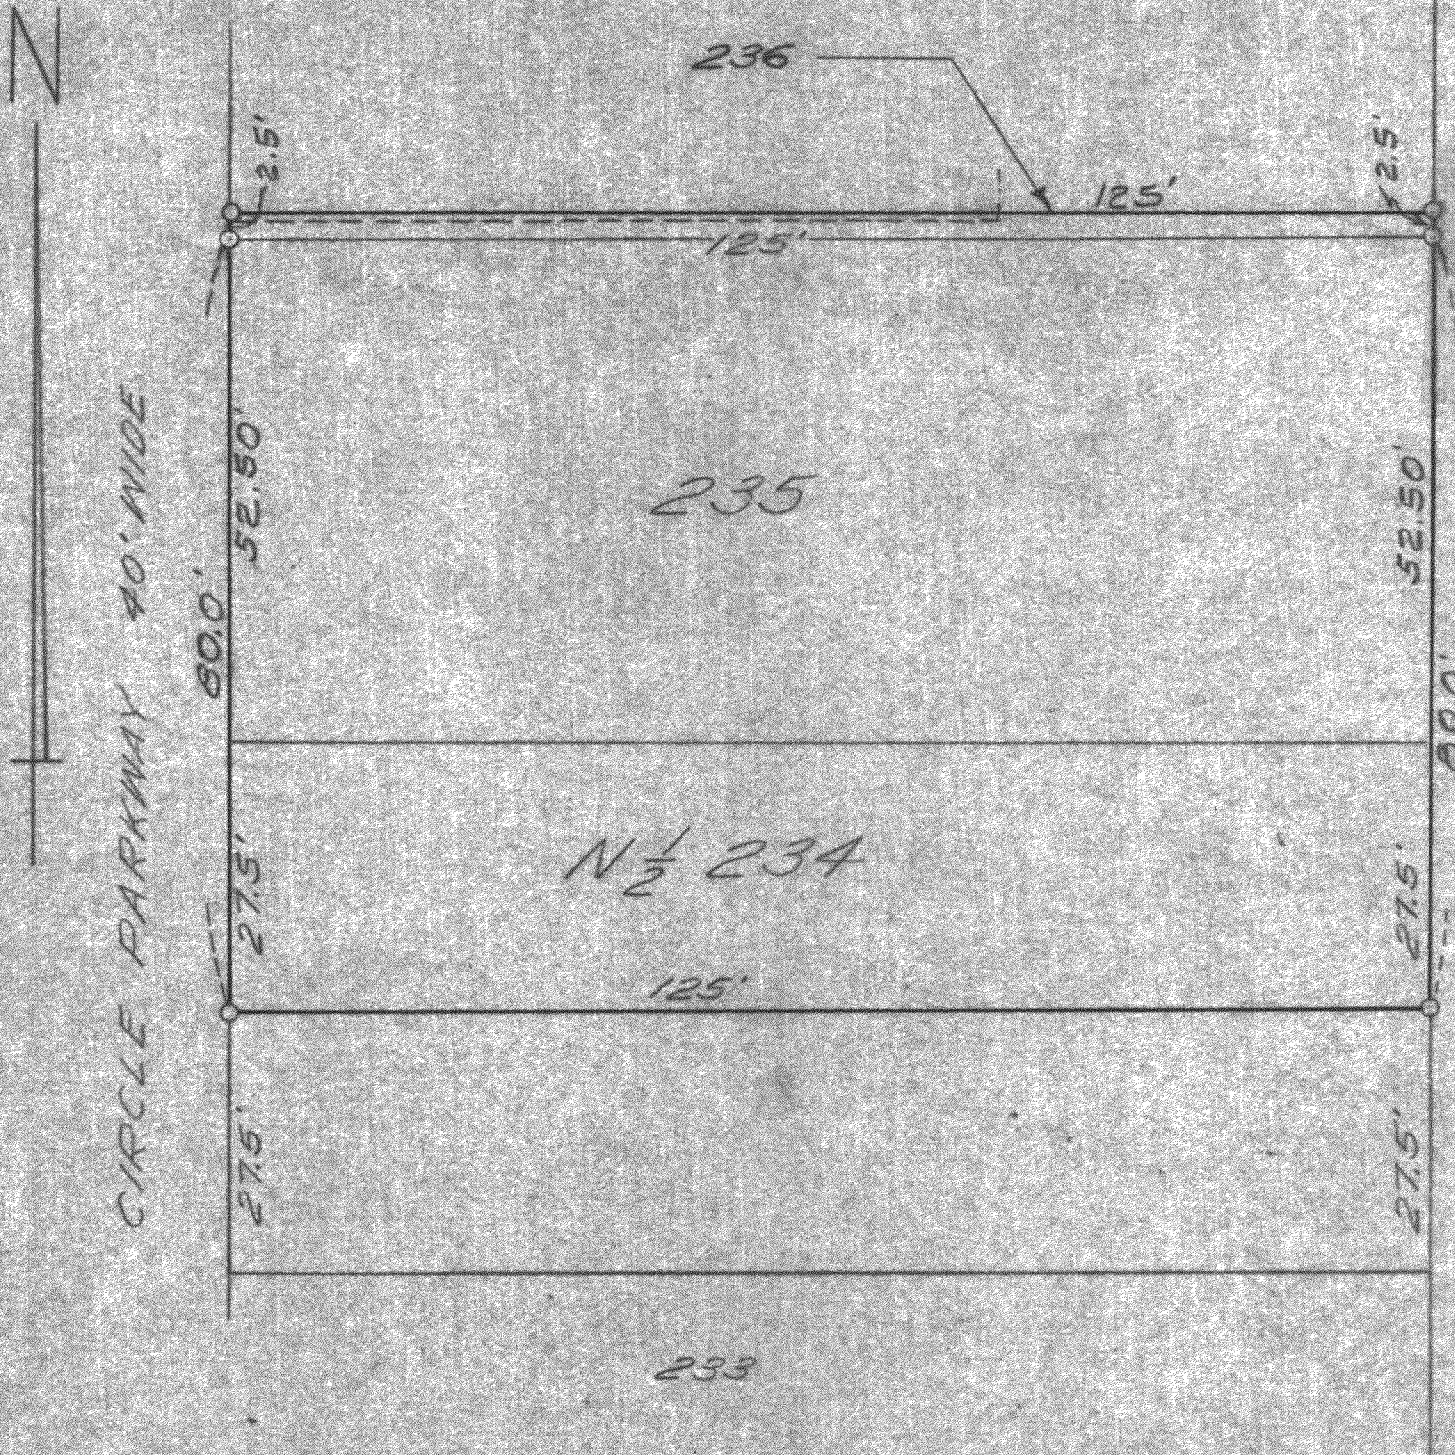

SURVEY AND PLAT BY
JENSEN & JOHNSON
 CIVIL ENGINEERS AND SURVEYORS
 Elkhorn, Wisconsin

LEGEND

- — Iron Pipe
 - — Concrete Monument
- Scale 1" = 20'

WE CERTIFY: That we have surveyed the above described property and that the plat shown hereon is an accurate survey and a true representation thereof and correctly shows the exterior boundary lines and all divisions of said property.

Date MAY 1968
 REVISED MAY 1970

Lloyd L. Jensen
 LLOYD L. JENSEN, Partner
 Wisconsin Registered Land Surveyor, No. S-211

WCP 330