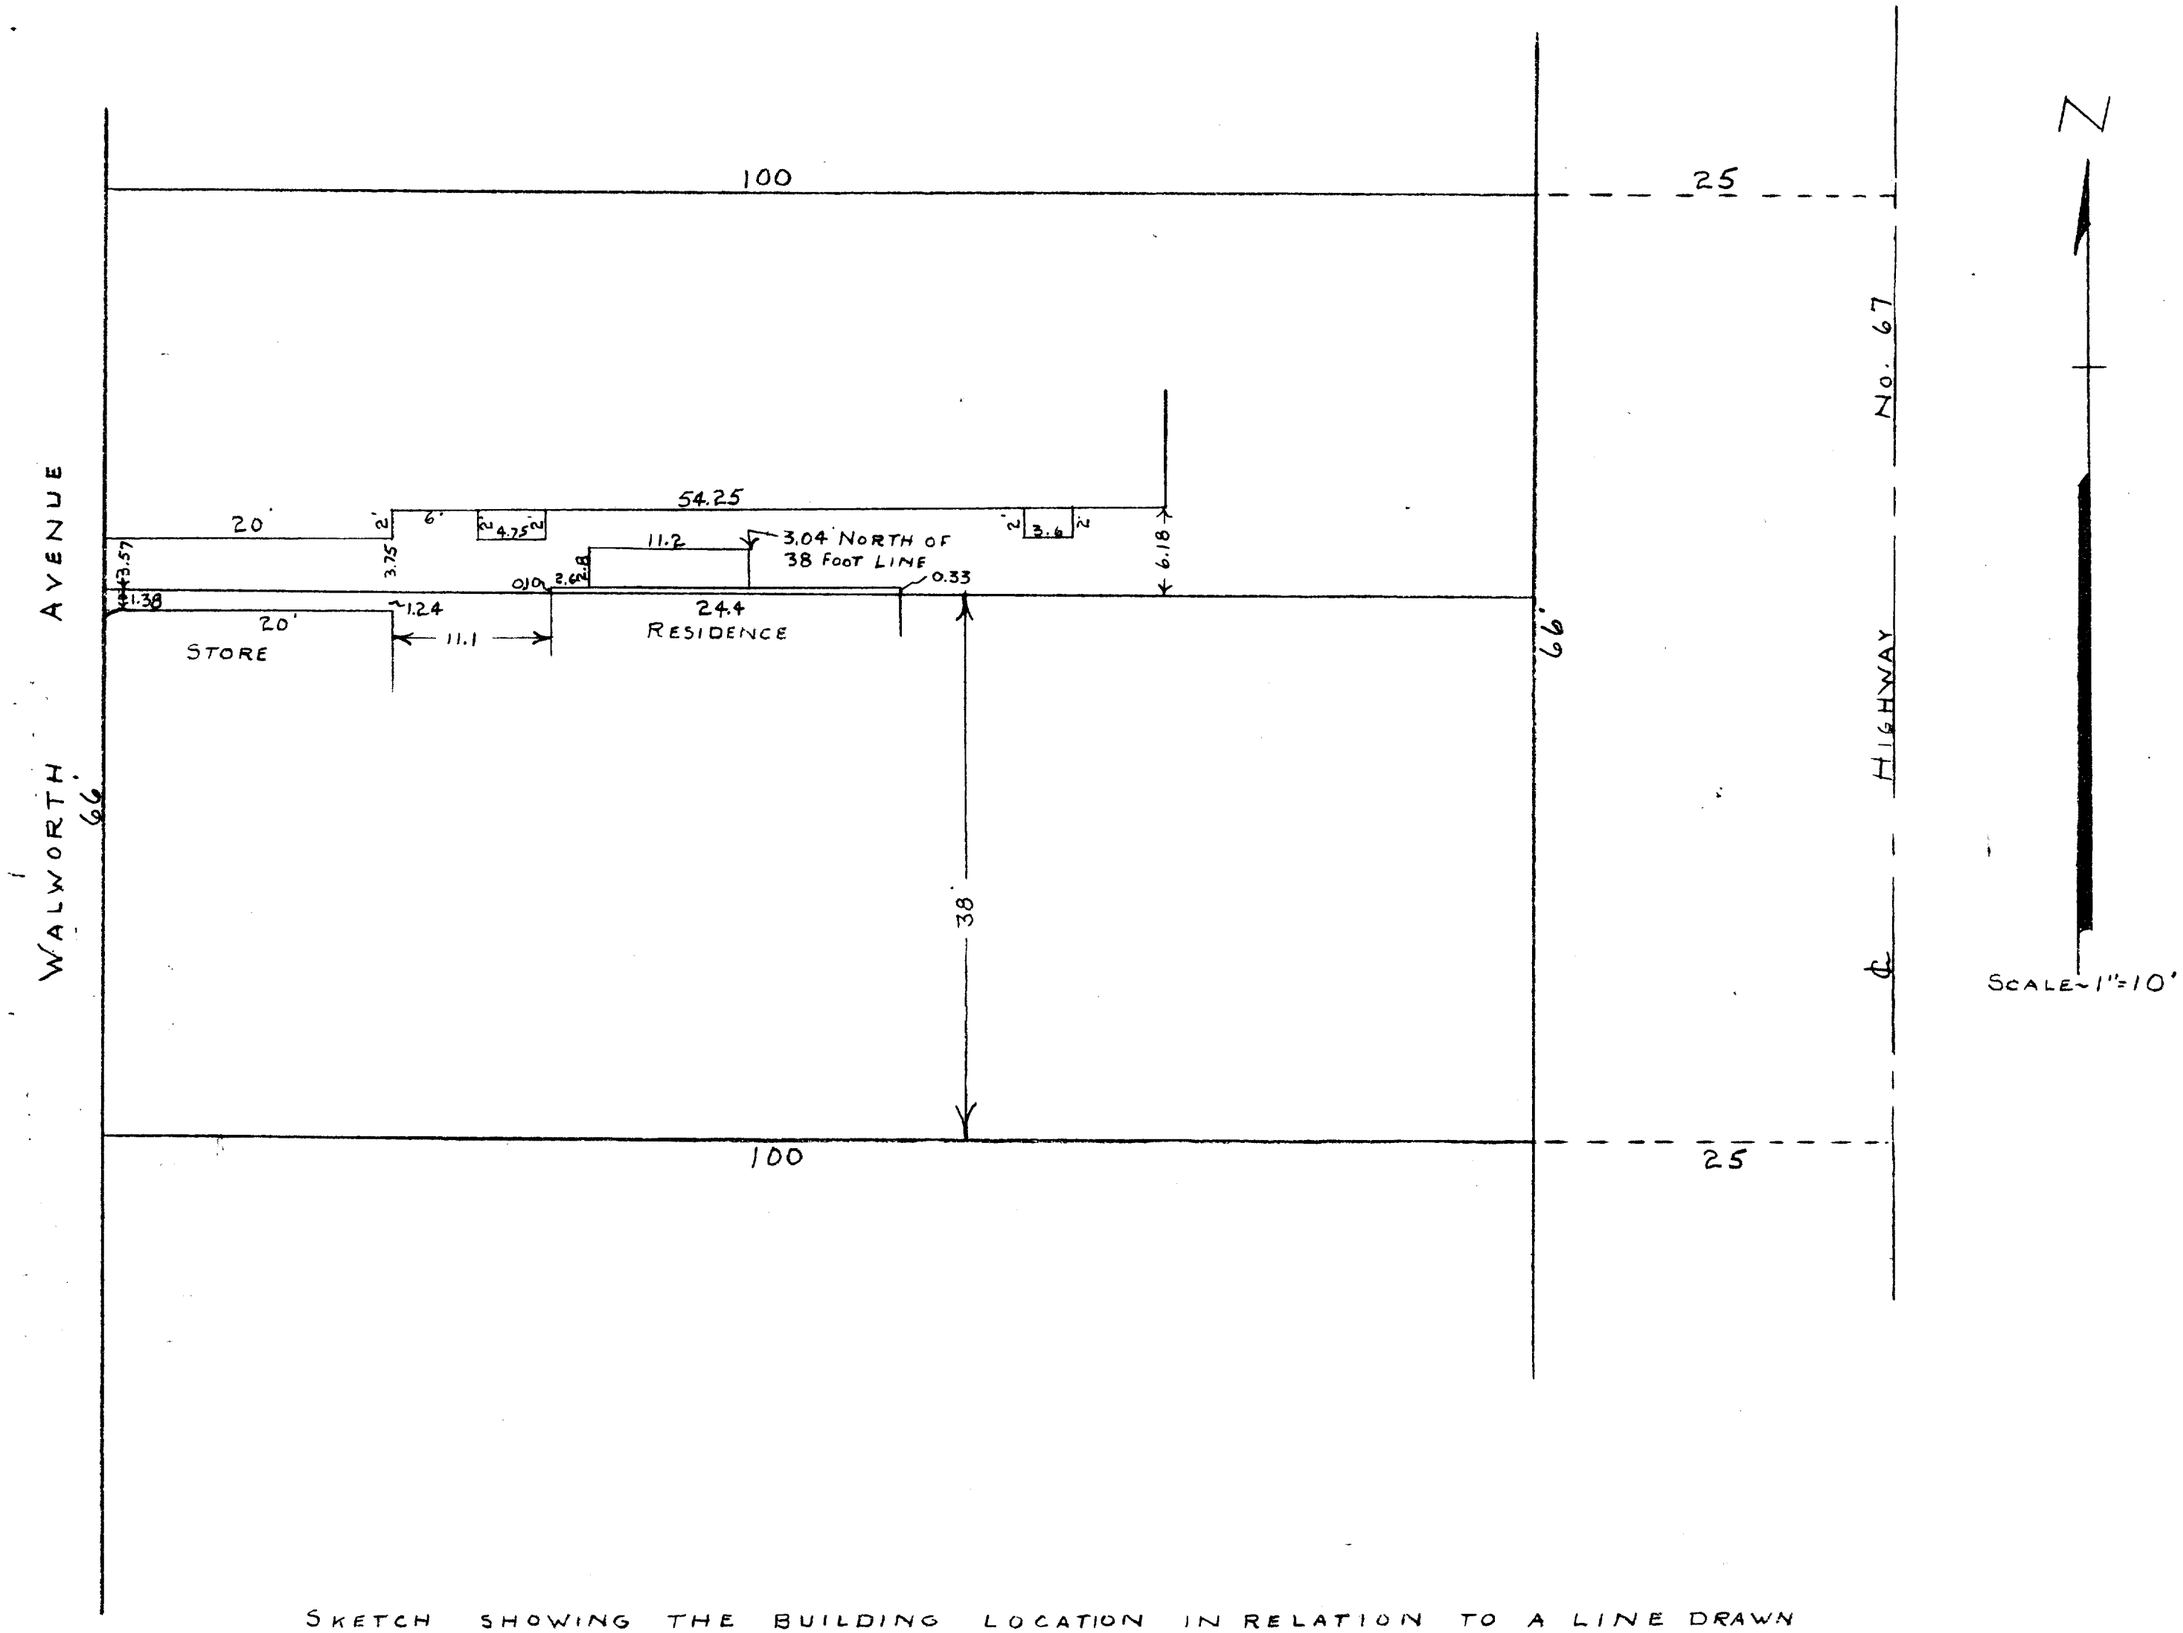

SKETCH SHOWING THE BUILDING LOCATION IN RELATION TO A LINE DRAWN PARALLEL TO AND 38 FEET NORTH OF THE SOUTH LINE OF LOT 7, BLOCK 1, ORIGINAL TOWN, WILLIAMS BAY, WISCONSIN
DEC, 1955

George T. Dunham
GEORGE T. DUNHAM, SURVEYOR
DELAVAN, WISCONSIN

11-19

00-748