


PLAT OF SURVEY
TOPOGRAPHICAL MAPPING

LOTS 221-222 OF CEDAR POINT PARK 3rd ADDITION
LOCATED IN PART OF THE NORTHWEST 1/4 OF THE NORTHEAST 1/4 OF
SECTION 7, TOWN 1 NORTH, RANGE 17 EAST, VILLAGE OF WILLIAMS BAY, WISCONSIN

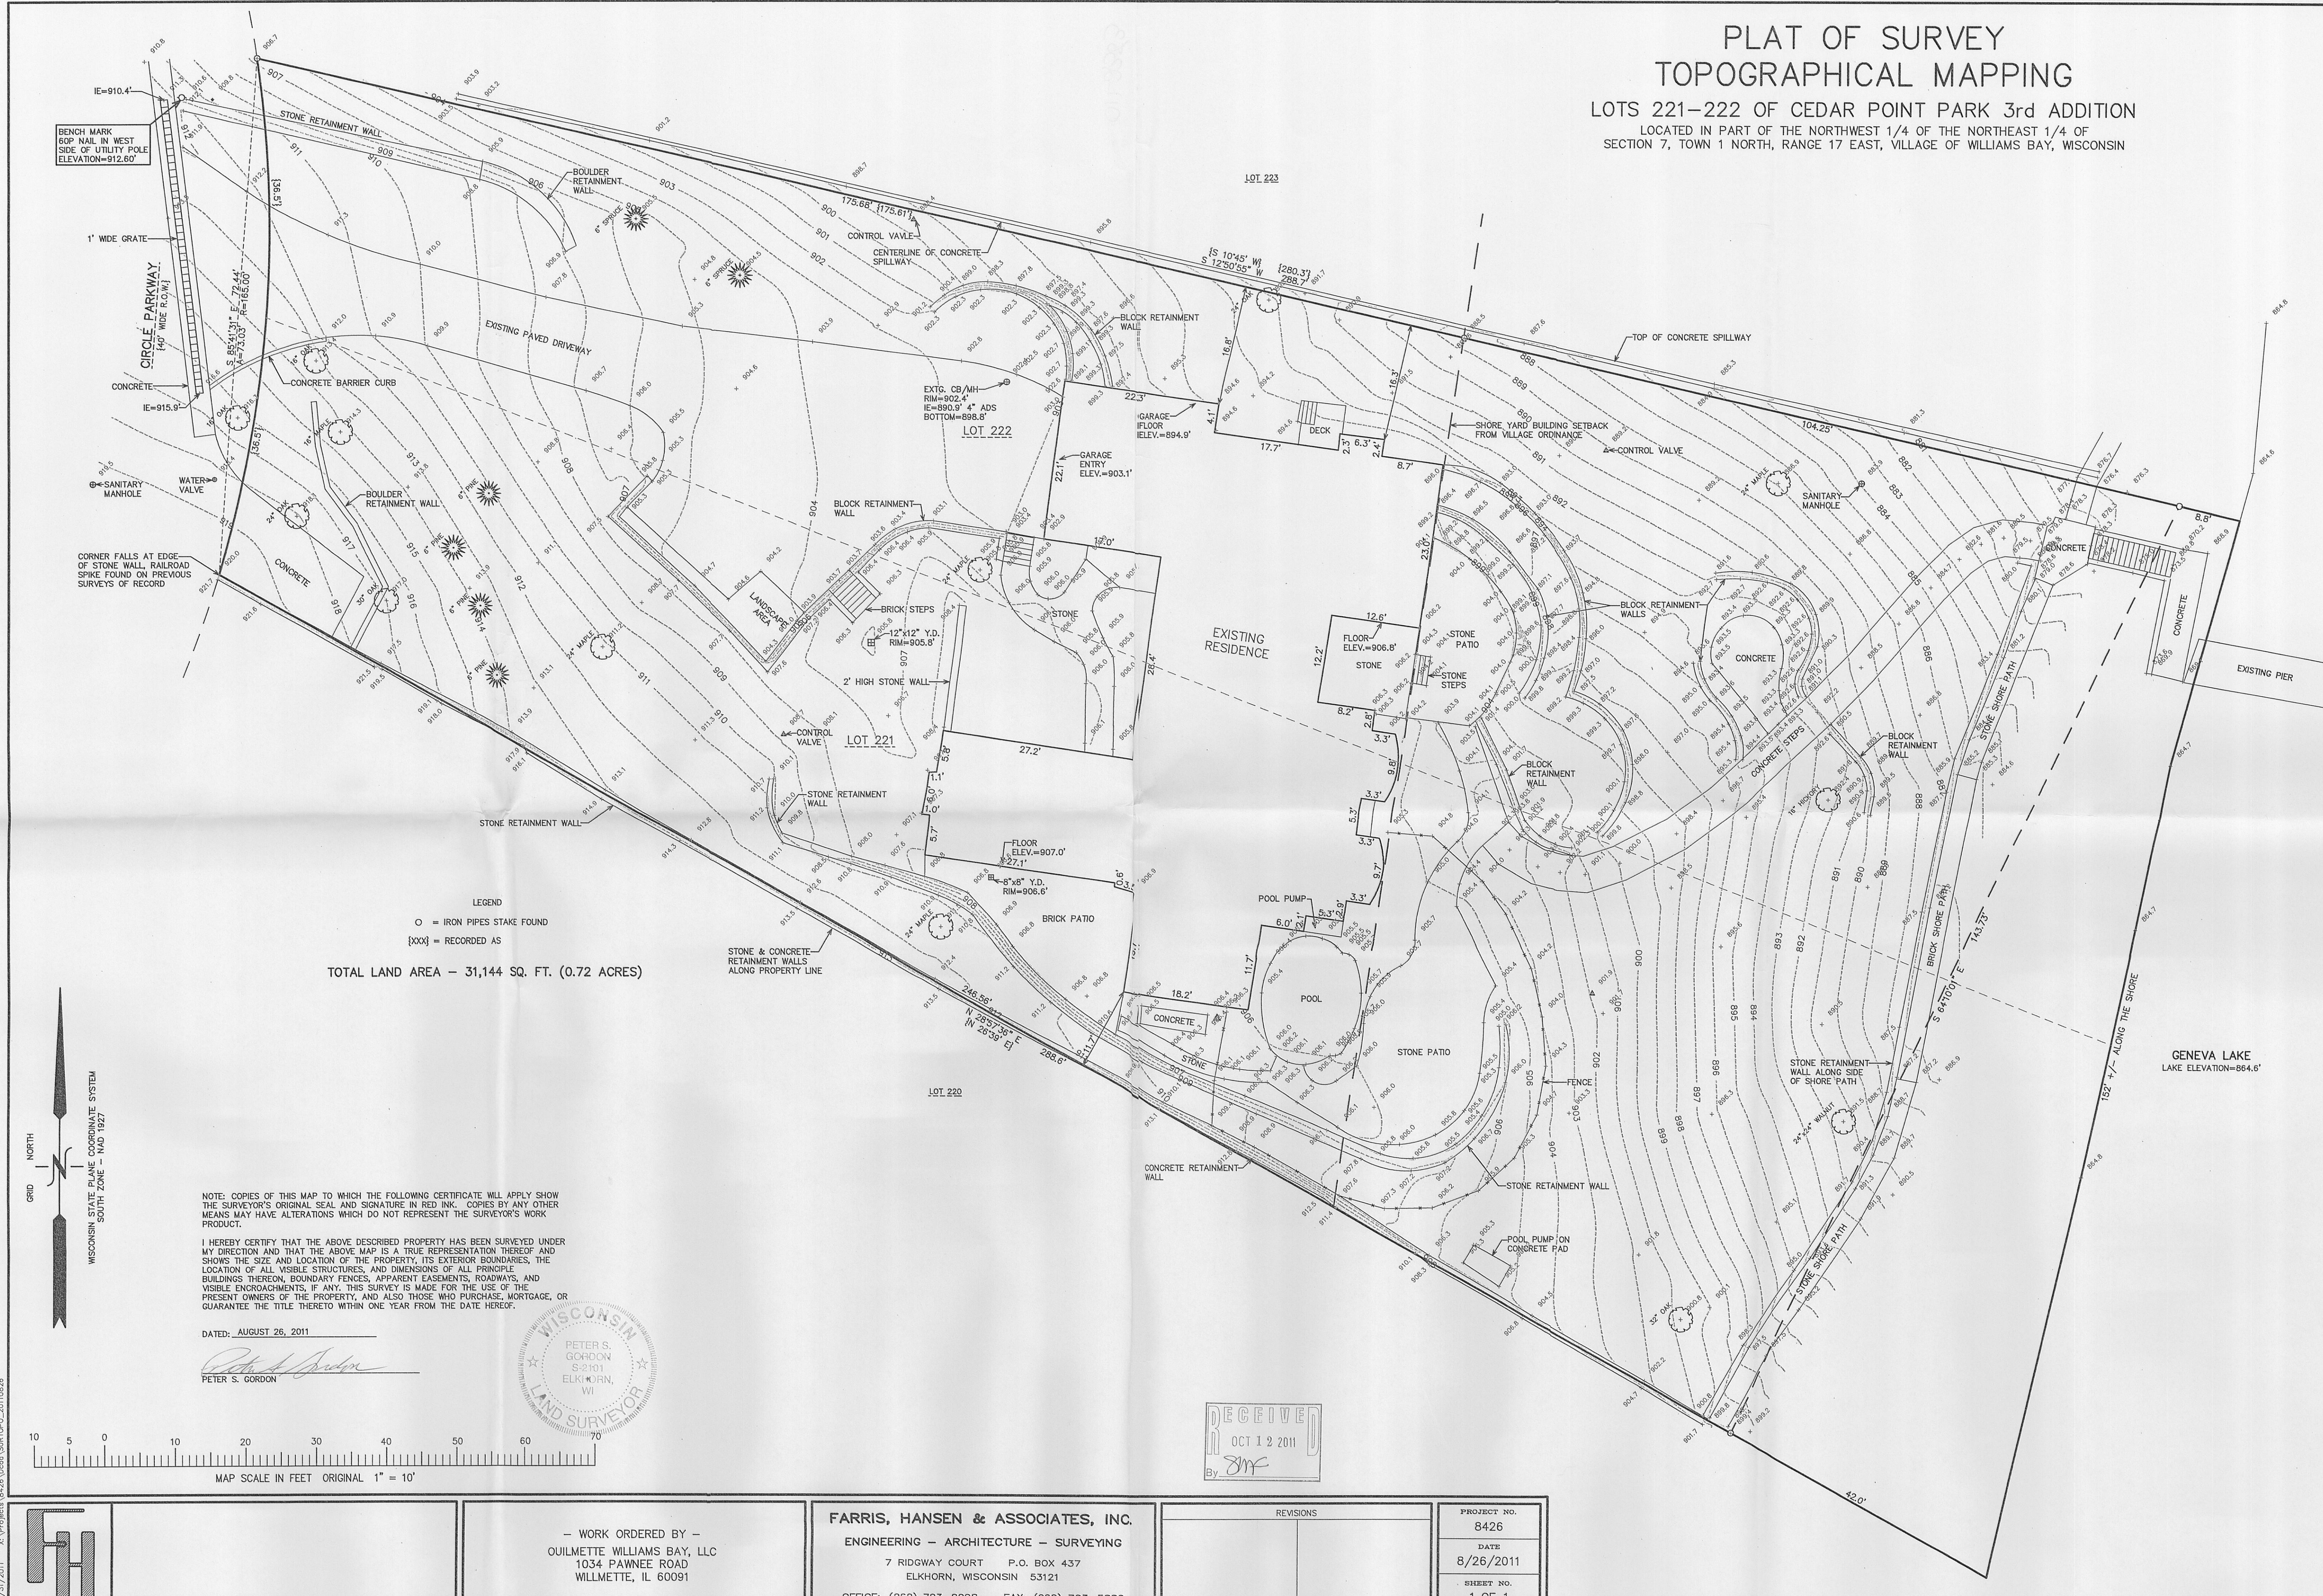




TOTAL LAND AREA - 31,144 SQ. FT. (0.72 ACRES)

NOTE: COPIES OF THIS MAP TO WHICH THE FOLLOWING CERTIFICATE WILL APPLY SHOW THE SURVEYOR'S ORIGINAL SEAL AND SIGNATURE IN RED INK. COPIES BY ANY OTHER MEANS MAY HAVE ALTERATIONS WHICH DO NOT REPRESENT THE SURVEYOR'S WORK PRODUCT.

I HEREBY CERTIFY THAT THE ABOVE DESCRIBED PROPERTY HAS BEEN SURVEYED UNDER MY DIRECTION AND THAT THE ABOVE MAP IS A TRUE REPRESENTATION THEREOF AND SHOWS THE SIZE AND LOCATION OF THE PROPERTY, ITS EXTERIOR BOUNDARIES, THE LOCATION OF ALL VISIBLE STRUCTURES, AND DIMENSIONS OF ALL PRINCIPLE BUILDINGS THEREON, BOUNDARY FENCES, APPARENT EASEMENTS, ROADWAYS, AND VISIBLE ENCROACHMENTS, IF ANY. THIS SURVEY IS MADE FOR THE USE OF THE PRESENT OWNERS OF THE PROPERTY, AND ALSO THOSE WHO PURCHASE, MORTGAGE, OR GUARANTEE THE TITLE THERETO WITHIN ONE YEAR FROM THE DATE HEREOF.

DATED: AUGUST 26, 2011

PETER S. GORDON

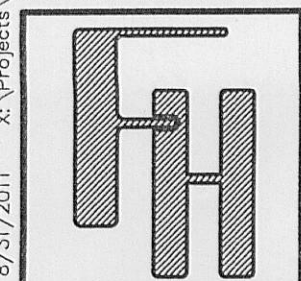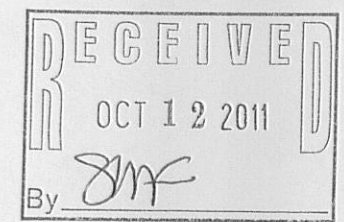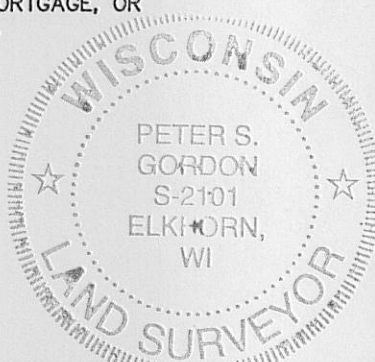

— WORK ORDERED BY —
OUILMETTE WILLIAMS BAY, LLC
1034 PAWNEE ROAD
WILLMETTE, IL 60091

FARRIS, HANSEN & ASSOCIATES, INC.
ENGINEERING - ARCHITECTURE - SURVEYING
7 RIDGWAY COURT P.O. BOX 437
ELKHORN, WISCONSIN 53121
OFFICE: (262) 723-2098 FAX: (262) 723-5886

REVISIONS

PROJECT NO.
8426
DATE
8/26/2011
SHEET NO.
1 OF 1

WCP3-19

011-2383