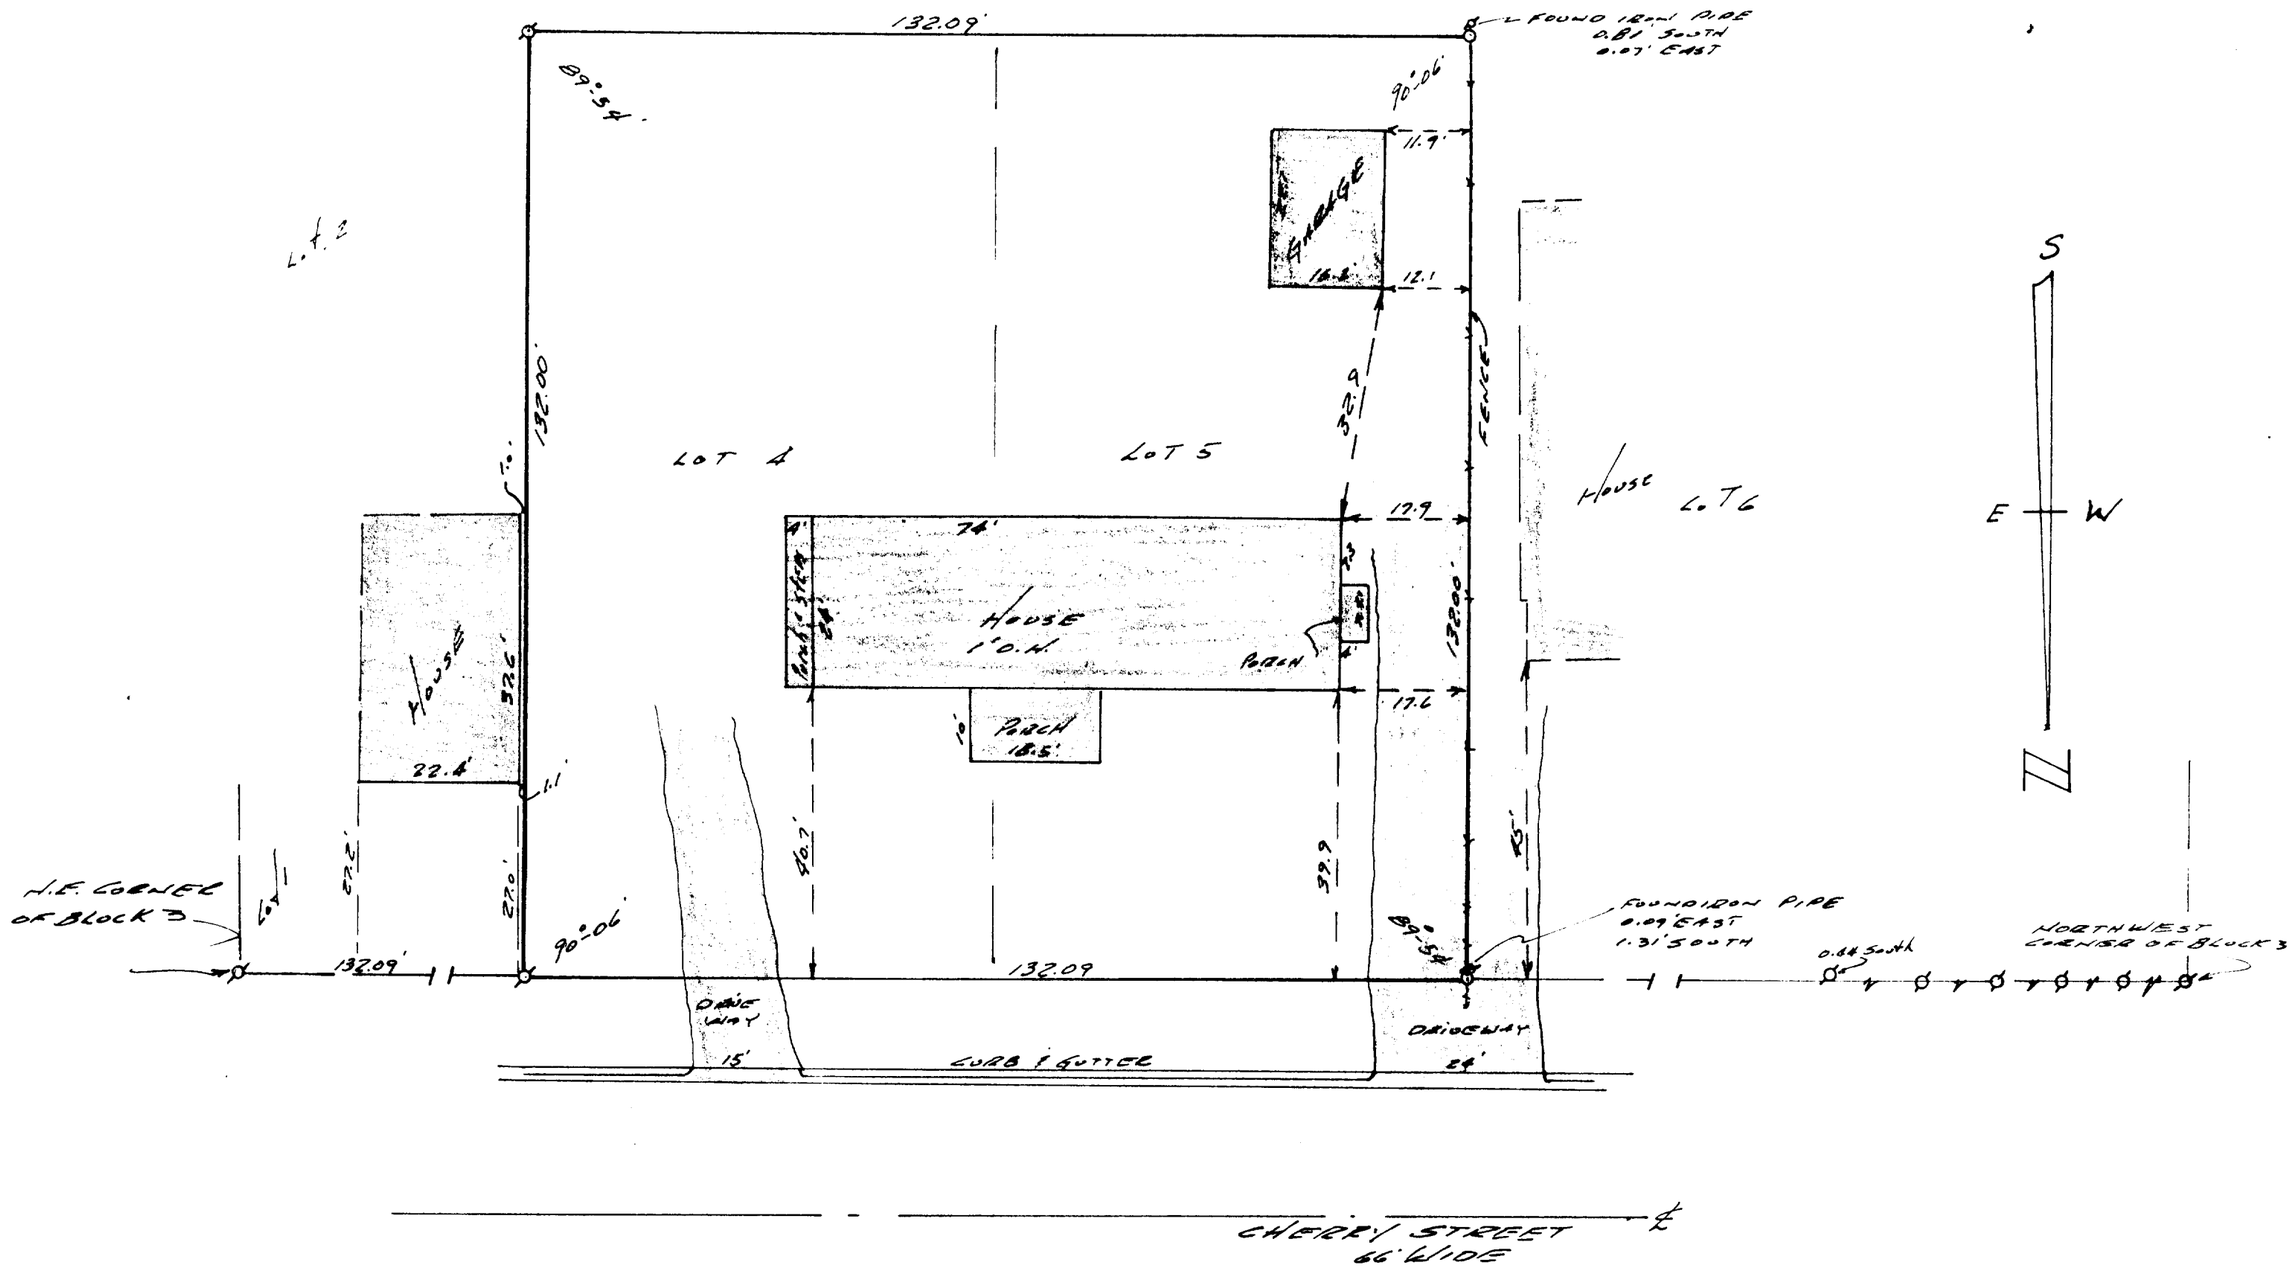

ø — IRON PIPE FOUND
o — IRON PIPE SET
O.H. — OVERHANG

PLAT OF SURVEY

OF

LOTS 4 & 5 BLOCK 3 ORIGINAL PLAT, VILLAGE OF WILLIAMS BAY, WALWORTH COUNTY, WISCONSIN

WISCONSIN THOMAS P. A. JENSEN S-1014 ELKHORN, WIS. LAND SURVEYOR

Thomas P. A. Jensen
SURVEYOR

SCALE 1" = 20'

DATE MAR 15, 1974

WOP-35

NO. 175H 300 9-68

11-262