


DUNHAM SURVEYING, S.C.  
SURVEYING & SUBDIVIDING  
DELAVAN, WISCONSIN 53115

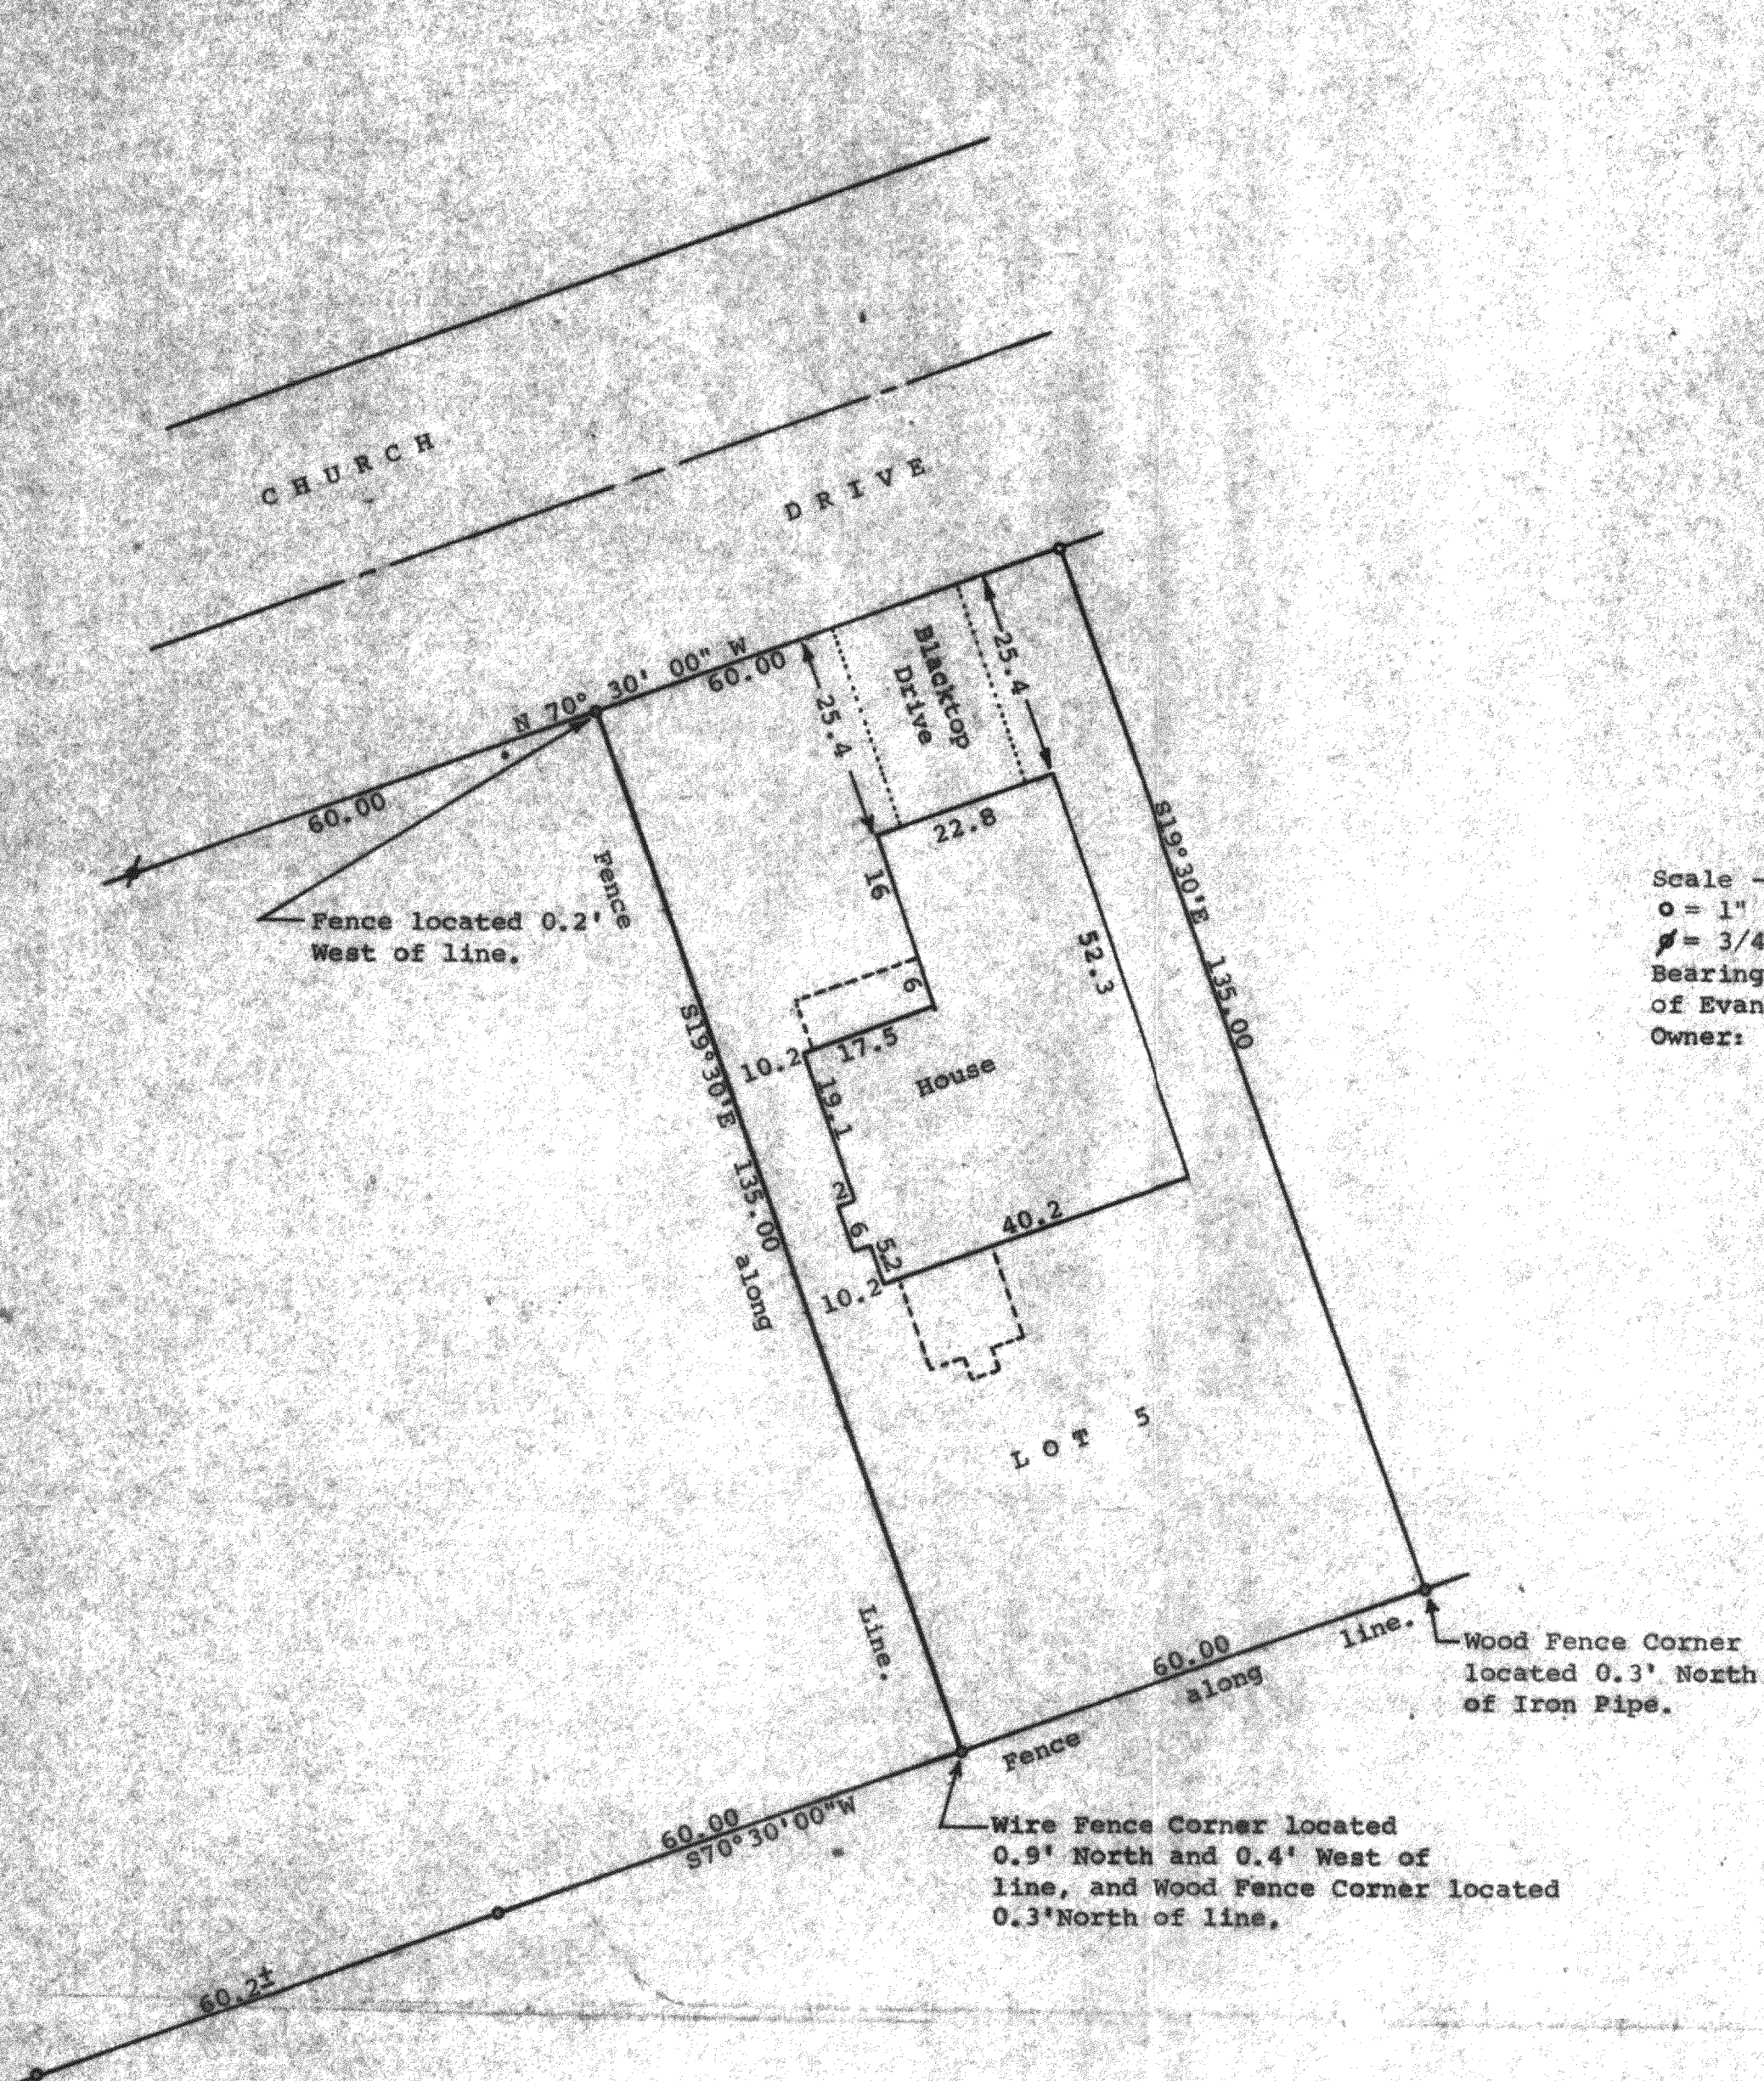

Scale - 1" = 20'  
 o = 1" Iron Pipe Found  
 ø = 3/4" Iron Pipe Found  
 Bearings shown are those on the recorded plat  
 of Evangelical Free Church Subdivision  
 Owner: Marie Redpath  
 513 Free Church Drive  
 Williams Bay, WI 53191

STATE OF WISCONSIN) SS  
 COUNTY OF WALWORTH)

I, Richard C. Schulz, Surveyor, certify that I have surveyed  
 the property described as follows,

Lot 5, Evangelical Free Church Subdivision, located in the  
 Village of Williams Bay, Walworth County, Wisconsin,  
 and that the map shown hereon is a true representation thereof and shows  
 the size and location of the property, its exterior boundaries, the  
 location of all visible structures and dimensions of all principal  
 buildings thereon, boundary fences, apparent easements, roadways and  
 visible encroachments, if any, and that I have surveyed the property  
 hereon described according to the official records, to the best of  
 my knowledge and belief.

June 27, 1984.

Richard C. Schulz  
 Richard C. Schulz, Surveyor

