


DUNHAM SURVEYING, S.C.
SURVEYING & SUBDIVIDING
DELAVER, WISCONSIN 53115

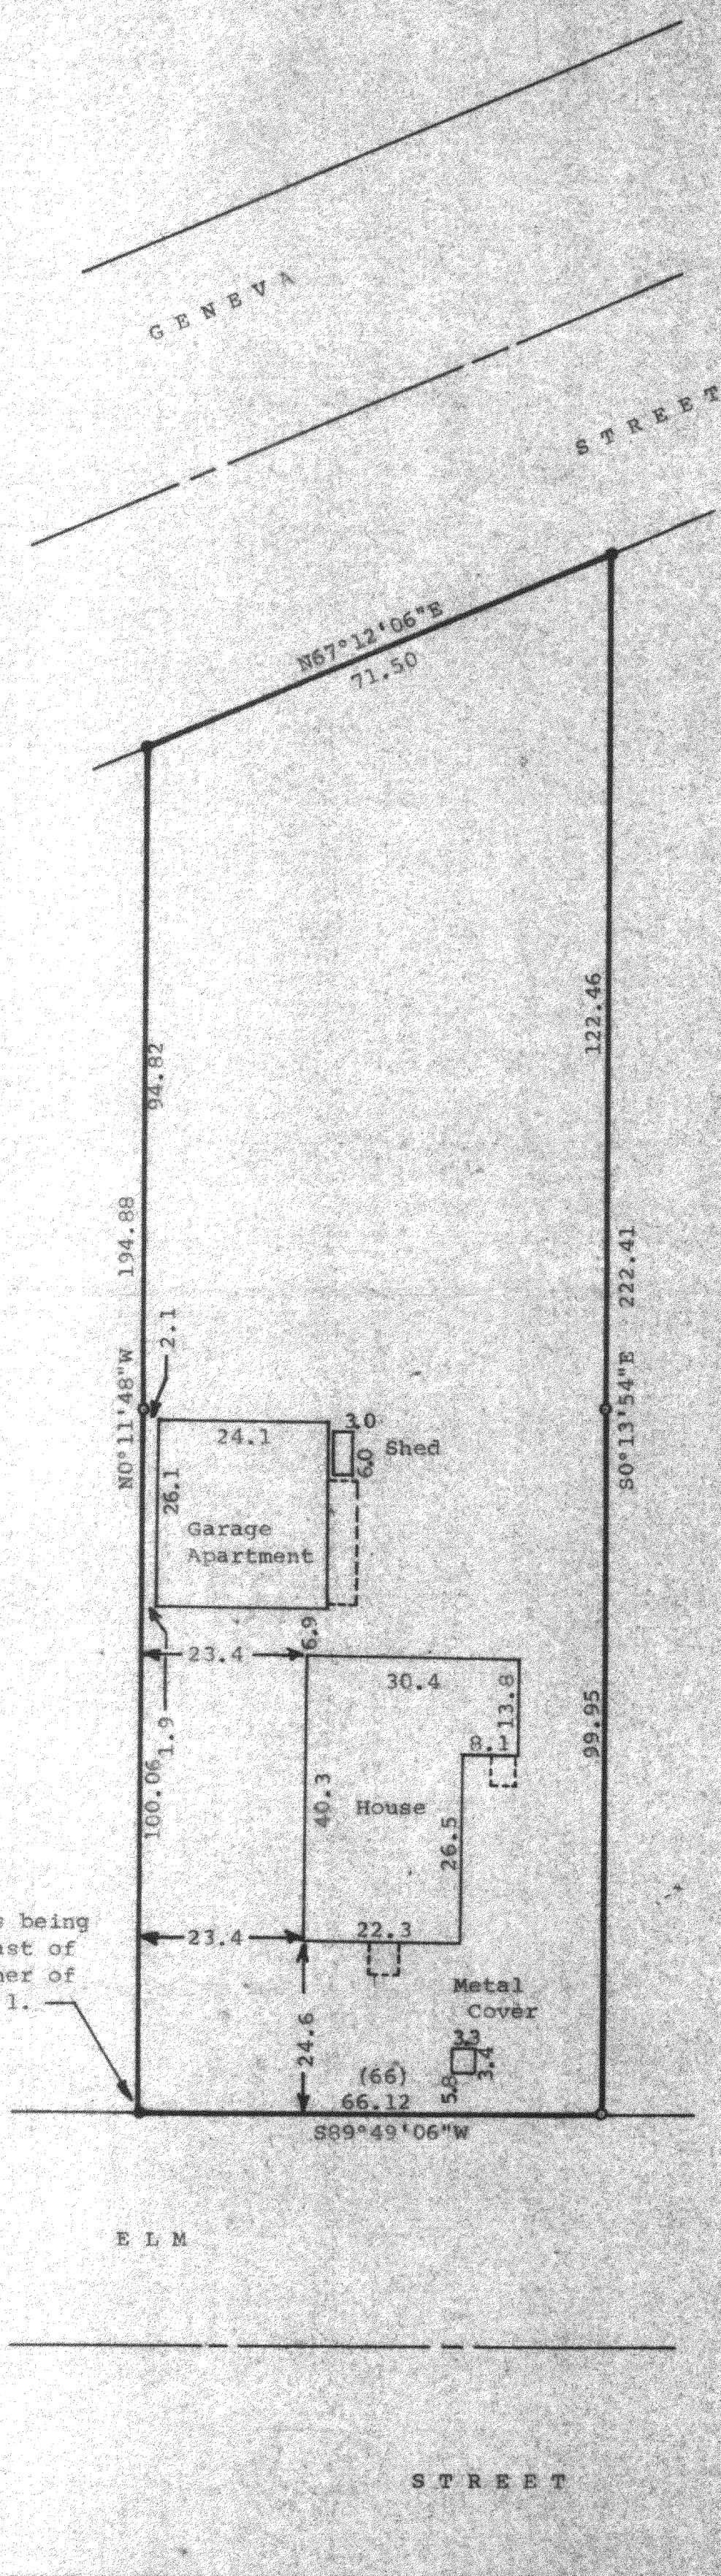

Scale - 1" = 20'
 ● = 1" Dia. Iron Pipe Found
 ○ = 3/4" Dia. Iron Pipe Found
 (66) = Recorded Distance
 Bearings are referenced to the East
 line of the property surveyed, previously
 recorded bearing of $S0^{\circ}13'54''E$.
 Survey Ordered By: Dorothy Watner
 P.O. Box 103
 Williams Bay, WI 53191

STATE OF WISCONSIN)
 COUNTY OF WALWORTH)
 I, George T. Dunham, Surveyor, certify that I have
 surveyed the property described as follows.
 A part of Lot 1, Block 4 of the Original Plat of
 the Village of Williams Bay, Walworth County,
 Wisconsin, described as follows: Commencing at
 a point 66 feet east of the southwest corner of
 said Lot 1, Block 1; thence North to the south side
 of Geneva Street; thence Northeasterly, along the
 south side of Geneva Street to a point 66 feet east
 of the above mentioned line measured at right angles;
 thence South, to the north side of Elm Street; thence
 West, 66 feet to the place of beginning,
 and that the map shown hereon is a correct representation
 thereof and shows the size and location of the property, its
 exterior boundaries, the location of all visible structures
 and dimensions of all principal buildings thereon, boundary
 fences, apparent easements, roadways and visible encroachments,
 if any, and that I have surveyed the property hereon described
 according to the official records, to the best of my knowledge
 and belief.
 October 22, 1987.

George T. Dunham
 George T. Dunham, Surveyor

