


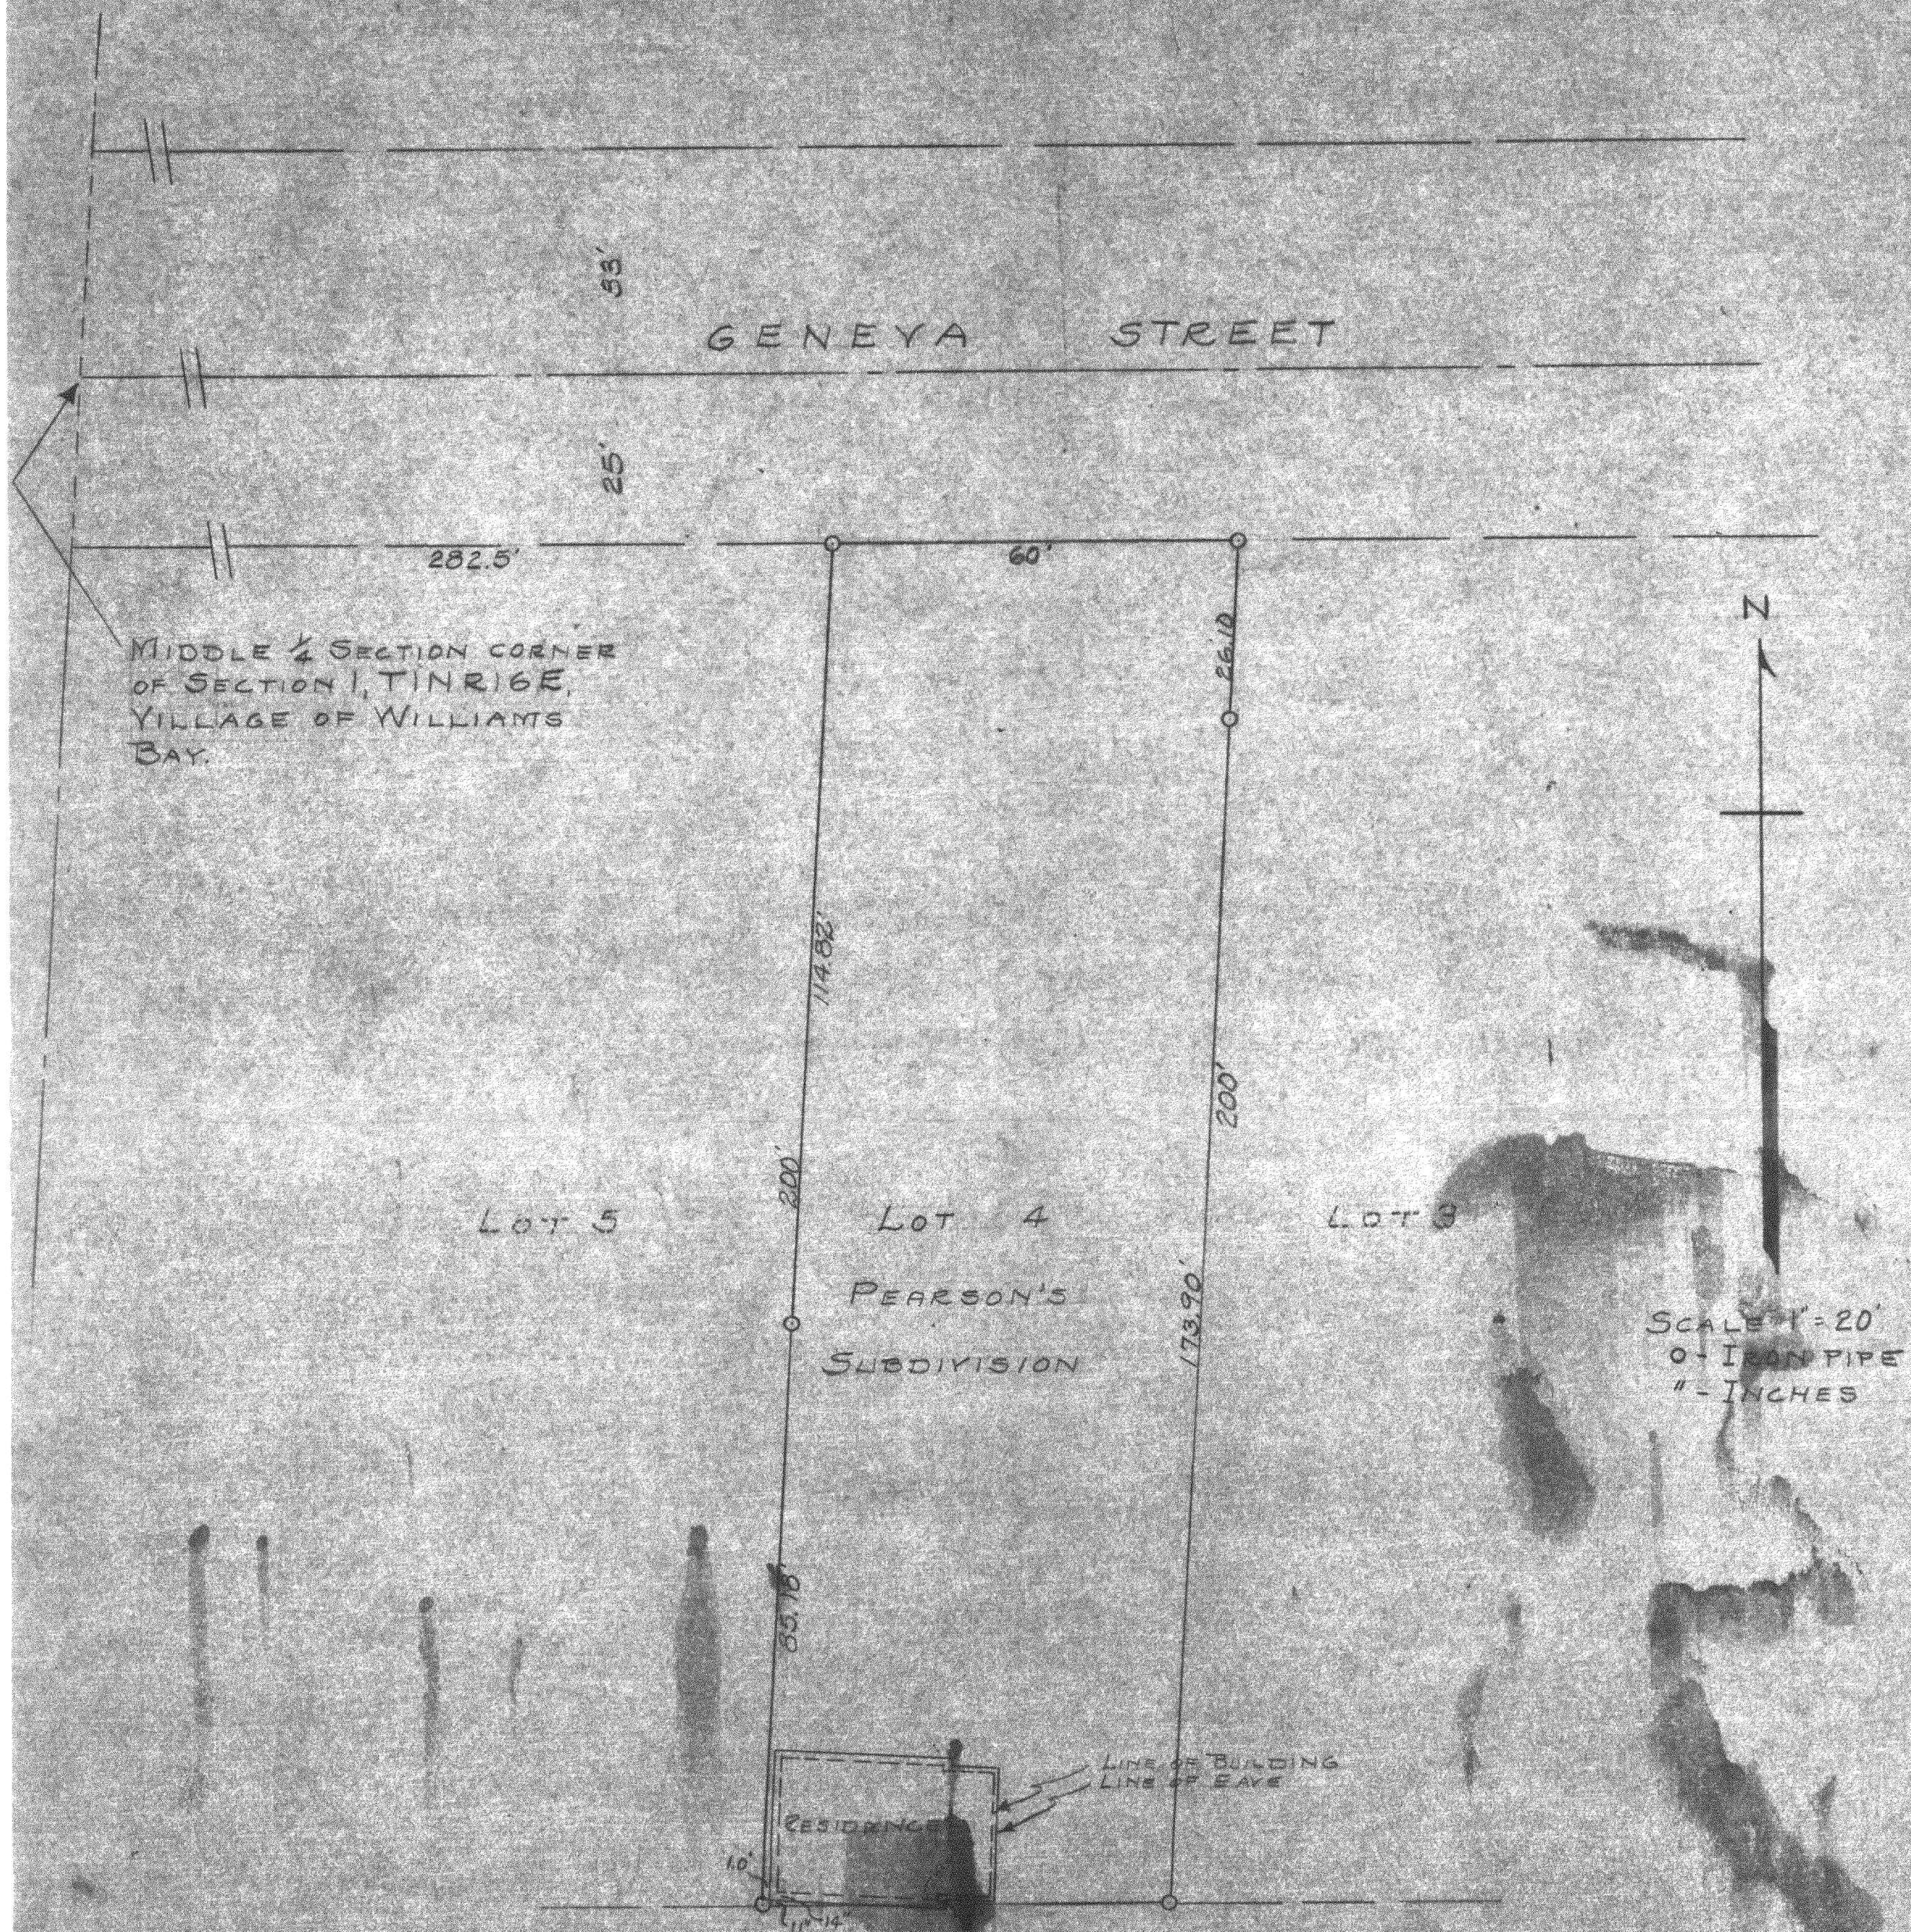

STATE OF WISCONSIN) ss
COUNTY OF WALWORTH)
I, LLOYD L. JENSEN, DO HEREBY CERTIFY THAT I HAVE SURVEYED LOT 4 OF PEARSON'S
SUBDIVISION AND THAT THE PLAT ABOVE IS A CORRECT REPRESENTATION OF ALL LOT AND
BUILDING LINES AND THAT THE RESIDENCE IS LOCATED ENTIRELY WITHIN THE TRUE LOT LINES
OF THE PROPERTY, WITH THE EXCEPTION OF PART OF THE EAVES.
Lloyd L. Jensen