


DUNHAM SURVEYING, S.C.
SURVEYING & SUBDIVIDING
DELAVER, WISCONSIN 53115

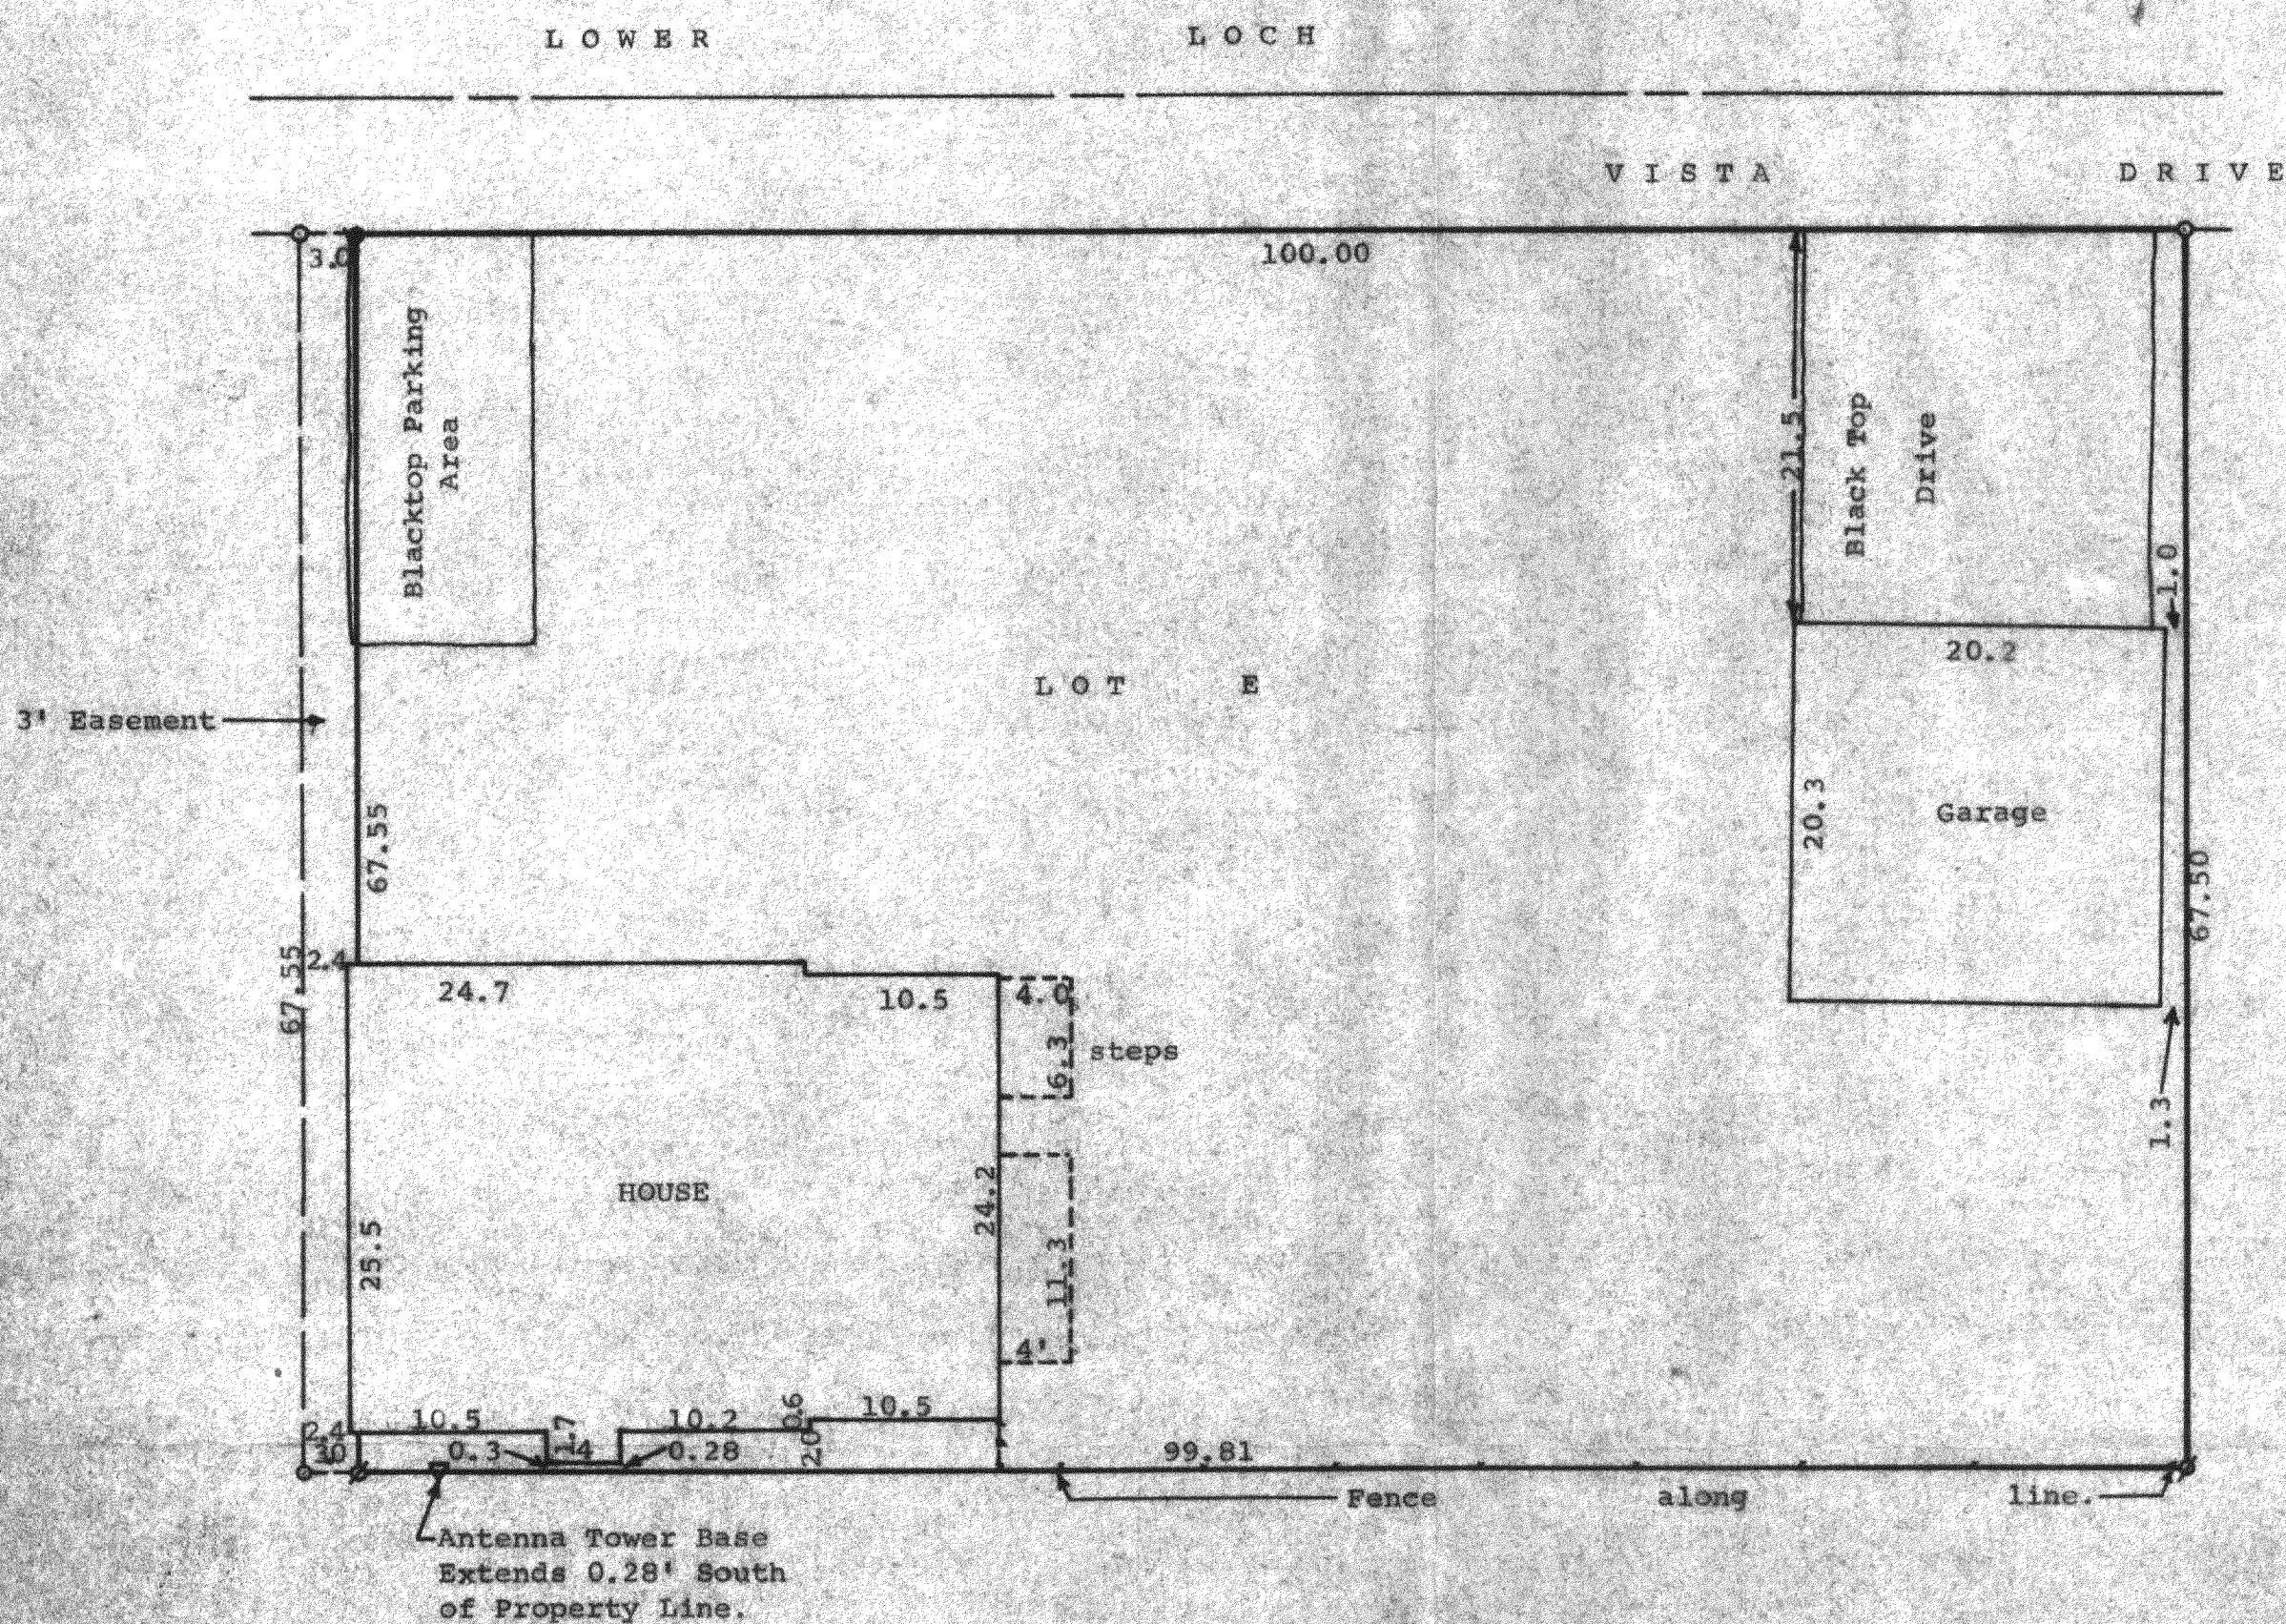

Scale - 1" = 10'
 Ø = Iron Pipe Found
 ○ = Iron Pipe Set
 ● = Iron Rod Found

STATE OF WISCONSIN)
COUNTY OF WALWORTH) SS

I, George T. Dunham, Surveyor, certify that I have surveyed the property described as follows:
 Lot E of Loch Vista Club Subdivision No. 2, a subdivision located in the Village of Williams Bay, Walworth County, Wisconsin, together with an easement over the East three(3) feet of the following described property: Lot F in Loch Vista Subdivision No. 2 in the Village of Williams Bay, Walworth County, Wisconsin. This easement shall remain in effect only so long as the present structure remains on the following described property: Lot E in Loch Vista Subdivision No. 2 in the Village of Williams Bay, Walworth County, Wisconsin. If and when the present structure is torn down, burned down, or, in anyway removed, whether by man or act of God, this easement shall be extinguished automatically without any further action of law.

and that the above map is a true representation thereof and shows the size and location of the property, its exterior boundaries, the location of all visible structures and dimensions of all principal buildings thereon, boundary fences, apparent easements, roadways and visible encroachments, if any. This survey is made for the use of the present owners of the property, and also those who purchase, mortgage, or guarantee the title thereto within one (1) year from date hereof.
 May 13, 1980

George T. Dunham
George T. Dunham, Surveyor

