


DUNHAM SURVEYING, S.C.
SURVEYING & SUBDIVIDING
DELAVAN, WISCONSIN 53115

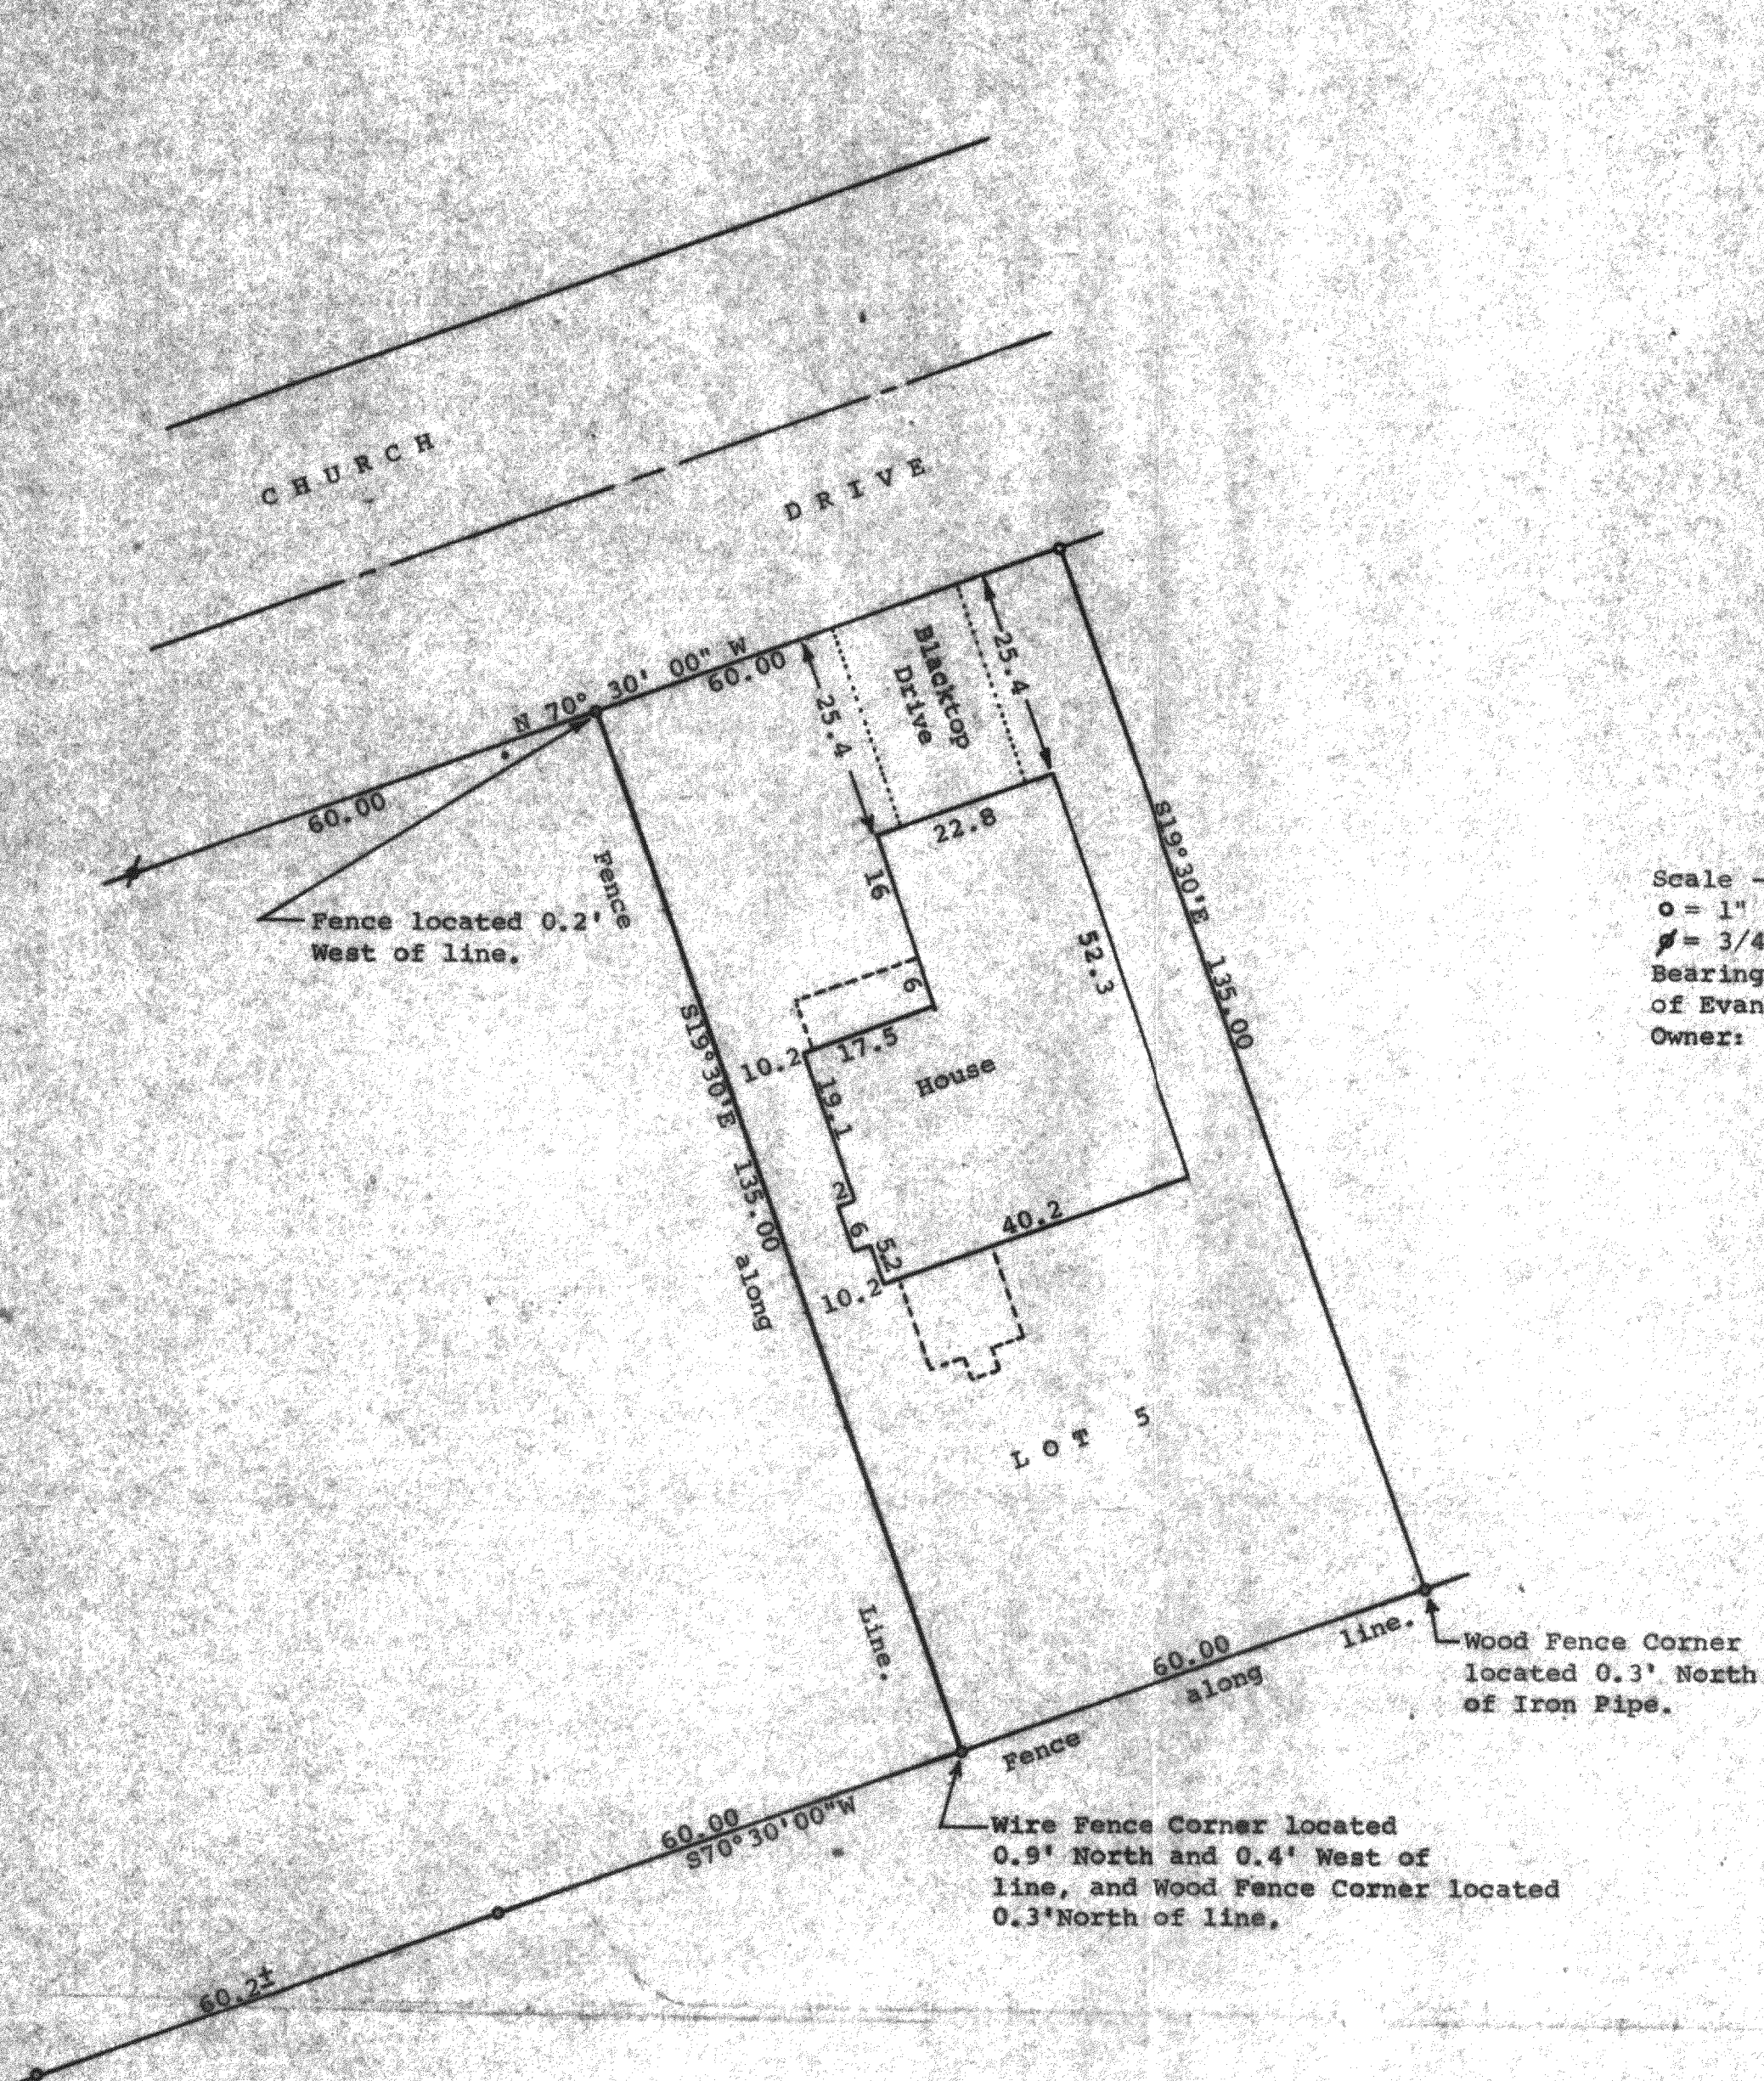

Scale - 1" = 20'
○ = 1" Iron Pipe Found
⊙ = 3/4" Iron Pipe Found
Bearings shown are those on the recorded plat
of Evangelical Free Church Subdivision
Owner: Marie Redpath
513 Free Church Drive
Williams Bay, WI 53191

STATE OF WISCONSIN) SS
COUNTY OF WALWORTH)

I, Richard C. Schulz, Surveyor, certify that I have surveyed
the property described as follows,

Lot 5, Evangelical Free Church Subdivision, located in the
Village of Williams Bay, Walworth County, Wisconsin,
and that the map shown hereon is a true representation thereof and shows
the size and location of the property, its exterior boundaries, the
location of all visible structures and dimensions of all principal
buildings thereon, boundary fences, apparent easements, roadways and
visible encroachments, if any, and that I have surveyed the property
hereon described according to the official records, to the best of
my knowledge and belief.
June 27, 1984.

Richard C. Schulz
Richard C. Schulz, Surveyor

