WALWORTH COUNTY
SURVEYING & MAPPING
LAKE GENEVA, WISCONSIN

RECEIVED
SEP 26 1986

SPRING STREET

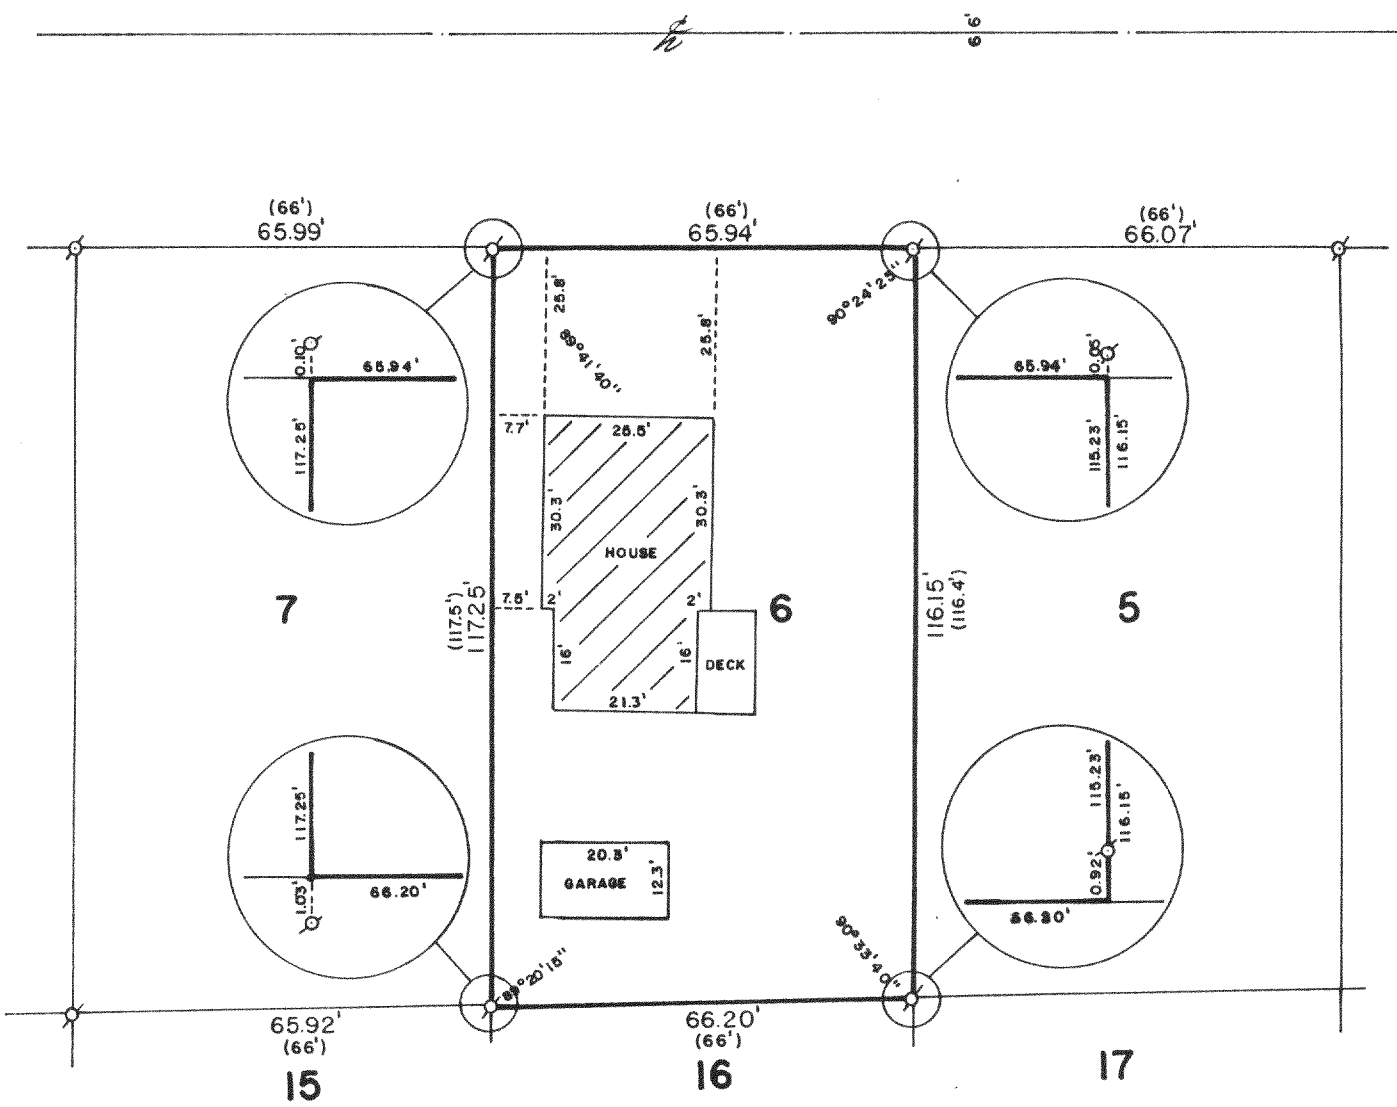

WISCONSIN
ROBERT M.
BAERENWALD
Lake Geneva, WI.
S-1508
LAND SURVEYOR

PLAT OF SURVEY OF

LOT 6 OF JOHNSON'S ADDITION TO THE VILLAGE OF WILLIAMS BAY, WALWORTH COUNTY, WISCONSIN.

ORDERED BY: GENEVA LAKEFRONT REALTY
50 WEST GENEVA STREET
WILLIAMS BAY, WISCONSIN 53191

SCALE: 1"=30'

ø -IRON PIPE FOUND
() -RECORDED AS

I, ROBERT M. BAERENWALD, DO HEREBY CERTIFY THAT I HAVE SURVEYED THE PROPERTY HEREON DESCRIBED ACCORDING TO THE OFFICIAL RECORDS AND THAT THE PLAT HEREON IS A CORRECT REPRESENTATION OF THE PROPERTY LINES TO THE BEST OF MY KNOWLEDGE AND BELIEF.

Robert M. Baerenwald
ROBERT M. BAERENWALD
WISCONSIN REGISTERED LAND SURVEYOR, S-1508

DATE July 12, 1986 JOB NO. 0630

WJA-5

11-506