ABELL
SURVEYING & MAPPING
DELAVAN, WISCONSIN 53115
414-728-6737

RECEIVED
JAN 2 5 1994

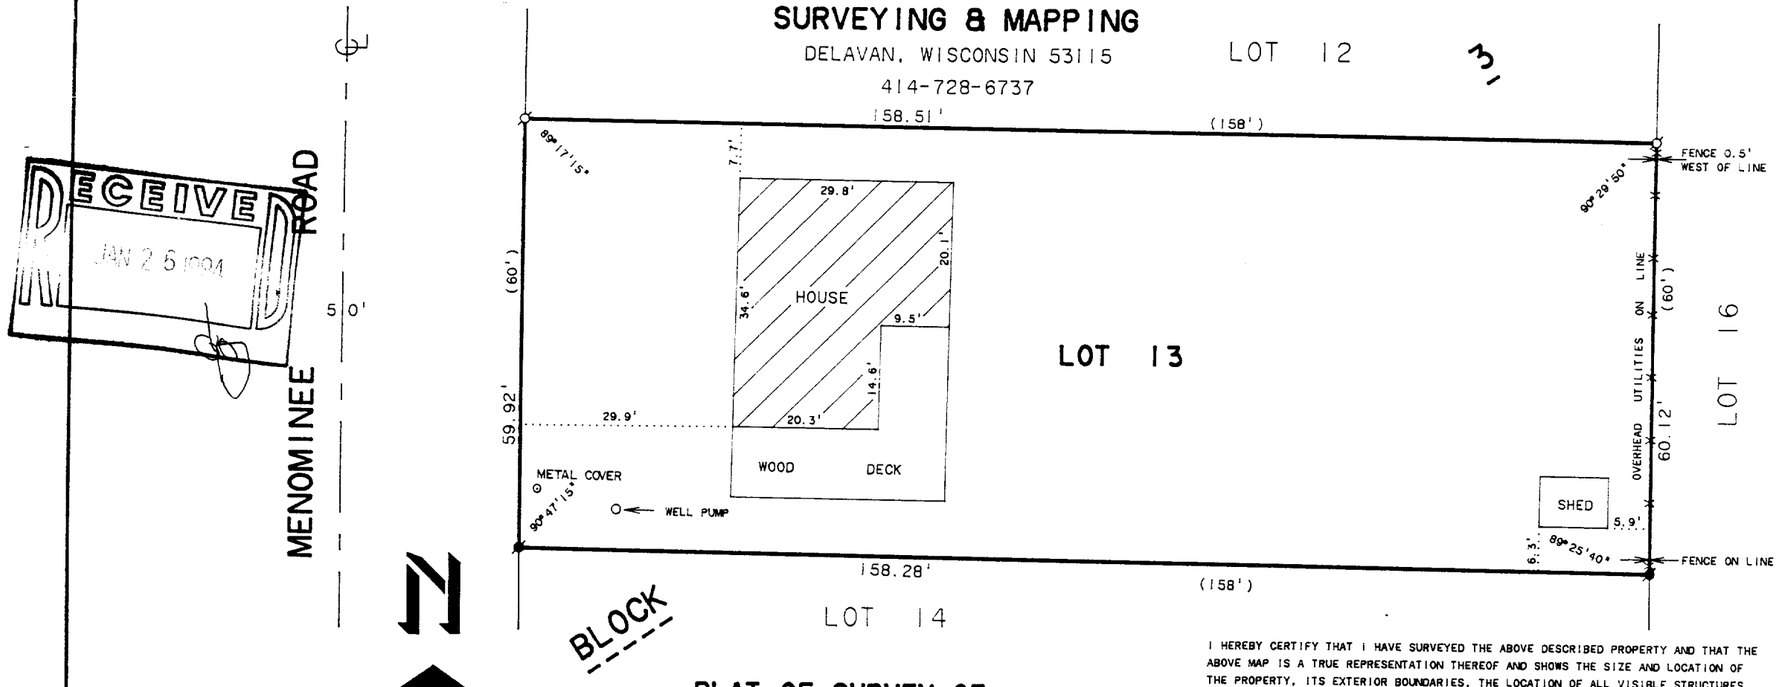

SCALE 1"=20'

LEGEND

- ⌀ - IRON PIPE FOUND
- ● - IRON ROD FOUND
- -x-x- - WIRE FENCE
- ( )-RECORDED AS

PLAT OF SURVEY OF

LOT 13, BLOCK 3, HARBOR VIEW SUBDIVISION, LOCATED IN THE VILLAGE OF WILLIAMS BAY, WALWORTH COUNTY, WISCONSIN.

REVISED: 12/15/93
ORDERED BY: CENTURY 21 - ASSURED REALTY
P.O. BOX 367
WILLIAMS BAY, WI 53191

I HEREBY CERTIFY THAT I HAVE SURVEYED THE ABOVE DESCRIBED PROPERTY AND THAT THE ABOVE MAP IS A TRUE REPRESENTATION THEREOF AND SHOWS THE SIZE AND LOCATION OF THE PROPERTY, ITS EXTERIOR BOUNDARIES, THE LOCATION OF ALL VISIBLE STRUCTURES AND DIMENSIONS OF ALL PRINCIPAL BUILDINGS THEREON, BOUNDARY FENCES, APPARENT EASEMENTS, ROADWAYS AND VISIBLE ENCROACHMENTS, IF ANY, TO THE BEST OF MY KNOWLEDGE AND BELIEF.

THIS SURVEY IS MADE FOR THE USE OF THE PRESENT OWNERS OF THE PROPERTY, AND ALSO THOSE WHO PURCHASE, MORTGAGE, OR GUARANTEE THE TITLE THERETO WITHIN ONE (1) YEAR FROM DATE HEREOF.

David F. Abell
DAVID F. ABELL
WISCONSIN REGISTERED LAND SURVEYOR, S-1596

December 5, 1991 REVISED: 12/15/93
DATE JOB NUMBER - 91257

NOTE: THIS IS NOT A CERTIFIED COPY UNLESS SEALED.

WHV-43

11-1033