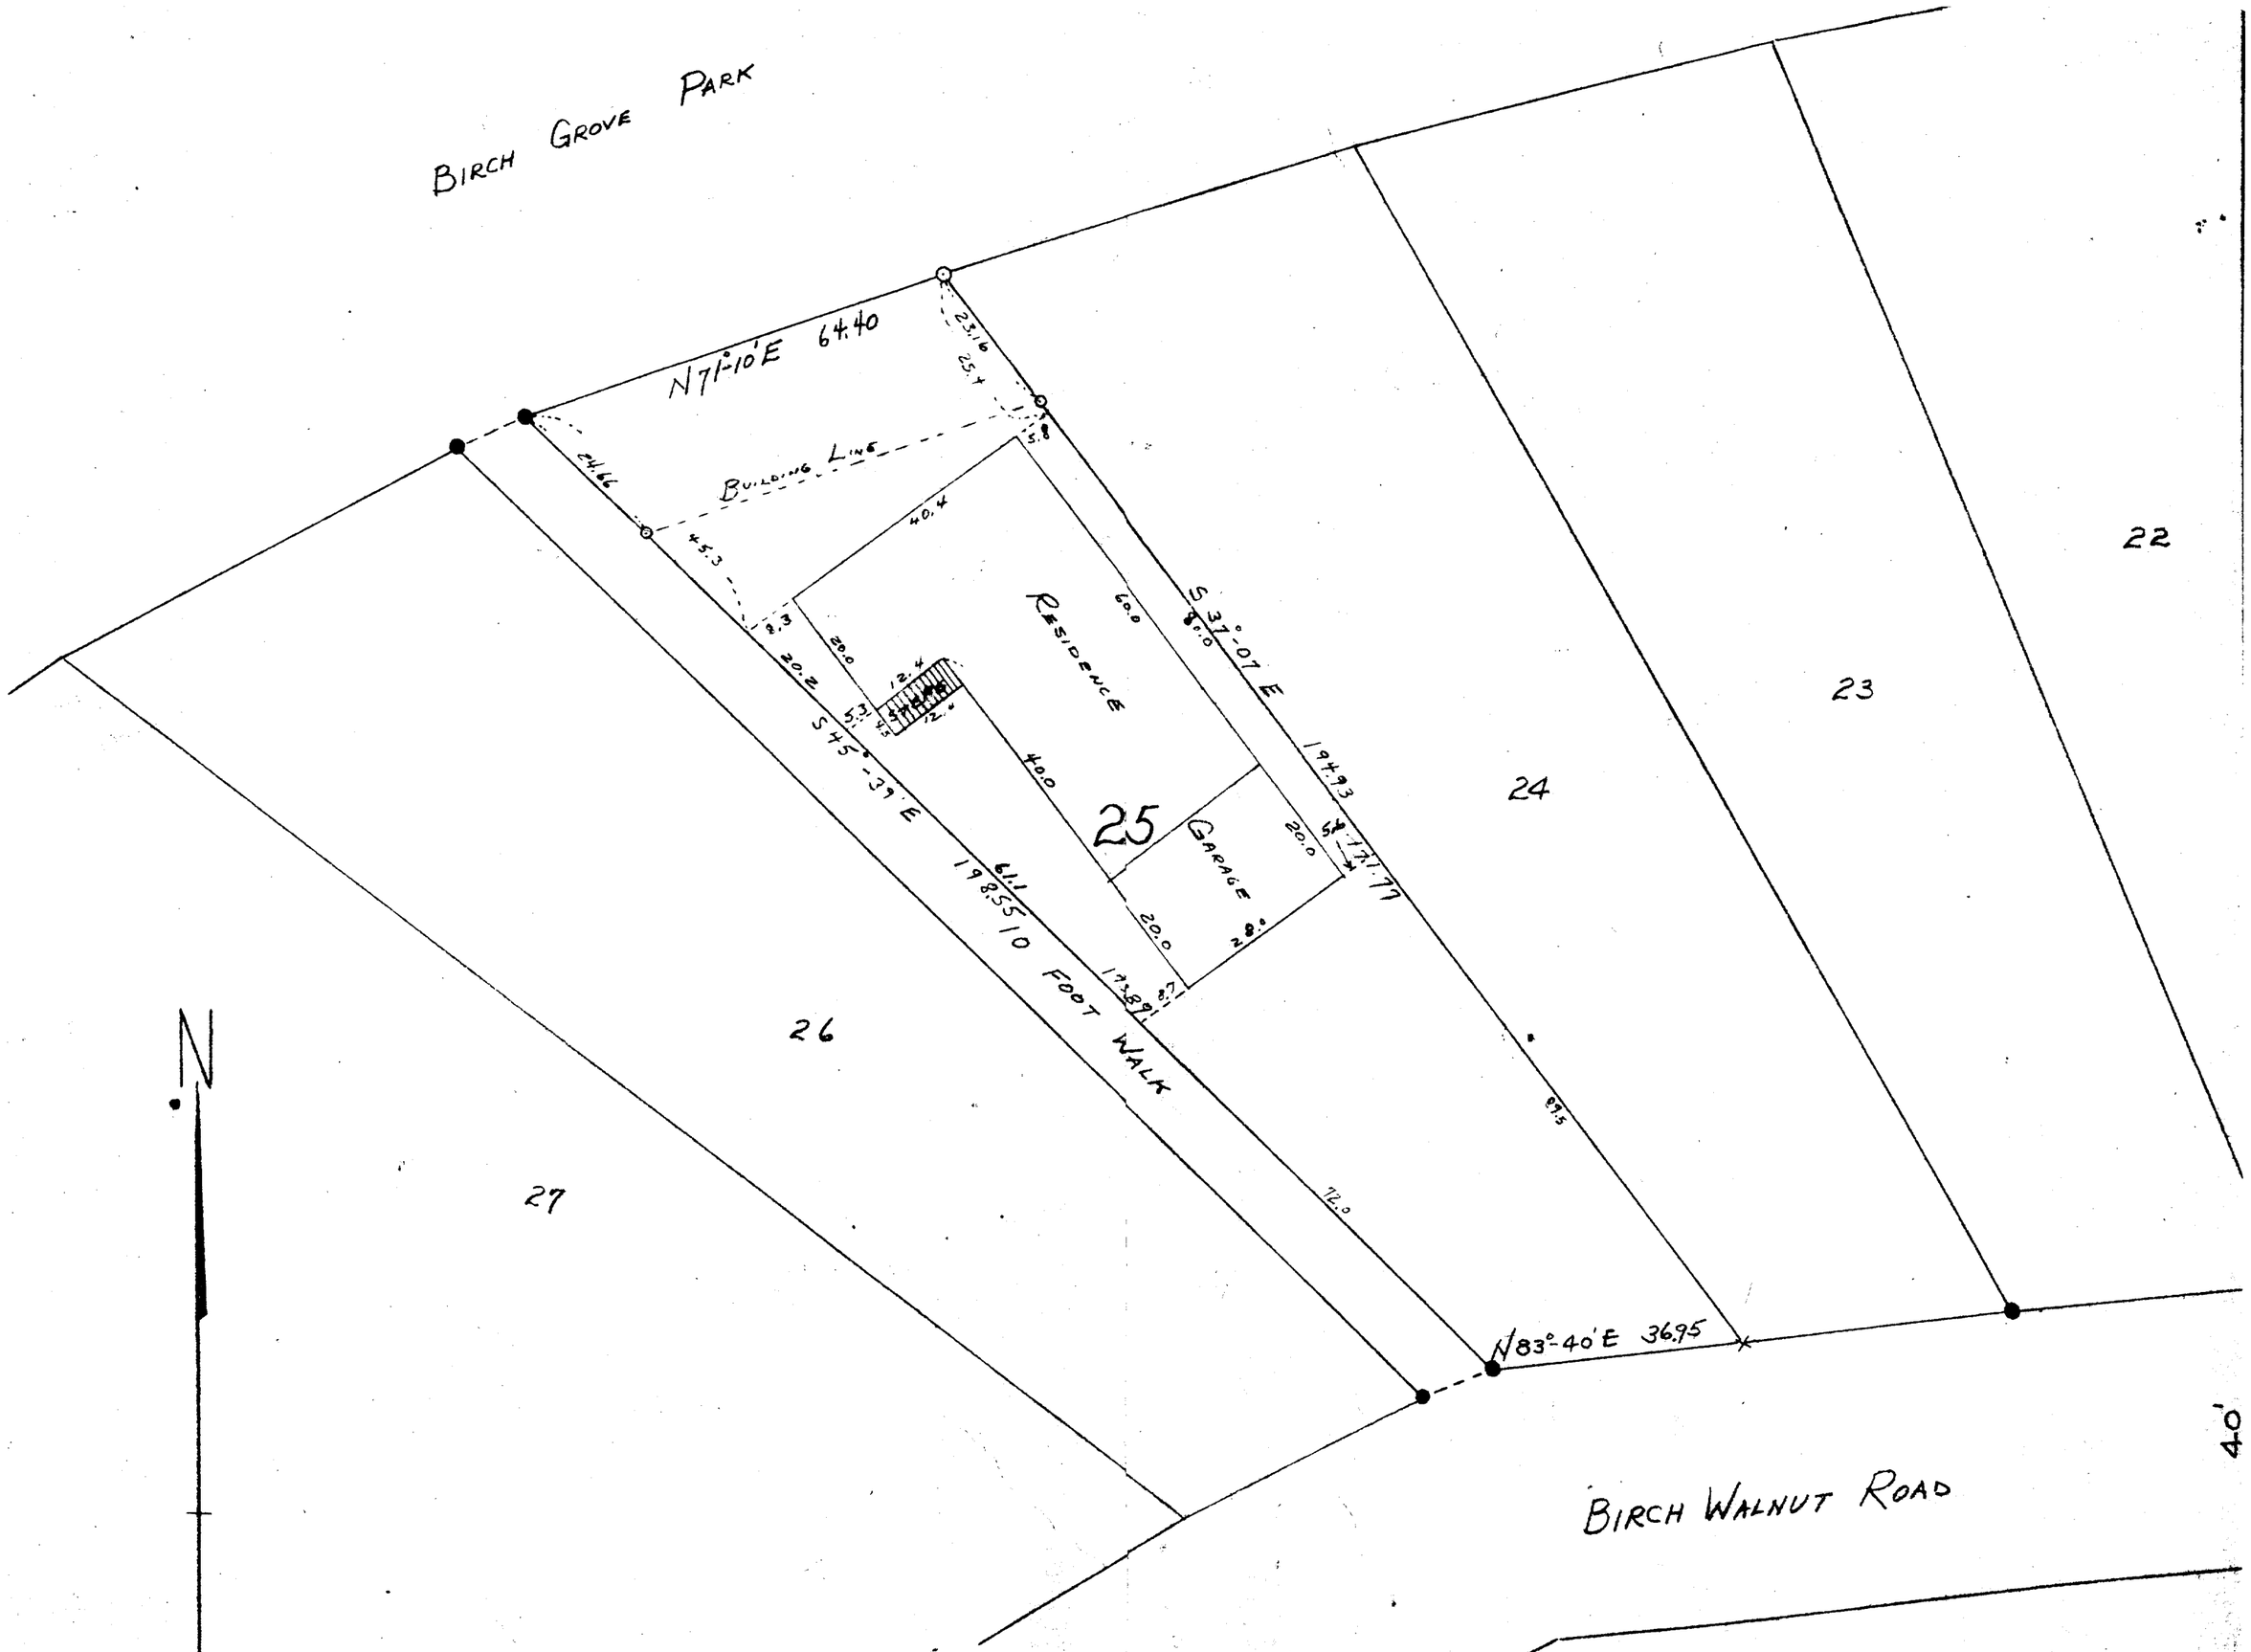

X — SPIKE IN ROOT OF 20" BLACK OAK

O — IRON PIPE

● — CONCRETE MONUMENT

STATE OF WISCONSIN }
COUNTY OF WALWORTH }

I, LLOYD L. JENSEN, DO HEREBY CERTIFY THAT I HAVE SURVEYED THE PROPERTY DESCRIBED HEREON ACCORDING TO THE OFFICIAL RECORDS AND THAT THE PLAT HEREON IS A CORRECT REPRESENTATION OF THE LOT LINES AND PRINCIPAL LINES OF BUILDINGS THEREON.

ELKHORN, WISCONSIN APRIL 7, 1956

SURVEYOR

PLAT OF SURVEY
OF
LOT 25
OF THE FIRST ADDITION TO
CEDAR POINT PARK
LOCATED IN THE
VILLAGE OF WILLIAMS BAY
WALWORTH COUNTY, WISCONSIN

Lloyd L. J

SCALE 1" = 20'

DATE JANUARY 19

WCP1-26

11-120J