DUNHAM SURVEYING, S. C.
*SURVEYING & SUBDIVIDING*
DELAVAN, WISCONSIN 53115

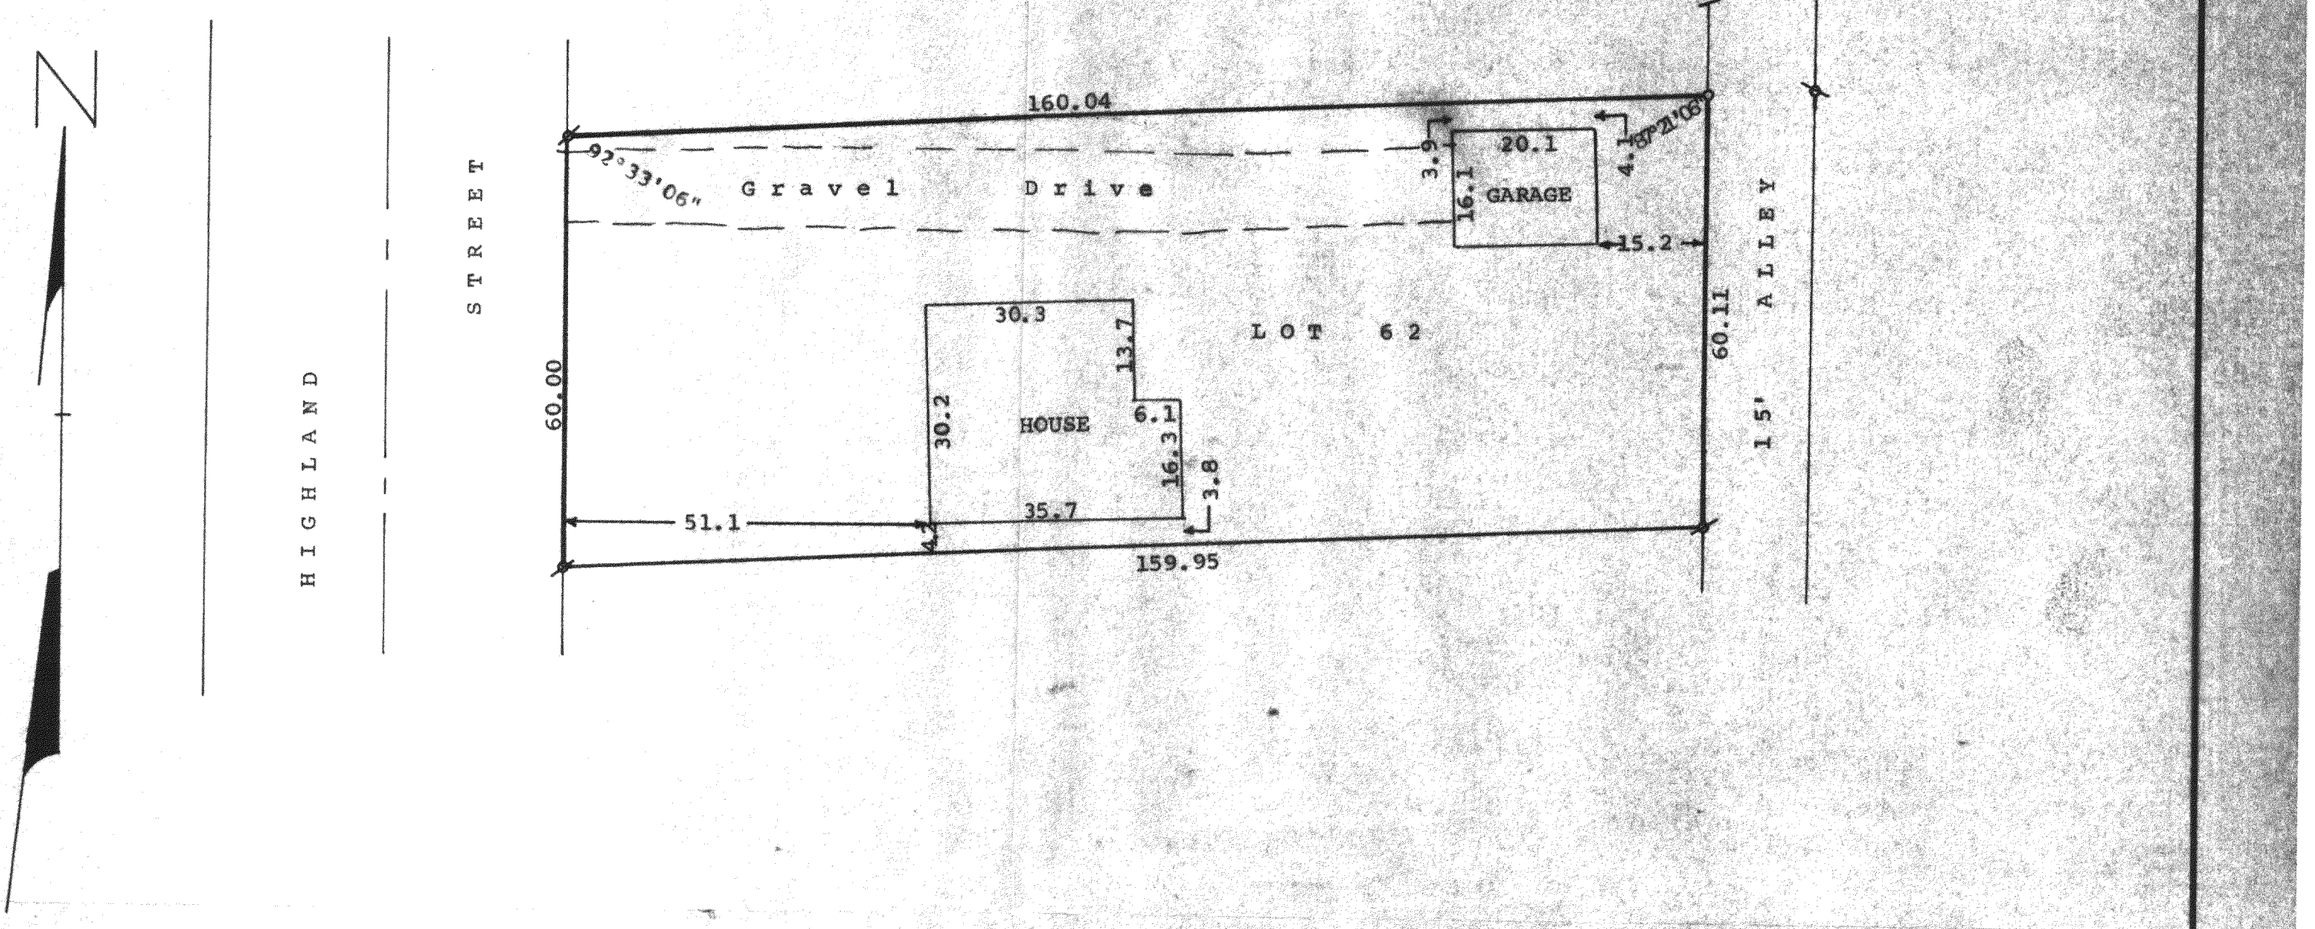


Scale - 1" = 20'
ø = Iron Pipe Found
o = Iron Pipe Set
Updating and recertification ordered by:
Keefe Real Estate
Lake Geneva, WI 53147

STATE OF WISCONSIN)
COUNTY OF WALWORTH) SS

I, James M. Dunham, Surveyor, certify that I have surveyed the property described as follows,

Lot 62 of Bay View Subdivision, located in the Village of Williams Bay, Walworth County, Wisconsin,

and that the above map is a true representation thereof and shows the size and location of the property, its exterior boundaries, the location of all visible structures and dimensions of all principal buildings thereon, boundary fences, apparent easements, roadways and visible encroachments, if any.

This survey is made for the use of the present owners of the property, and also those who purchase, mortgage, or guarantee the title thereto within one (1) year from date hereof.

August 11, 1981
Updated and recertified to
August 20, 2001

George T. Dunham, Surveyor

James M. Dunham, Surveyor

RECEIVED
MAY 9 2003

WISCONSIN LAND SURVEYOR
GEORGE T. DUNHAM
S-306
DELAVAN WIS.

WBV-34

K & E 10-8125

011-1728