PREPARED FOR
PAT HAGMAN
5059 CROFTON DR.
ROCKFORD IL. 61114

PLAT OF SURVEY

- OF -

LOT 16 OF CEDAR POINT PARK FIRST ADDTION LOCATED IN SECTION 6, TOWN 1 NORTH, RANGE 17 EAST, VILLAGE OF WILLIAMS BAY, WALWORTH COUNTY, WISCONSIN.

KROTT SURVEYING INC.
N3705 WILLOW BEND LANE
LAKE GENEVA WI. 53147
PHONE # (262)248-3697
FAX # (262)249-0639

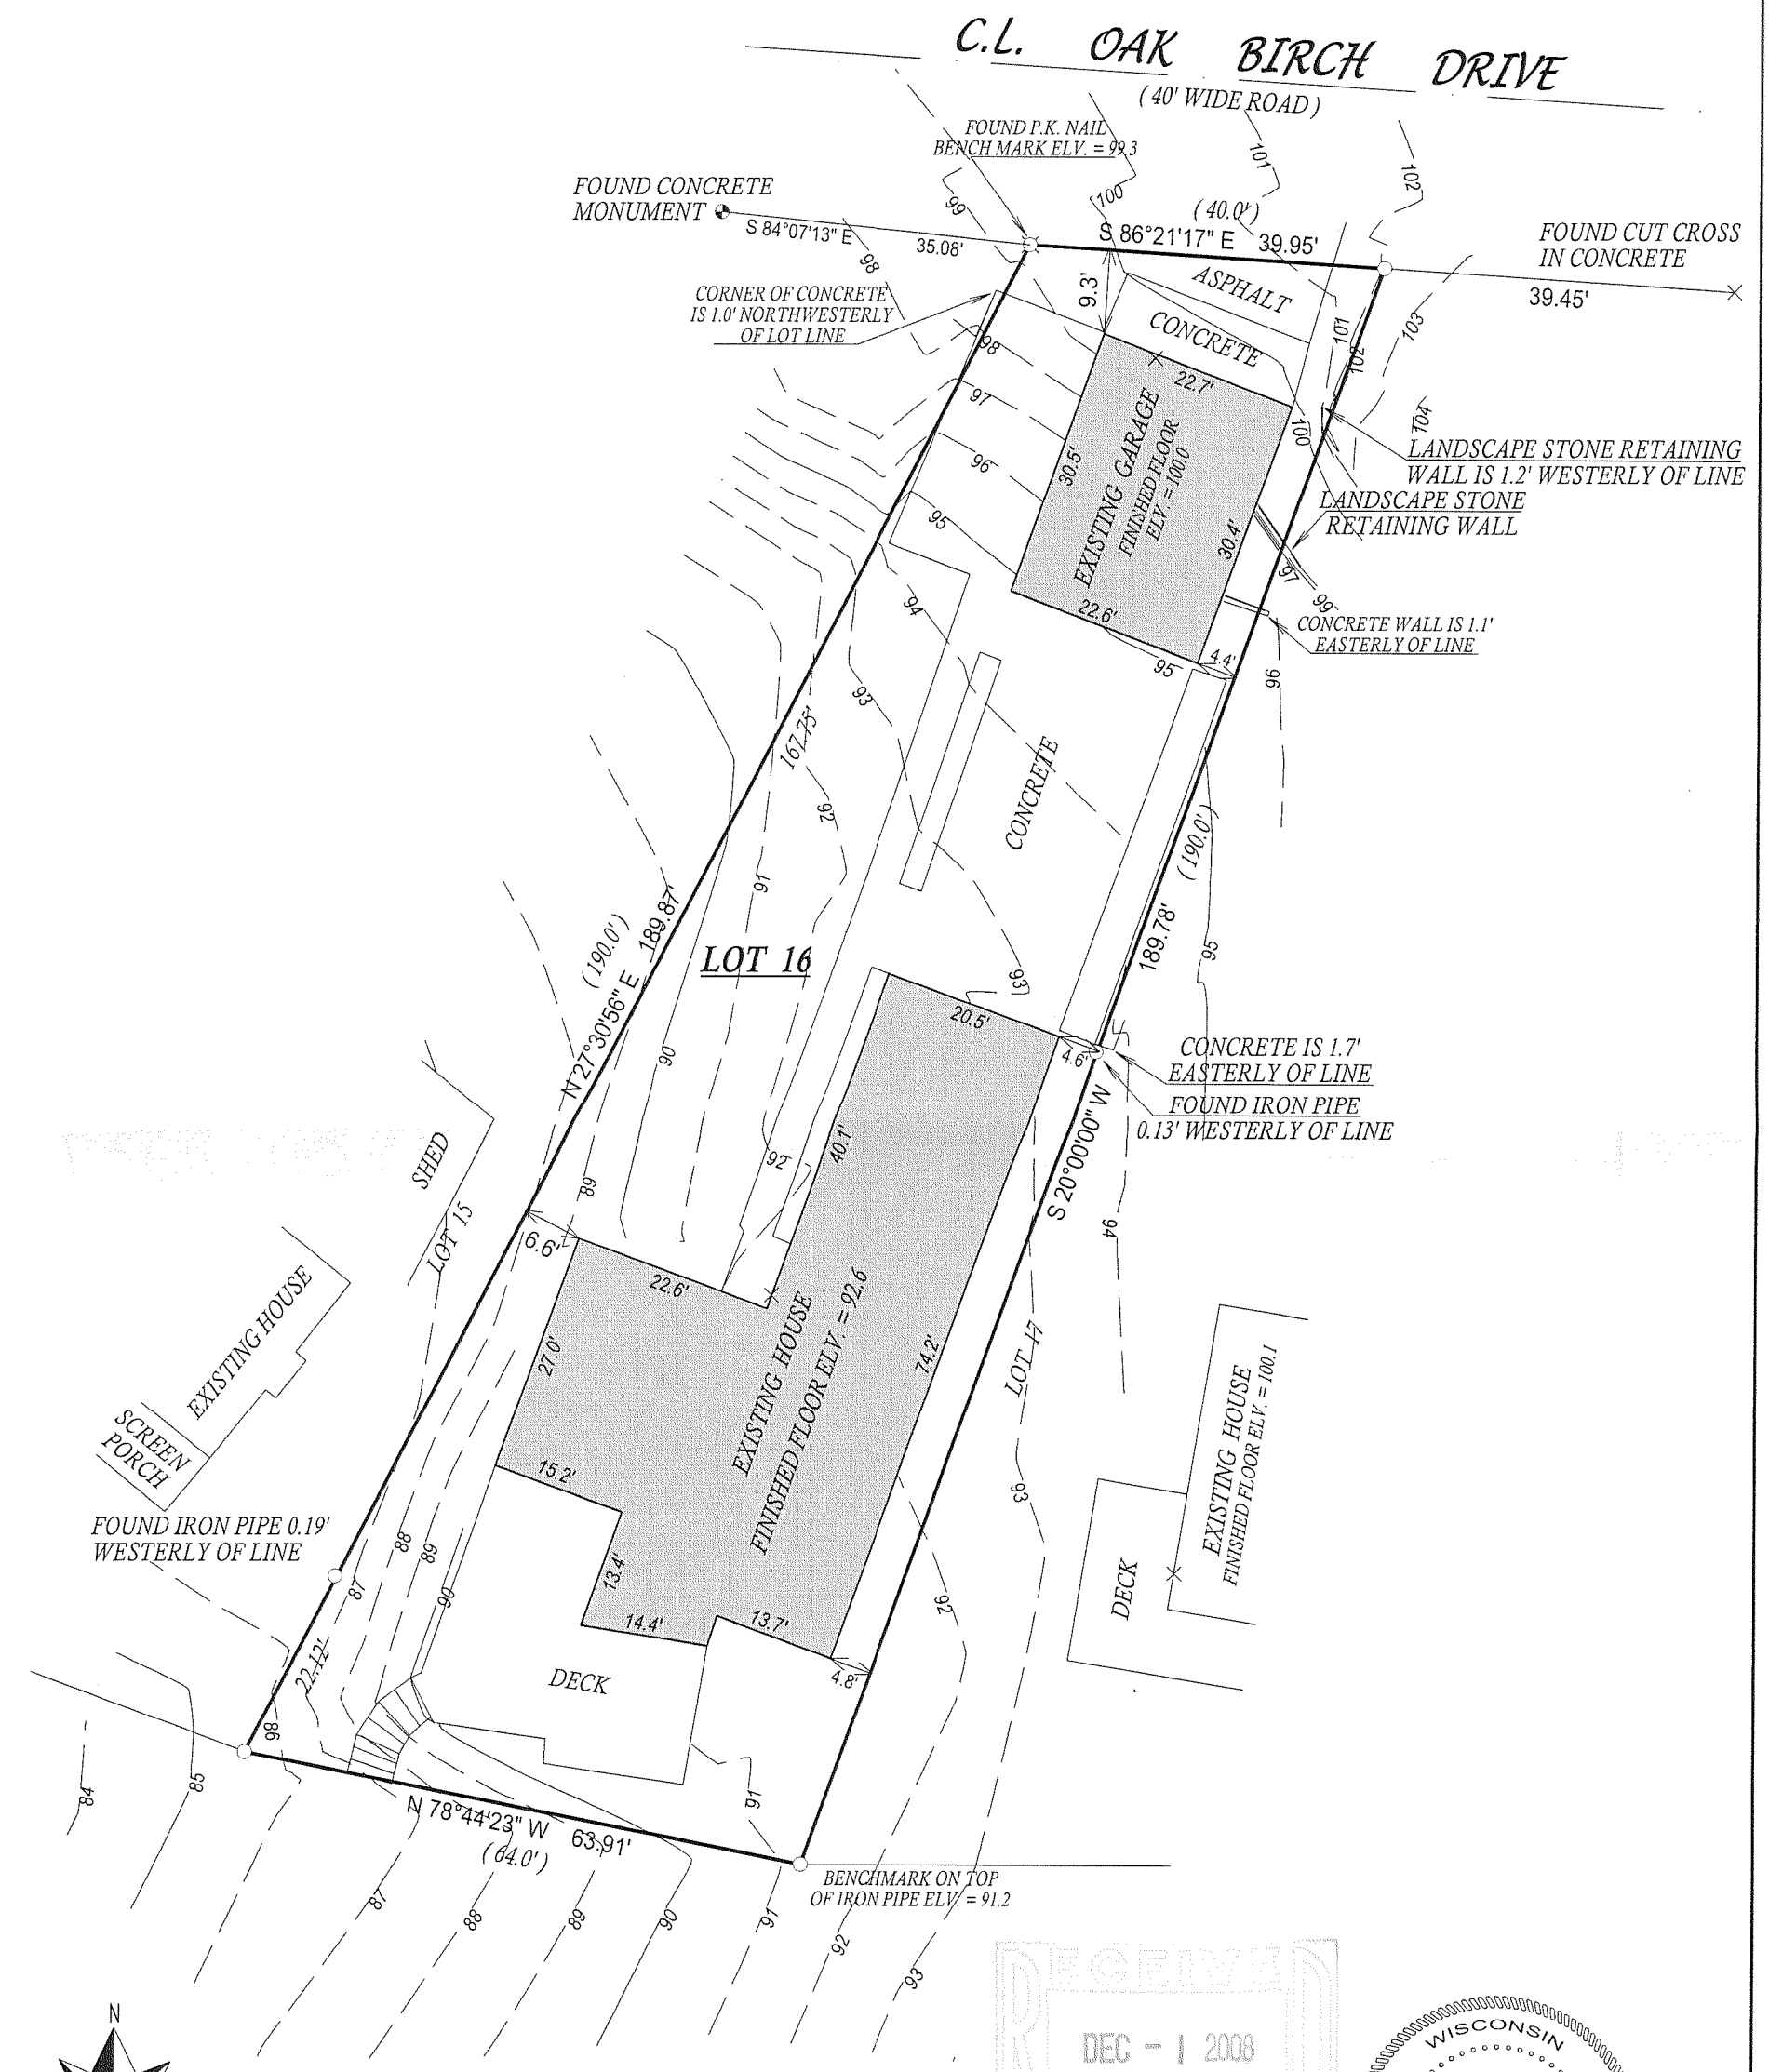

RECEIVED
DEC - 1 2008

WISCONSIN
JOHN P.
KROTT
S-2258
LAKE GENEVA
WIS.
LAND SURVEYOR

SCALE 1" = 20' NOTE : BEARINGS ARE ASSUMED

0 20 40 60

COMPARE LEGAL DESCRIPTION ABOVE AND DRAWING WITH DEED. FOR BUILDING RESTRICTIONS AND EASEMENTS NOT SHOWN,REFER TO DEED, ABSTRACT SOURCES AND LOCAL MUNICIPAL CODES. NOTIFY THE SURVEYOR IMMEDIATELY OF ANY DISCREPANCY.

"I hereby certify that I have surveyed the above described property and that the above map is a true representation thereof and shows the size and location of all visible structures, apparent easements and encroachments if any."
This survey is made for the present owners of the property, and those who purchase, mortgage, or guarentee the title thereto, within one year from the date hereof.

LEGEND

○ FOUND IRON PIPE

× FINISHED FLOOR ELV. SHOT

(XX) RECORDED AS

JOB # 06-335 TAX ID # WCP100014

DATED THIS THE 26th DAY OF SEPTEMBER 2008.

JOHN KROTT S - 2258
Wisconsin Registered Land Surveyor
(original if signed in red)

011-2237