

Property Exhibit

of Topographic Data

on

A parcel of land described in Schedule A of Commitment No. SEWT-91860 dated March 19, 2003, issued by Southeastern Wisconsin Title Company, Inc., as shown below:


Part of Lots 2 and 3 of Cedar Point Subdivision in Sections 5 and 6, Township 1 North, Range 17 East of the Fourth Principal Meridian, Village of Williams Bay, Walworth County, Wisconsin, described as follows: a strip of land 51.38 feet wide off of the entire Westerly side of said Lot 2, and Lot 3, except a strip of land 25.69 feet wide off of the entire Westerly side of said Lot 3.

Tax Key No. WCP4 00002



The above mentioned Commitment No. SEWT-91860 dated March 19, 2003, issued by Southeastern Wisconsin Title Company, Inc. lists the following easements and restrictions:

16. Agreement recorded in Volume 329 of Mortgages, Page 405, Document No. 471512. Shown
17. Agreement recorded in Volume 491 of Deeds, Page 495, Document No. 476863. Shown
19. Easement recorded in Volume 460 of Records, Page 375, Document No. 179650. Shown

Surveyed for: **Mark & Patty Aschliman**
5827 North Mattland Court
Whitfish Bay, Wisconsin. 53217

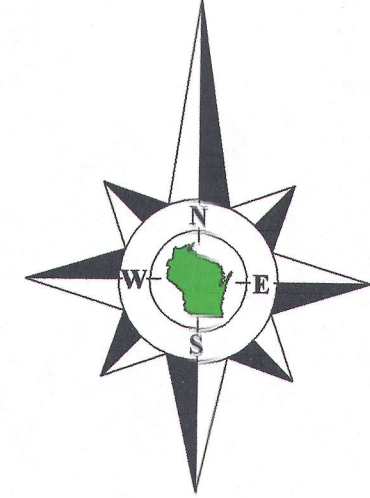

Bearings reference to Certified Survey Map No. 2863.

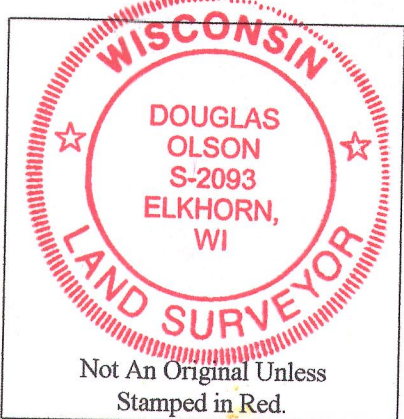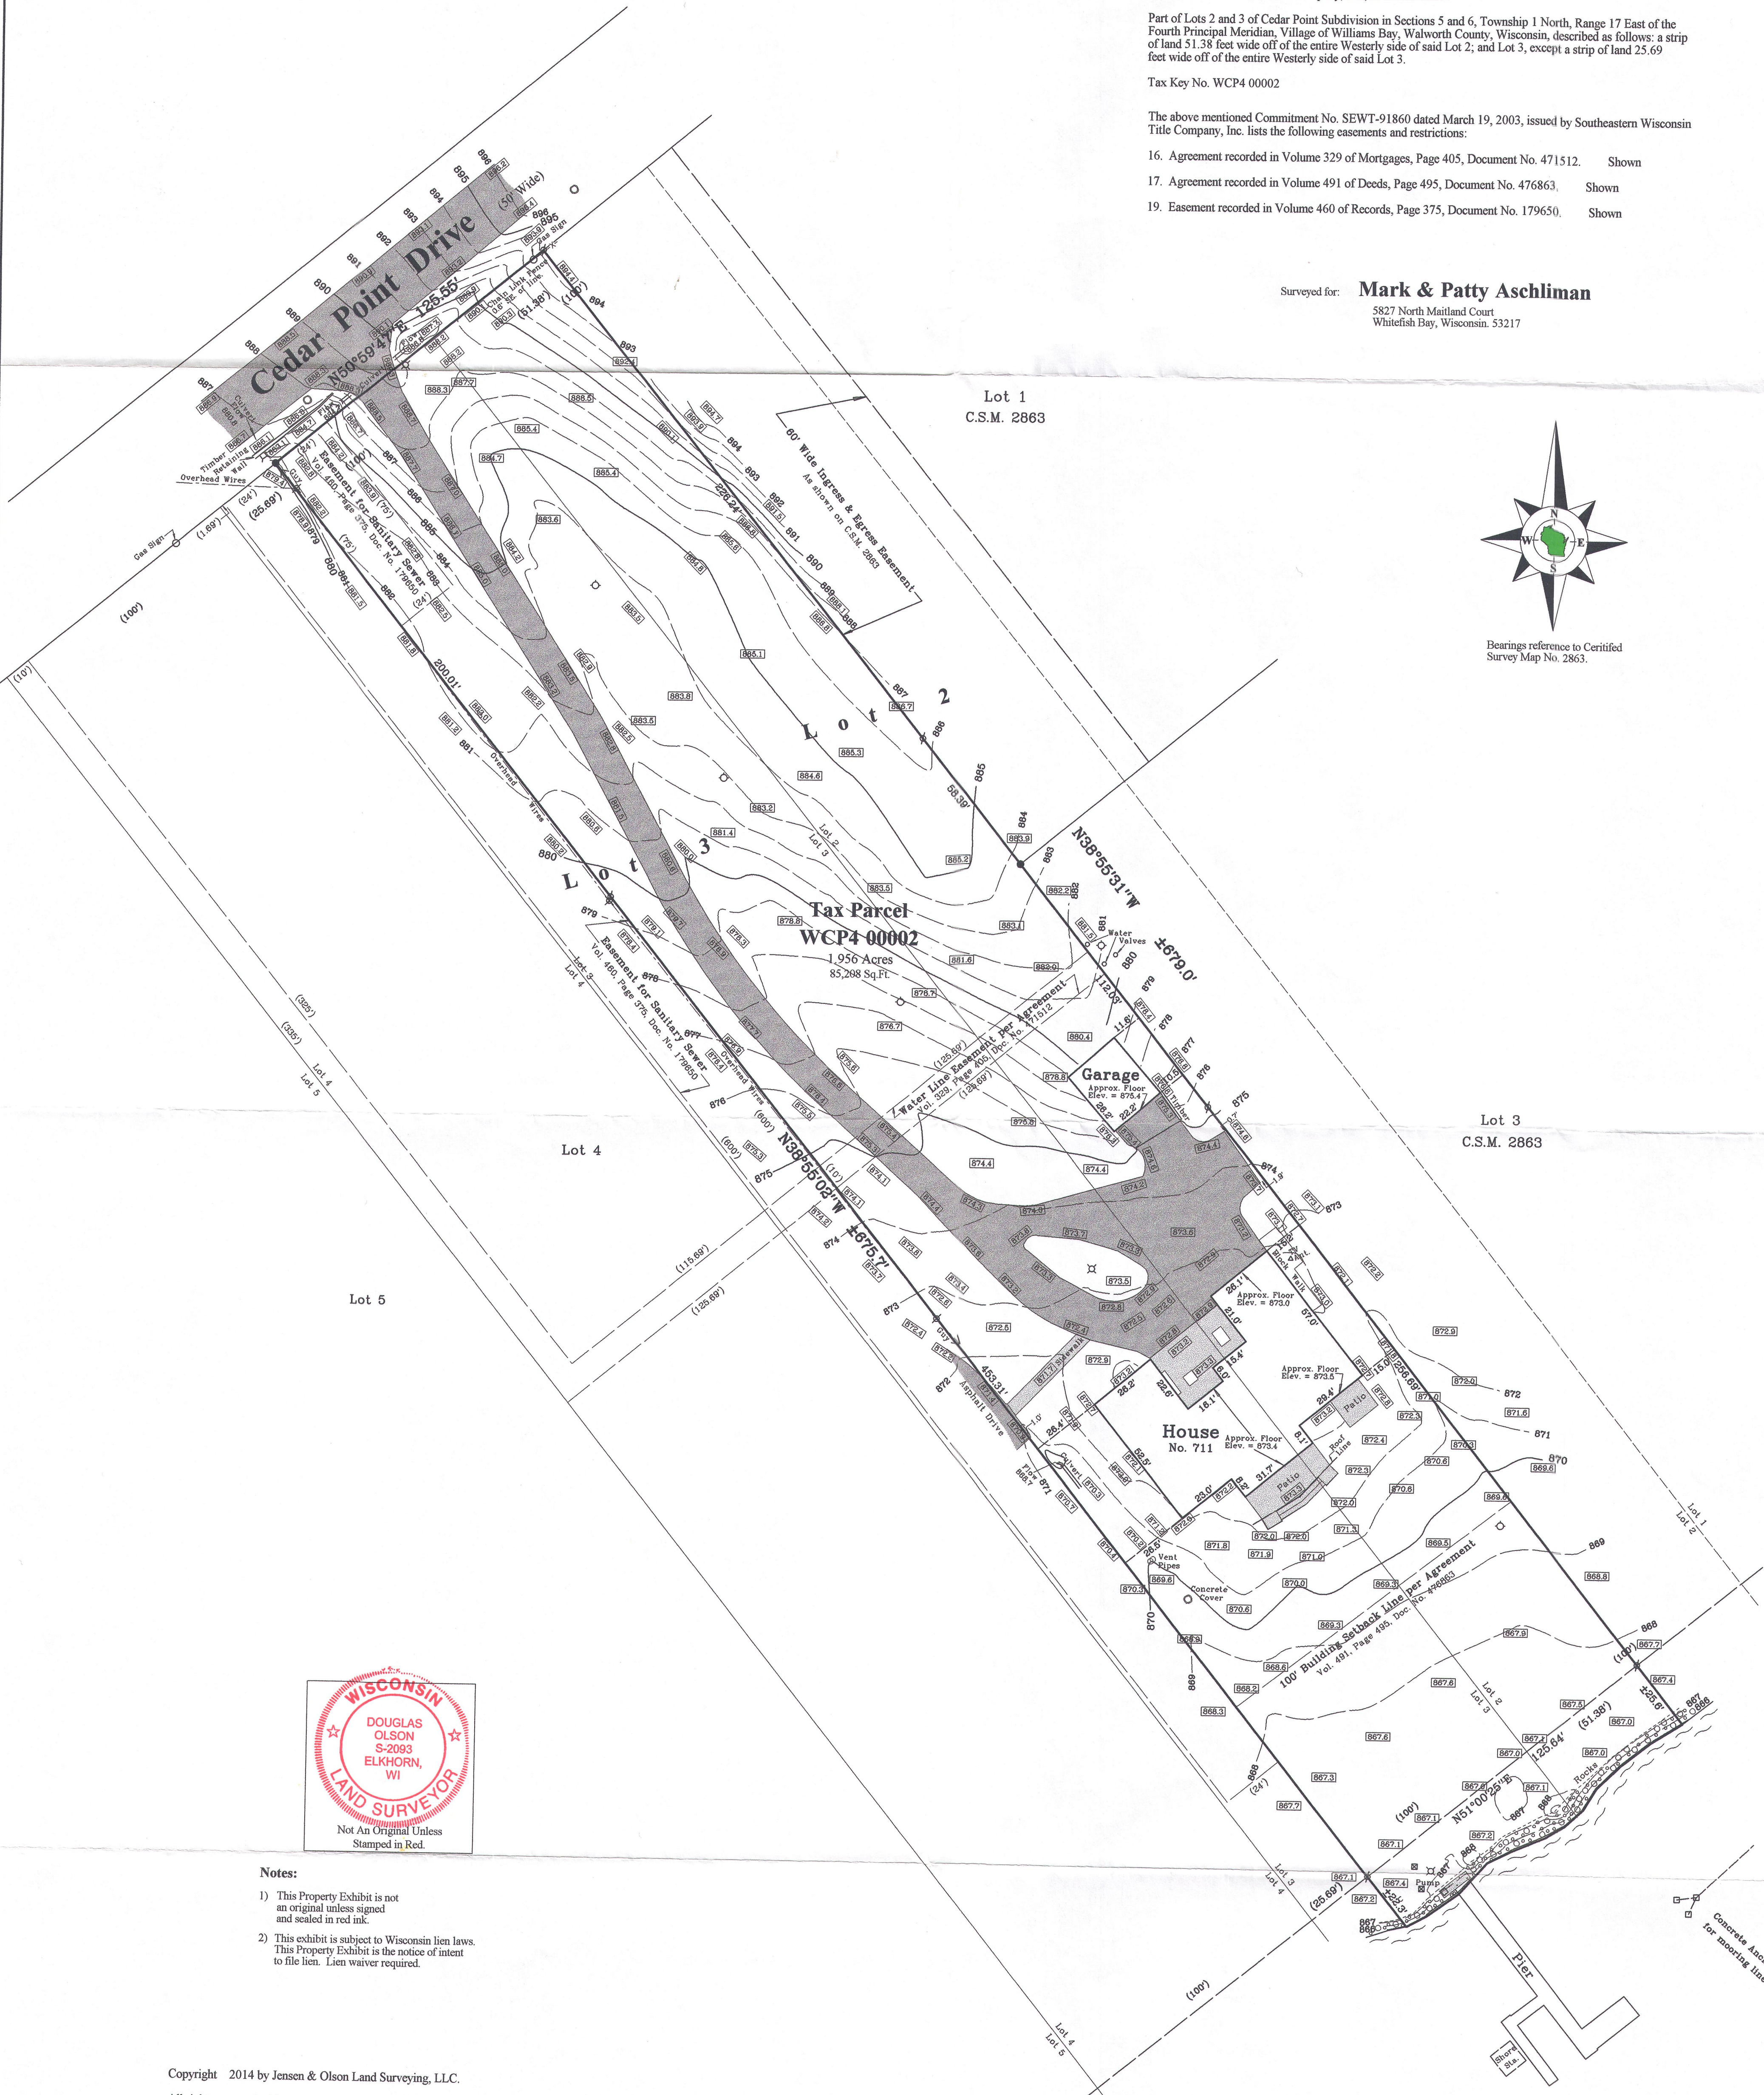

Notes:


- 1) This Property Exhibit is not an original unless signed and sealed in red ink.
- 2) This exhibit is subject to Wisconsin lien laws. This Property Exhibit is the notice of intent to file lien. Lien waiver required.

Copyright 2014 by Jensen & Olson Land Surveying, LLC.

All rights reserved. No part of this survey plat may be reproduced or transmitted in any form by any means - graphic, electronic, or mechanical, including photocopying, tracing, or information storage and retrieval systems - without permission in writing from Douglas G. Olson, Jensen & Olson Land Surveying, LLC.

I, Douglas G. Olson, Wisconsin Registered Land Surveyor, do hereby certify that this survey was performed by me, or under my direction in full compliance with the owner's/agent's instructions and, Chapter A-E 7 of the Wisconsin Administrative Code "Minimum Standards for Property Surveys", and that this map is an accurate representation thereof to the best of my knowledge and belief.

Douglas G. Olson
Wisconsin Registered Land Surveyor - 2093

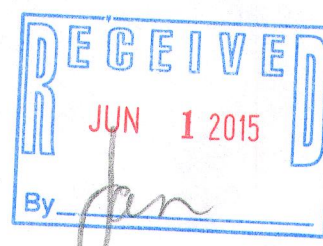

Geneva

Lake

Approximate Water Elevation
June 9, 2014 864.8

Sheet 1 of 1 Sheets

Drawing Name: 11m17e-2014051-2014051Exhibit.caj

Job Reference Number
2014.051

Legend

- Found Iron Pipe
- Found Iron Rod
- () Recorded Information
- ⊗ Utility Pole
- Hydrant
- Manhole or Cover
- Spigot
- ⊗ Lamp
- ▨ Asphalt Surface
- ▨ Concrete Surface




Jensen & Olson Land Surveying, LLC

45 South Wisconsin Street * P.O. Box 322 * Elkhorn, Wisconsin. 53121
Telephone: (262) 723-3434 * Facsimile: (262) 723-8044
Email: jensen.olson@elknet.net

Scale in Feet

1" = 30'

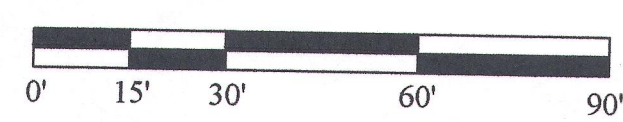

Survey date: August 27, 2003.

Revisions: No. 1 - Topography taken June 9, 2014.
No. 2 - Misc.

WCP4-2

011-25847