


- LEGEND
- = FOUND IRON PIPE STAKE
  - = FOUND IRON REBAR STAKE
  - ⊙ = SET IRON REBAR STAKE
  - ⊙ = FOUND CONCRETE MONUMENT
  - (XXXX) = RECORDED AS



DATE: JANUARY 18, 2016  
TO SHOW SIZE & LOCATION OF  
AS BUILT FOUNDATION


PETER S. GORDON P.L.S. 2101

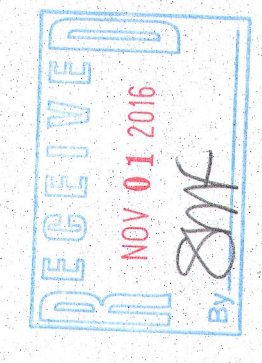


PROJECT NO. 9446  
DATE 01-18-2016  
SUBJECT NO.  
1 OF 1

FARRIS, HANSEN & ASSOCIATES, INC.  
ENGINEERING - ARCHITECTURE - SURVEYING  
7 RIDGWAY COURT P.O. BOX 437  
ELKHORN, WISCONSIN 53121  
OFFICE: (262) 723-2098 FAX: (262) 723-5886

WORK ORDERED BY:  
LOWELL MANAGEMENT  
PO BOX 926  
LAKE GENEVA, WI. 53147

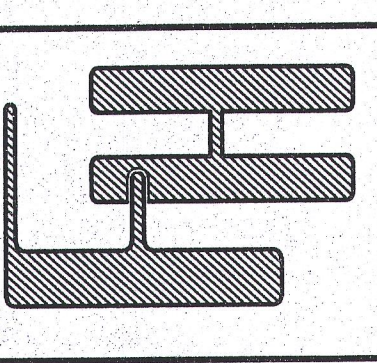

AS BUILT SURVEY  
LOT 1 OF CERTIFIED SURVEY MAP NO. 3134  
PART OF THE SE 1/4 OF THE SE 1/4 SECTION 1  
TOWN 1 NORTH, RANGE 16 EAST &  
PART OF THE SW 1/4 OF THE SW 1/4 SECTION 6  
TOWN 1 NORTH, RANGE 17 EAST  
VILLAGE OF WILLIAMS BAY  
WALWORTH COUNTY, WISCONSIN

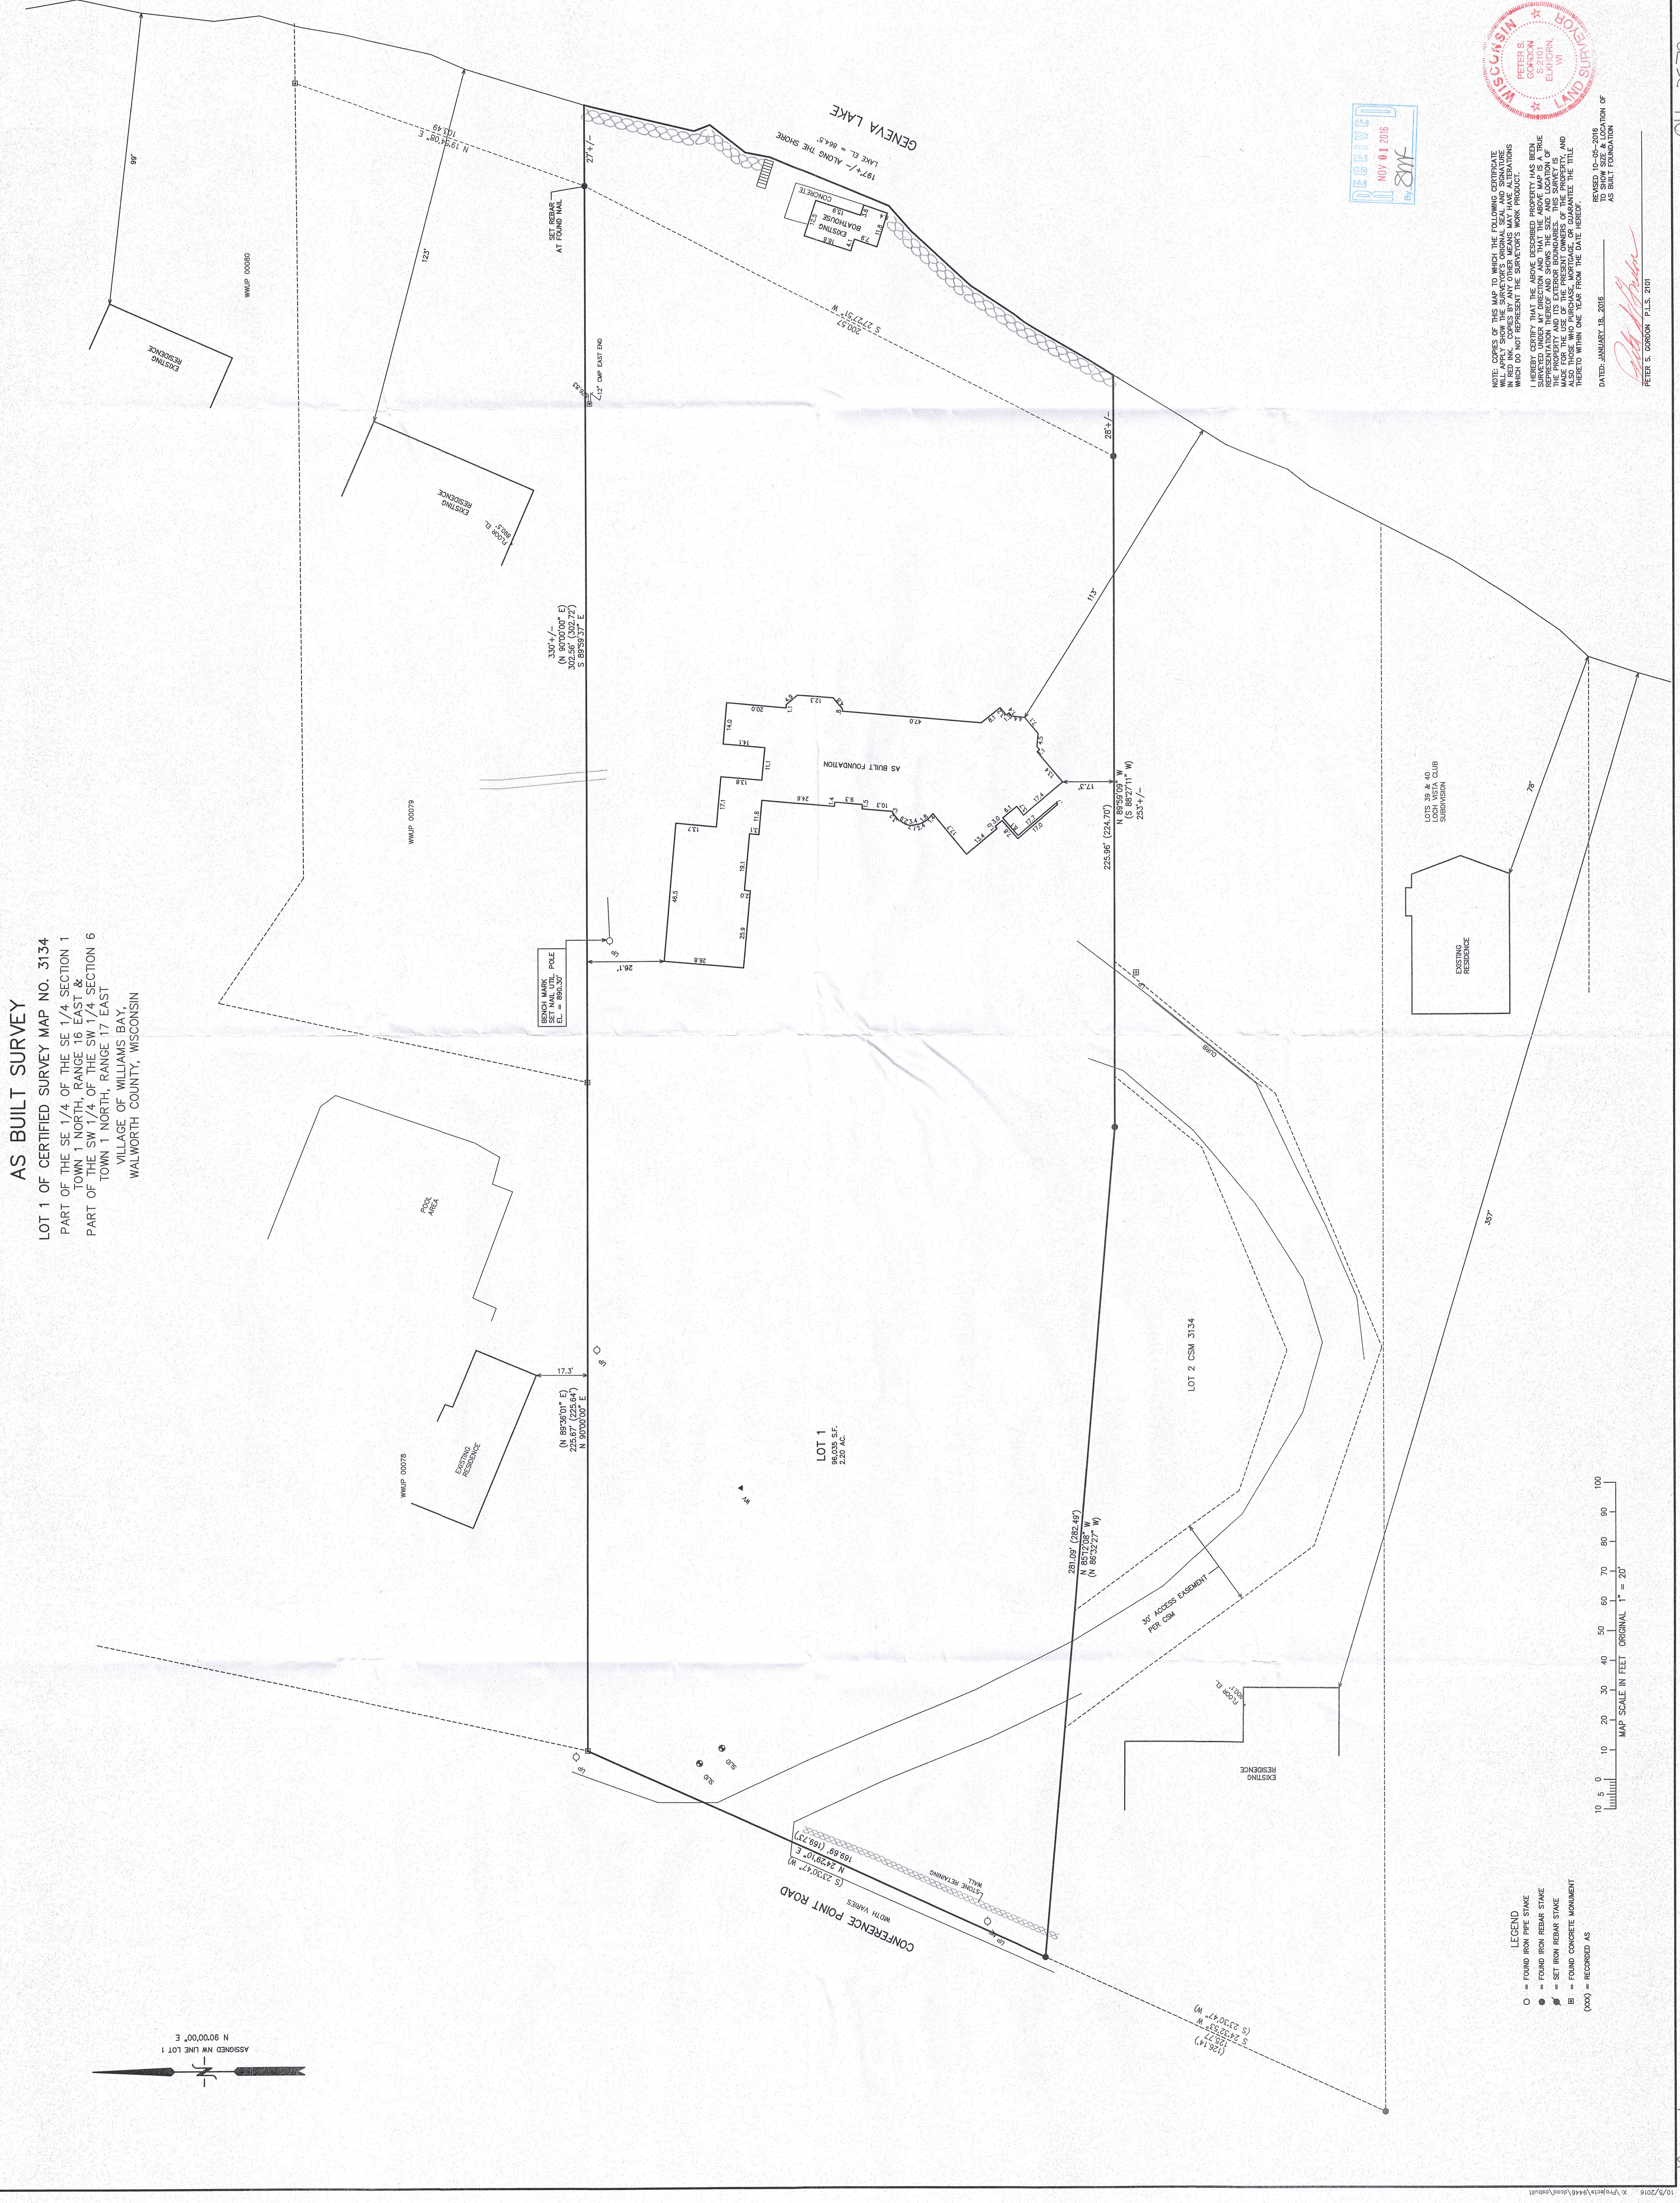

ASSIGNED NW LINE LOT 1  
N 90°00'00\"/>