


DUNHAM SURVEYING, S. C.
 SURVEYING & SUBDIVIDING
 DELAVAN, WISCONSIN 53115

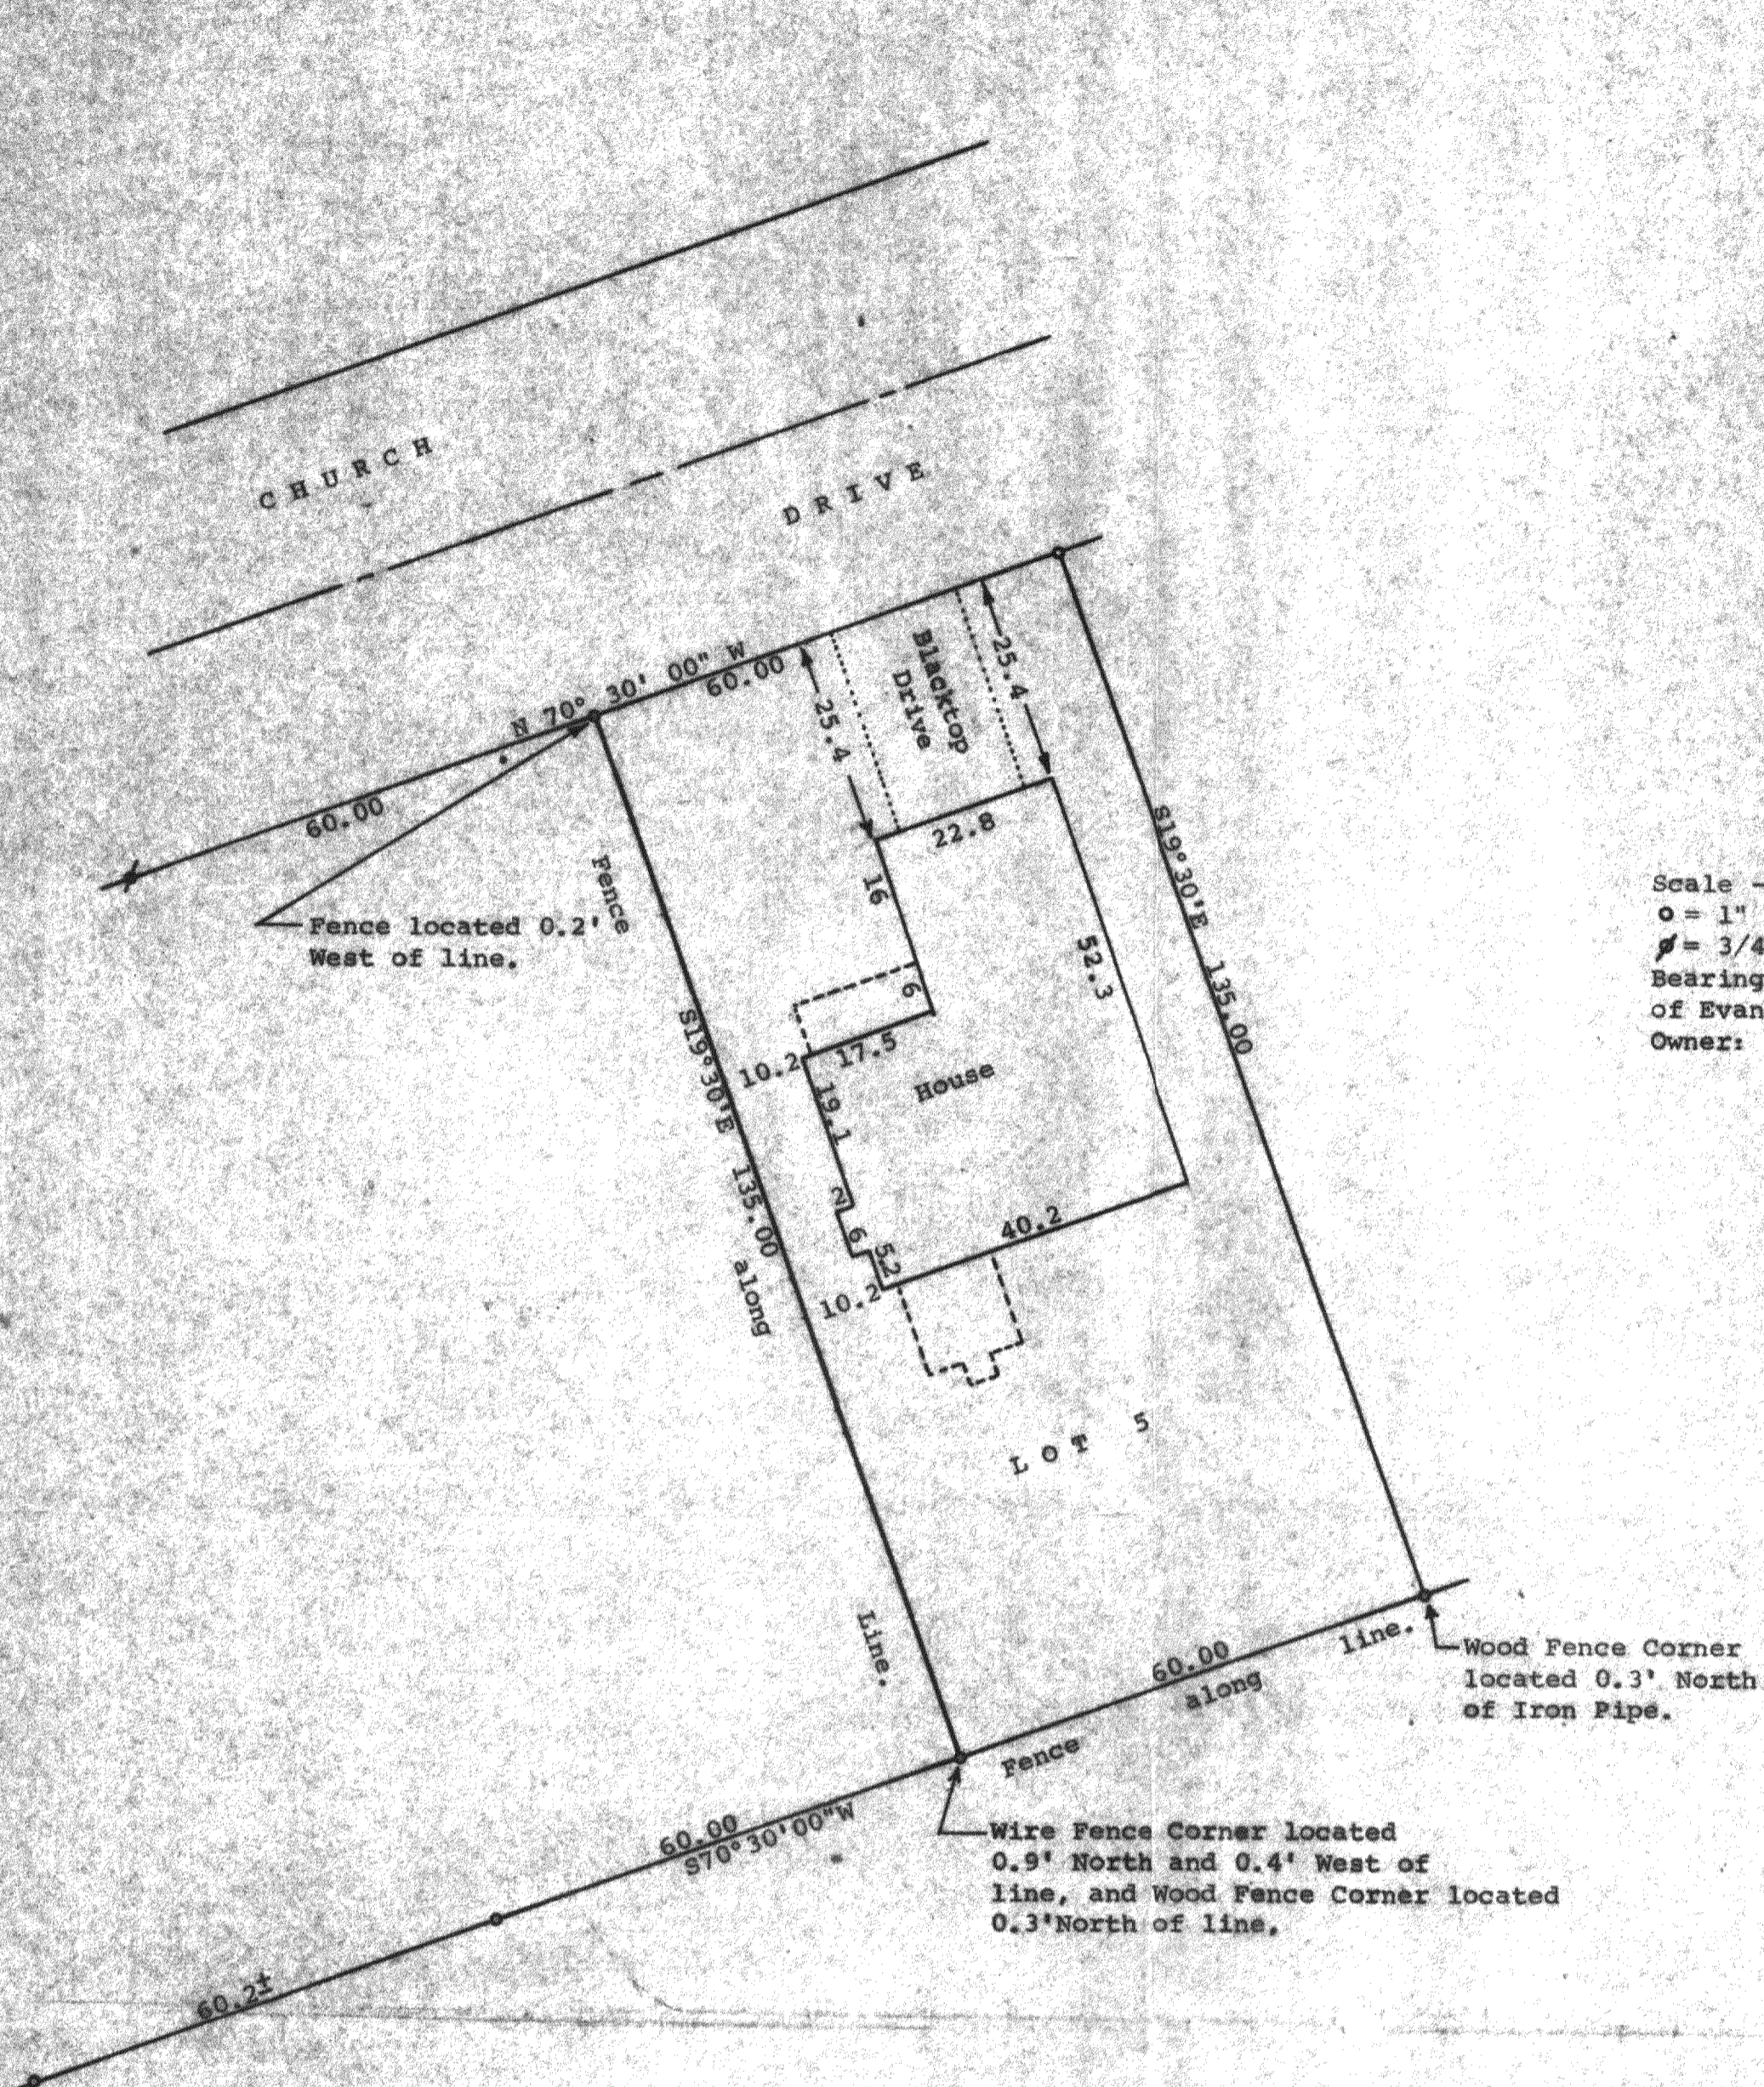

Scale - 1" = 20'
 O = 1" Iron Pipe Found
 Ø = 3/4" Iron Pipe Found
 Bearings shown are those on the recorded plat
 of Evangelical Free Church Subdivision
 Owner: Marie Redpath
 513 Free Church Drive
 Williams Bay, WI 53191

STATE OF WISCONSIN) SS
 COUNTY OF WALWORTH)

I, Richard C. Schulz, Surveyor, certify that I have surveyed
 the property described as follows,

Lot 5, Evangelical Free Church Subdivision, located in the
 Village of Williams Bay, Walworth County, Wisconsin,
 and that the map shown hereon is a true representation thereof and shows
 the size and location of the property, its exterior boundaries, the
 location of all visible structures and dimensions of all principal
 buildings thereon, boundary fences, apparent easements, roadways and
 visible encroachments, if any, and that I have surveyed the property
 hereon described according to the official records, to the best of
 my knowledge and belief.

June 27, 1984.

Richard C. Schulz
 Richard C. Schulz, Surveyor

