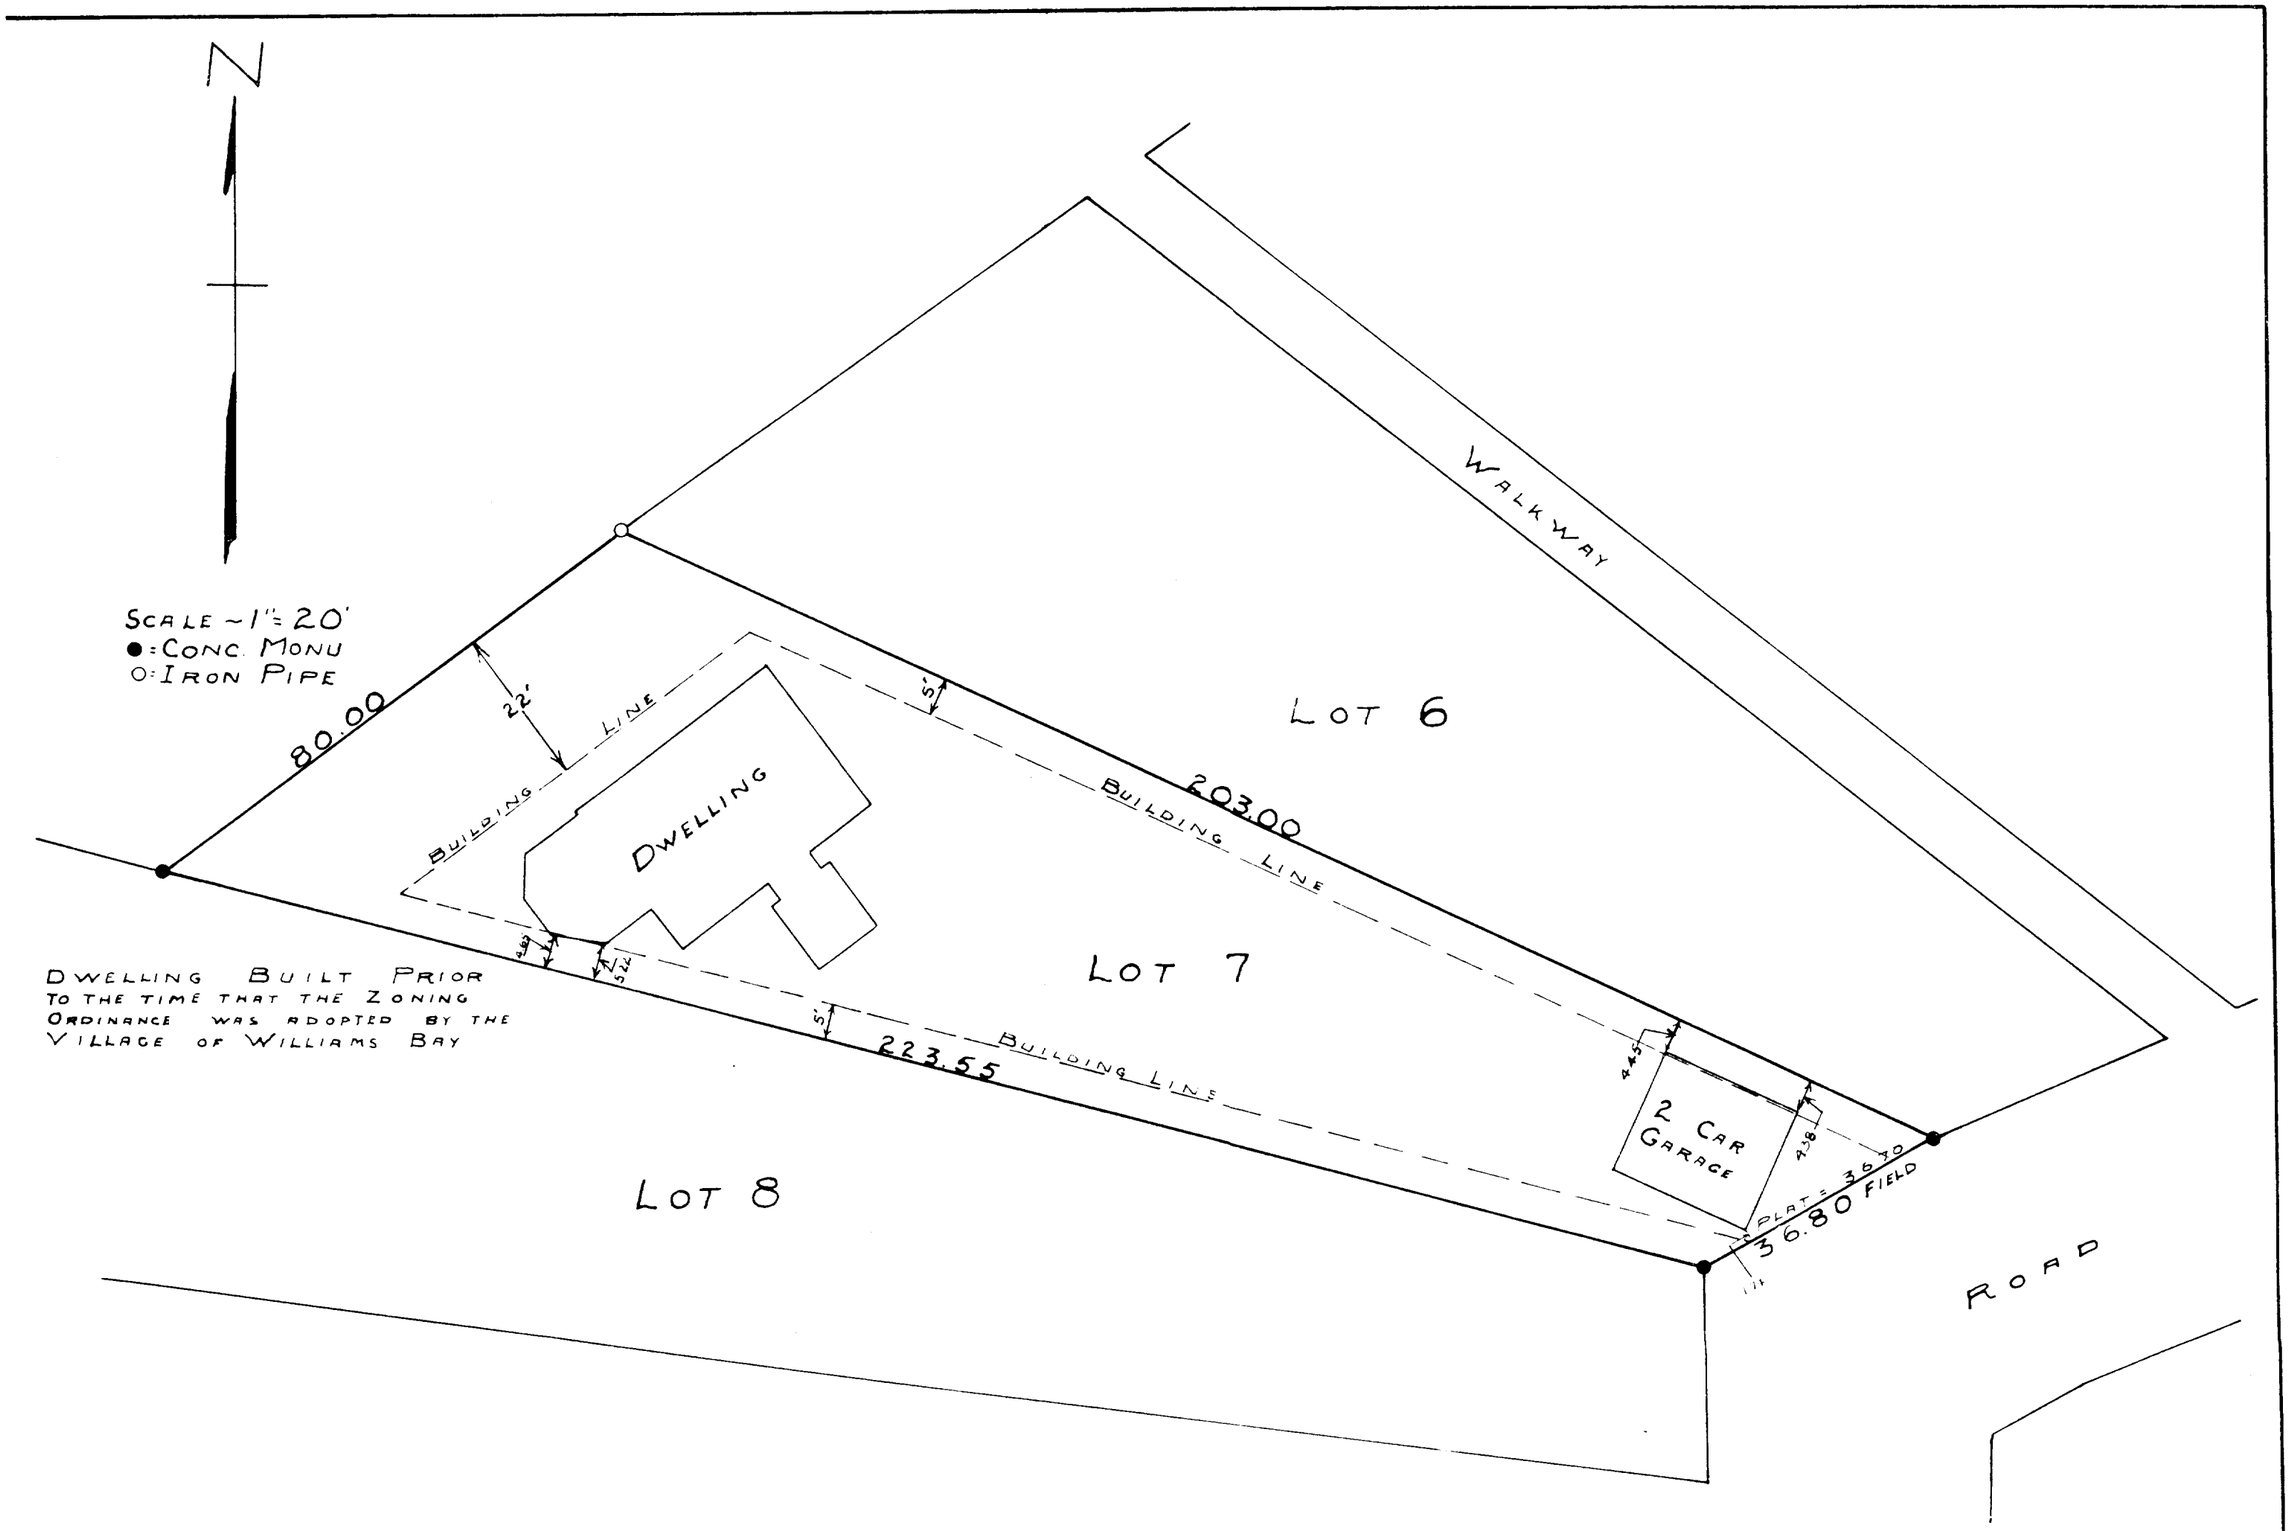

PLAT OF SURVEY OF LOT 7 IN THE FIRST ADDITION CEDAR POINT PARK LOCATED IN THE VILLAGE OF WILLIAMS BAY WALWORTH COUNTY WISCONSIN
FEBRUARY 1949

W. E. Johnson
SURVEYOR

11-45 J

WCP 1-6