Plat of Survey

SITUATED ON CIRCLE PARKWAY, IN THE VILLAGE OF WILLIAMS BAY, WISCONSIN.
LOTS 221 AND 222 OF THE THIRD ADDITION CEDAR POINT PARK, BEING A PART OF THE EAST 1/2 OF FRACTIONAL SECTIONS 6 AND 7, T 1 N, R 17 E, IN THE VILLAGE OF WILLIAMS BAY, WALWORTH COUNTY, WISCONSIN.

AUGUST 23, 1986

DR HUSHANG JAVID

SURVEY NO. 144193-M

NOTE: AN AGREEMENT HAS BEEN REACHED BETWEEN DR HUSHANG JAVID AND KENNETH E BERKE TO OMIT THE SETTING OF MONUMENTS ON PROPERTY CORNERS.

RECEIVED
NOV 12 1986

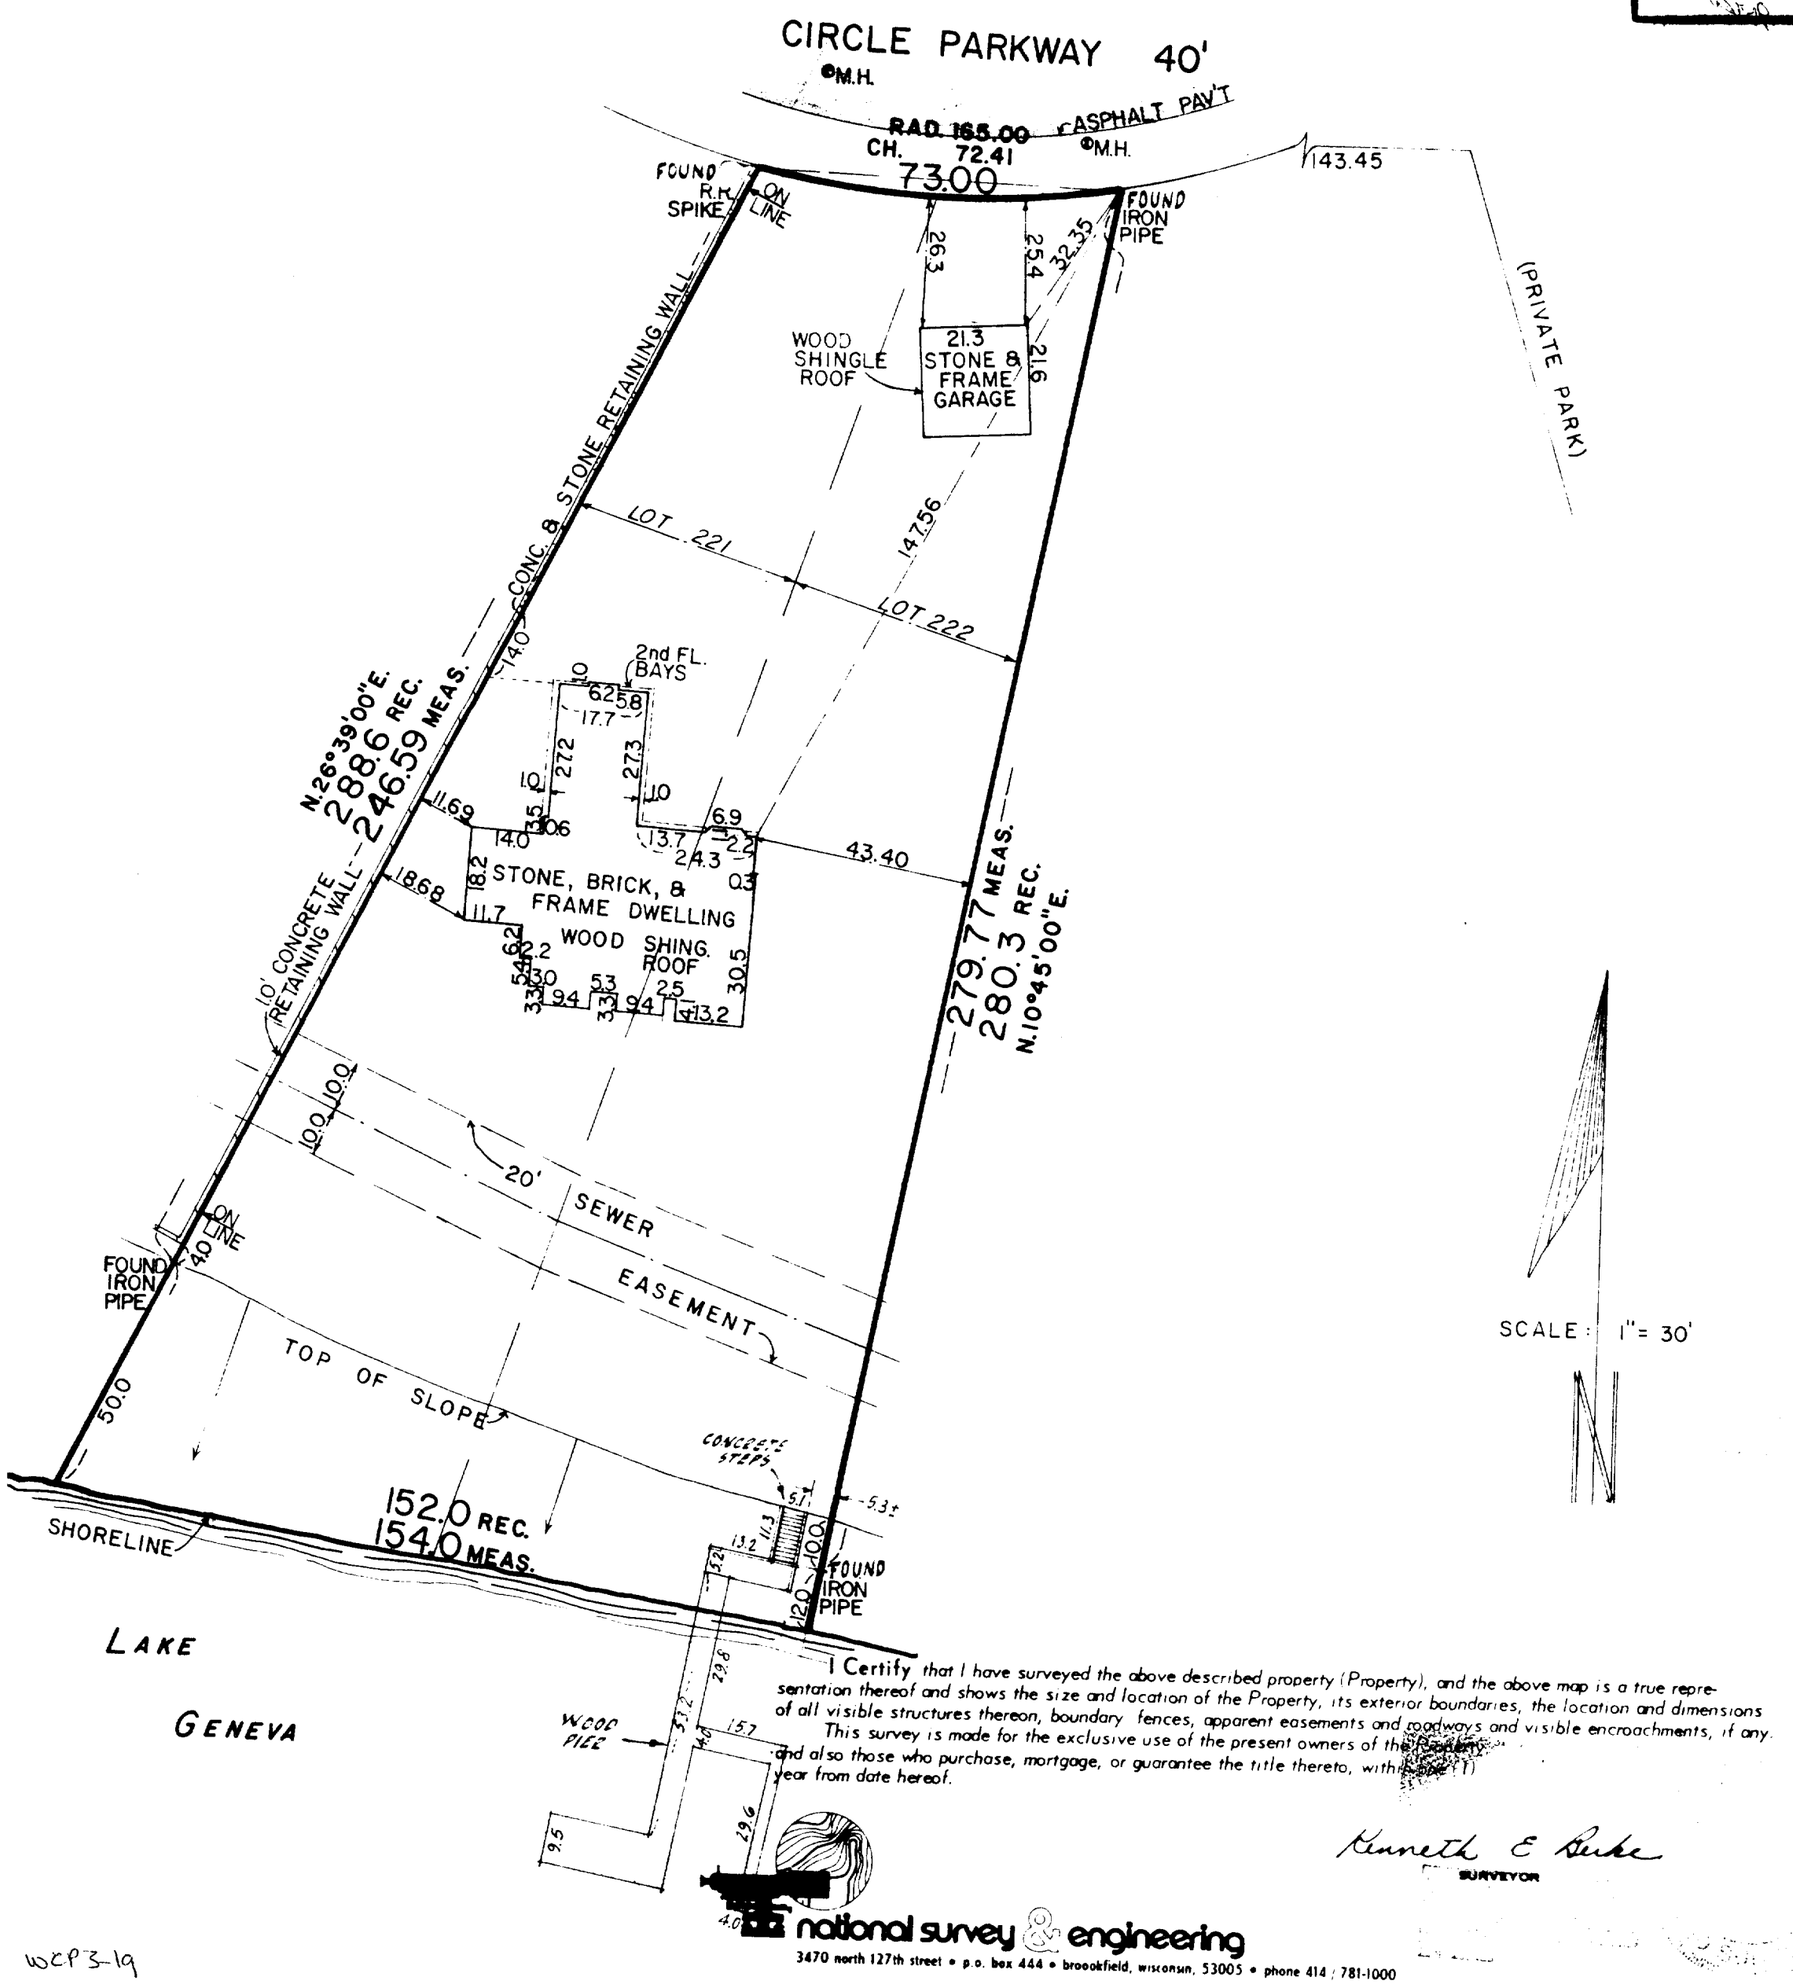

SCALE: 1"= 30'

I Certify that I have surveyed the above described property (Property), and the above map is a true representation thereof and shows the size and location of the Property, its exterior boundaries, the location and dimensions of all visible structures thereon, boundary fences, apparent easements and roadways and visible encroachments, if any.
This survey is made for the exclusive use of the present owners of the Property and also those who purchase, mortgage, or guarantee the title thereto, within one (1) year from date hereof.

Kenneth E Berke
SURVEYOR

national survey & engineering
3470 north 127th street • p.o. box 444 • brookfield, wisconsin, 53005 • phone 414 / 781-1000

WCP 3-19