WALWORTH COUNTY
SURVEYING & MAPPING
LAKE GENEVA, WISCONSIN

RECEIVED
FEB 4

PLAT OF SURVEY OF

A 40 FOOT WIDE SANITARY SEWER EASEMENT LOCATED IN THE NORTHEAST 1/4 OF THE NORTHWEST 1/4 OF SECTION 12, T 1 N, R 16 E, VILLAGE OF WILLIAMS BAY, WALWORTH COUNTY, WISCONSIN, THE CENTERLINE OF WHICH IS DECRIBED AS FOLLOWS: COMMENCING AT THE SOUTH 1/4 CORNER OF SECTION 1, THENCE S6°00'00"E, ALONG THE SOUTHERLY EXTENSION OF THE NORTH-SOUTH 1/4 LINE OF SAID SECTION 1, 102.45 FEET TO THE PLACE OF BEGINNING; THENCE S77°43'35"W 166.80 FEET; THENCE S78°42'20"W 300.79 FEET; THENCE S80°52'15"W 295.89 FEET; THENCE S79°39'05"W 294.70 FEET; THENCE S71°04'35"W 151.34 FEET; THENCE S59°03'55"W 359.20 FEET TO THE PLACE OF TERMINATION.

ORDERED BY: THE VILLAGE OF WILLIAMS BAY

I, ROBERT M. BAERENWALD, DO HEREBY CERTIFY THAT I HAVE SURVEYED THE PROPERTY HEREON DESCRIBED ACCORDING TO THE OFFICIAL RECORDS AND THAT THE PLAT HEREON IS A CORRECT REPRESENTATION OF THE PROPERTY LINES TO THE BEST OF MY KNOWLEDGE AND BELIEF.

Robert M. Baerenwald
ROBERT M. BAERENWALD
WISCONSIN REGISTERED LAND SURVEYOR, S-1508

Dec. 26, 1986
DATE JOB NO. 0757

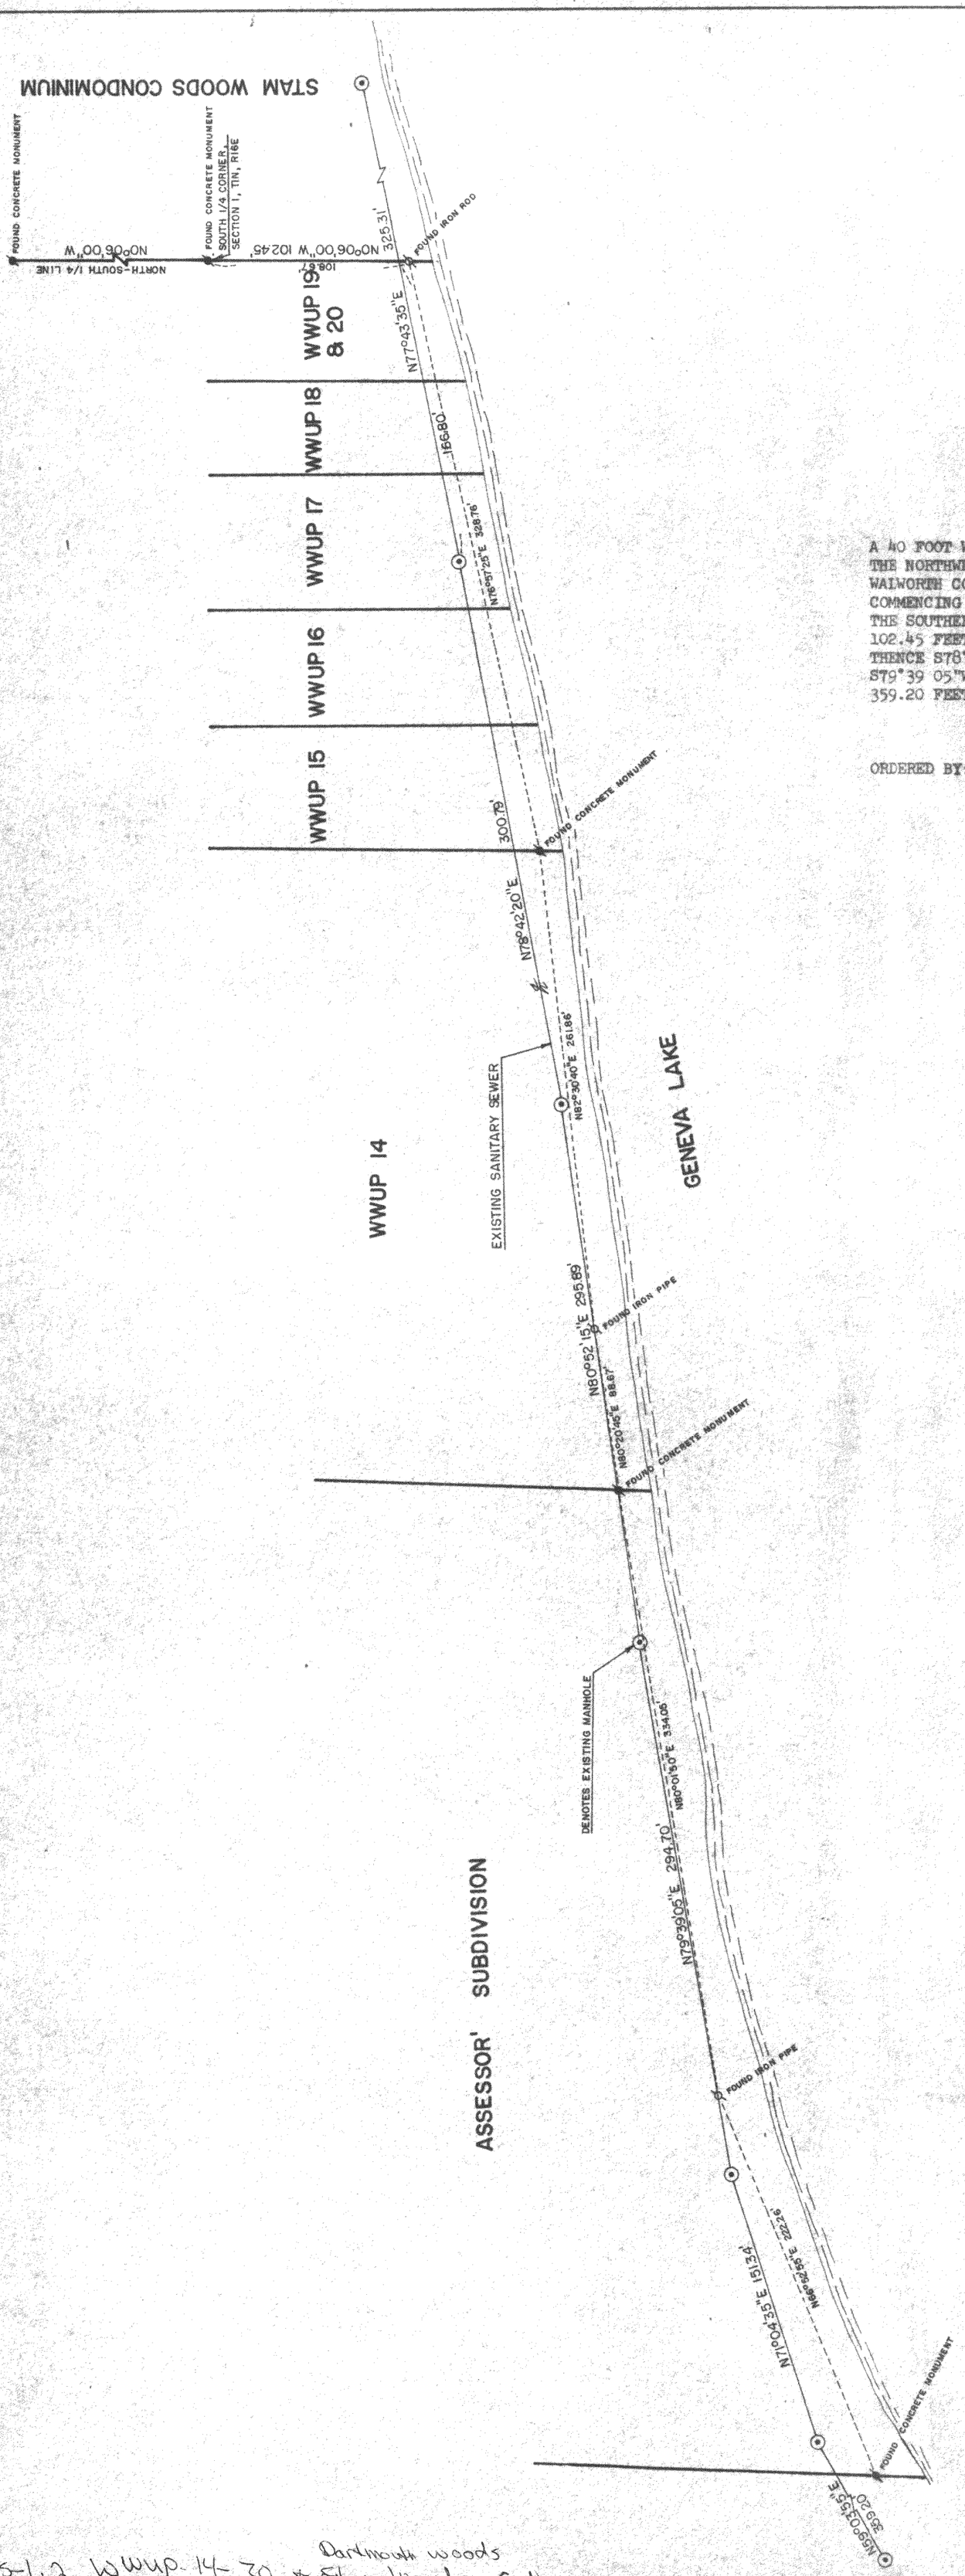

WAS-1, 2. WWUP 14-20 & ~~Stam Woods~~ Dartmouth Woods Condo