

FARRIS, HANSEN & ASSOCIATES, INC.

7 RIDGEWAY COURT, P.O. BOX 487, ELKHORN, WISCONSIN

TEL. 414-723-2098


LOCATION: LOT 34 WILLABAY WOODS
WILLIAMS BAY, WI

MAP LEGEND


- = IRON PIPE STAKE FOUND
- = IRON PIPE STAKE SET
- = IRON ROD STAKE FOUND
- = IRON ROD STAKE SET
- = CONCRETE MONUMENT FOUND

(XXXXX) = RECORD DIMENSION

WORK ORDERED BY: IRENE WERNER

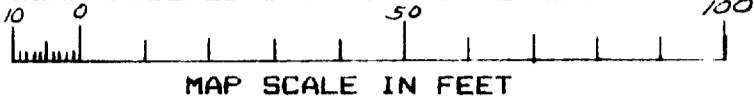

MAP SCALE IN FEET

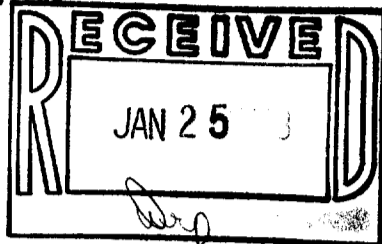

LOT 33

239.05' (238.67')

N 49°05'E
BEARING BASIS FOR THIS PLAT


LOT 34

193.22' (193)

S 40°31'W (54°07'W)

UTILITY EAS.

NORTH POTAWATOMI RD.
HYDRANT CHORD (RADIUS 166')
N 32°14'W 84.73'

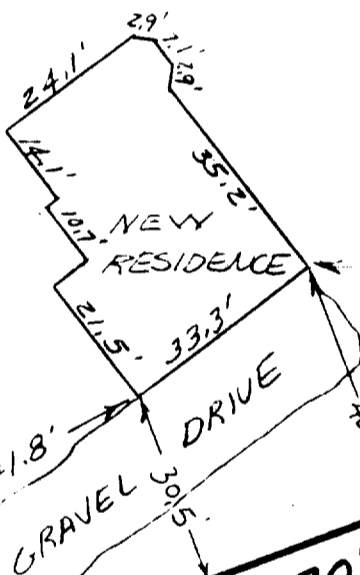

N 73°30'E 125.40' (125.44')

LOT 35

FILL AREA FROM LOT 34?

I hereby certify that the above described property has been surveyed under my direction and that the above map is a true representation thereof and shows the size and location of the property, its exterior boundaries, the location of all visible structures and dimensions of all principal buildings thereon, boundary fences, apparent easements, roadways and visible encroachments, if any. This survey is made for the use of the present owners of the property, and also those who purchase, mortgage, or guarantee the title thereto within one year from the date hereof.

DATED : NOV 24, 1987

Robert A. Farris

PROJ. NO. 2555.02