
RECEIVED
MAY 9 1988

WALWORTH COUNTY
SURVEYING & MAPPING
LAKE GENEVA, WISCONSIN

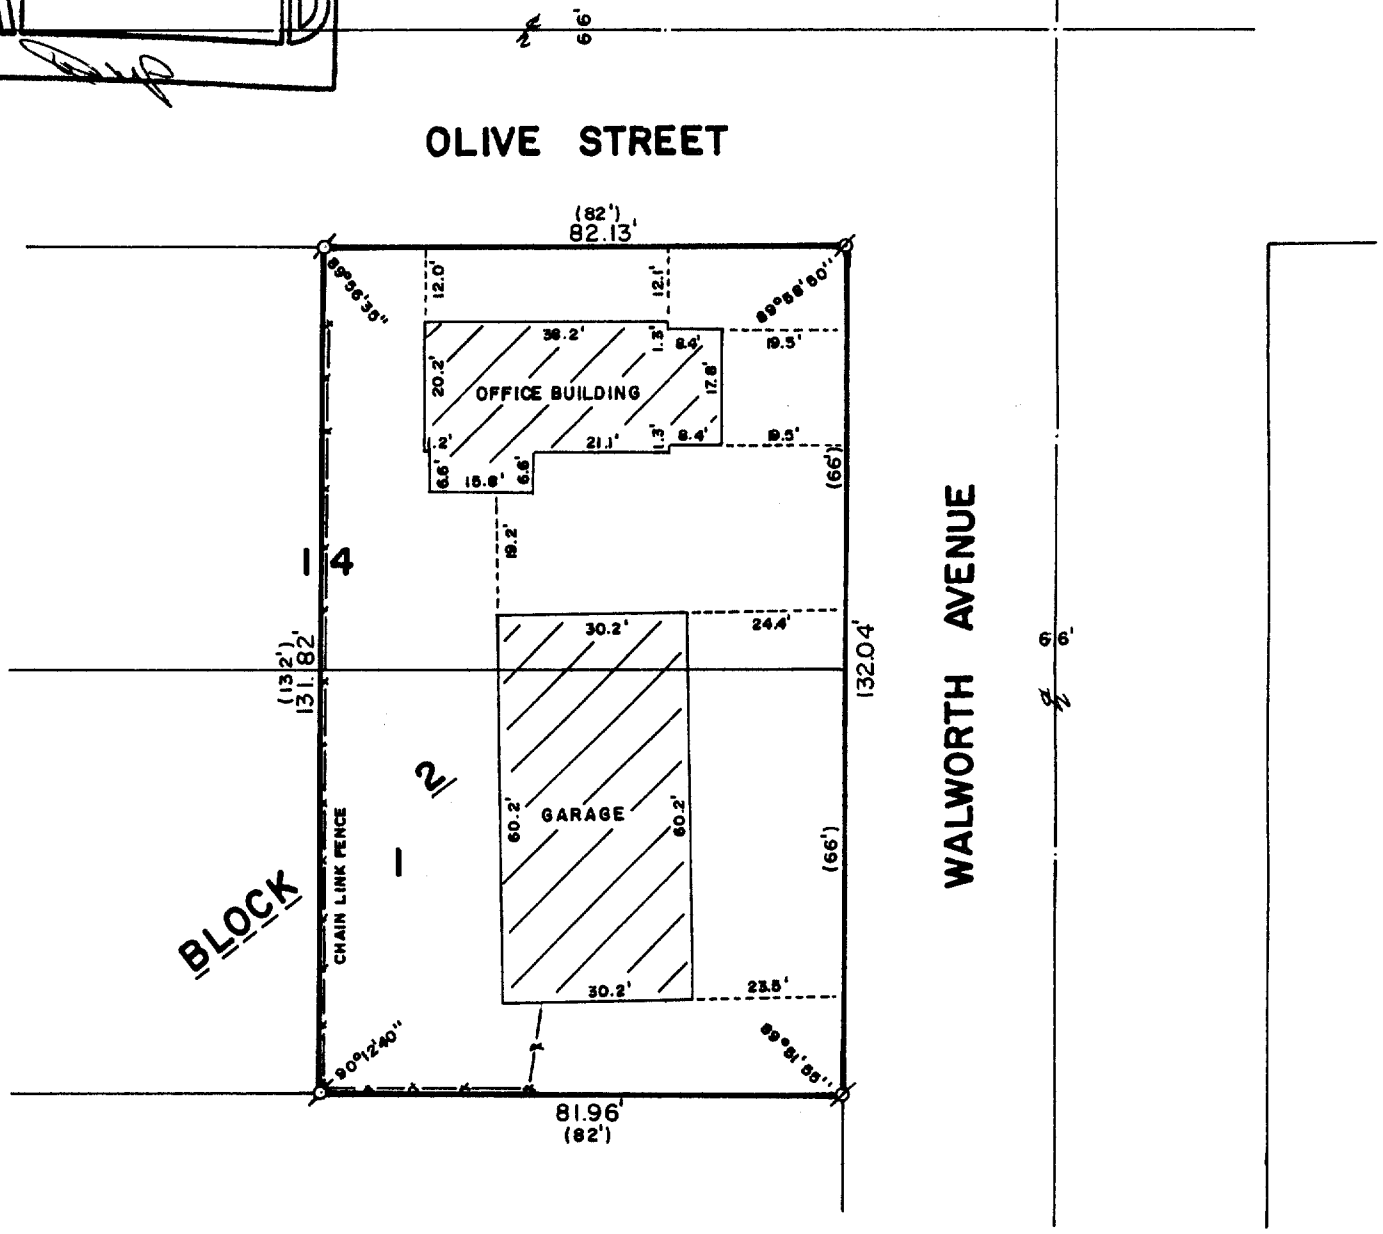

PLAT OF SURVEY OF

THE EAST 82 FEET OF LOT 14, BLOCK 2 OF WILLIAMS 1ST ADDITION AND THE EAST 82 FEET OF LOT 1, BLOCK 2 OF THE ORIGINAL PLAT OF THE VILLAGE OF WILLIAMS BAY, WALWORTH COUNTY, WISCONSIN.

ORDERED BY: SCOTT LOWELL
150 WALWORTH AVENUE
WILLIAMS BAY, WISCONSIN

SCALE: 1"=30'

ø -IRON PIPE FOUND
ø -IRON ROD FOUND
( )-RECORDED AS

I, ROBERT M. BAERENWALD, DO HEREBY CERTIFY THAT I HAVE SURVEYED THE PROPERTY HEREON DESCRIBED ACCORDING TO THE OFFICIAL RECORDS AND THAT THE PLAT HEREON IS A CORRECT REPRESENTATION OF THE PROPERTY LINES TO THE BEST OF MY KNOWLEDGE AND BELIEF.

Robert M. Baerenwald
ROBERT M. BAERENWALD
WISCONSIN REGISTERED LAND SURVEYOR, S-1508

Feb. 16, 1988
DATE JOB NO. 1416

NOTE: THIS IS NOT A CERTIFIED COPY UNLESS SEALED.

WOP-36,15

11-630