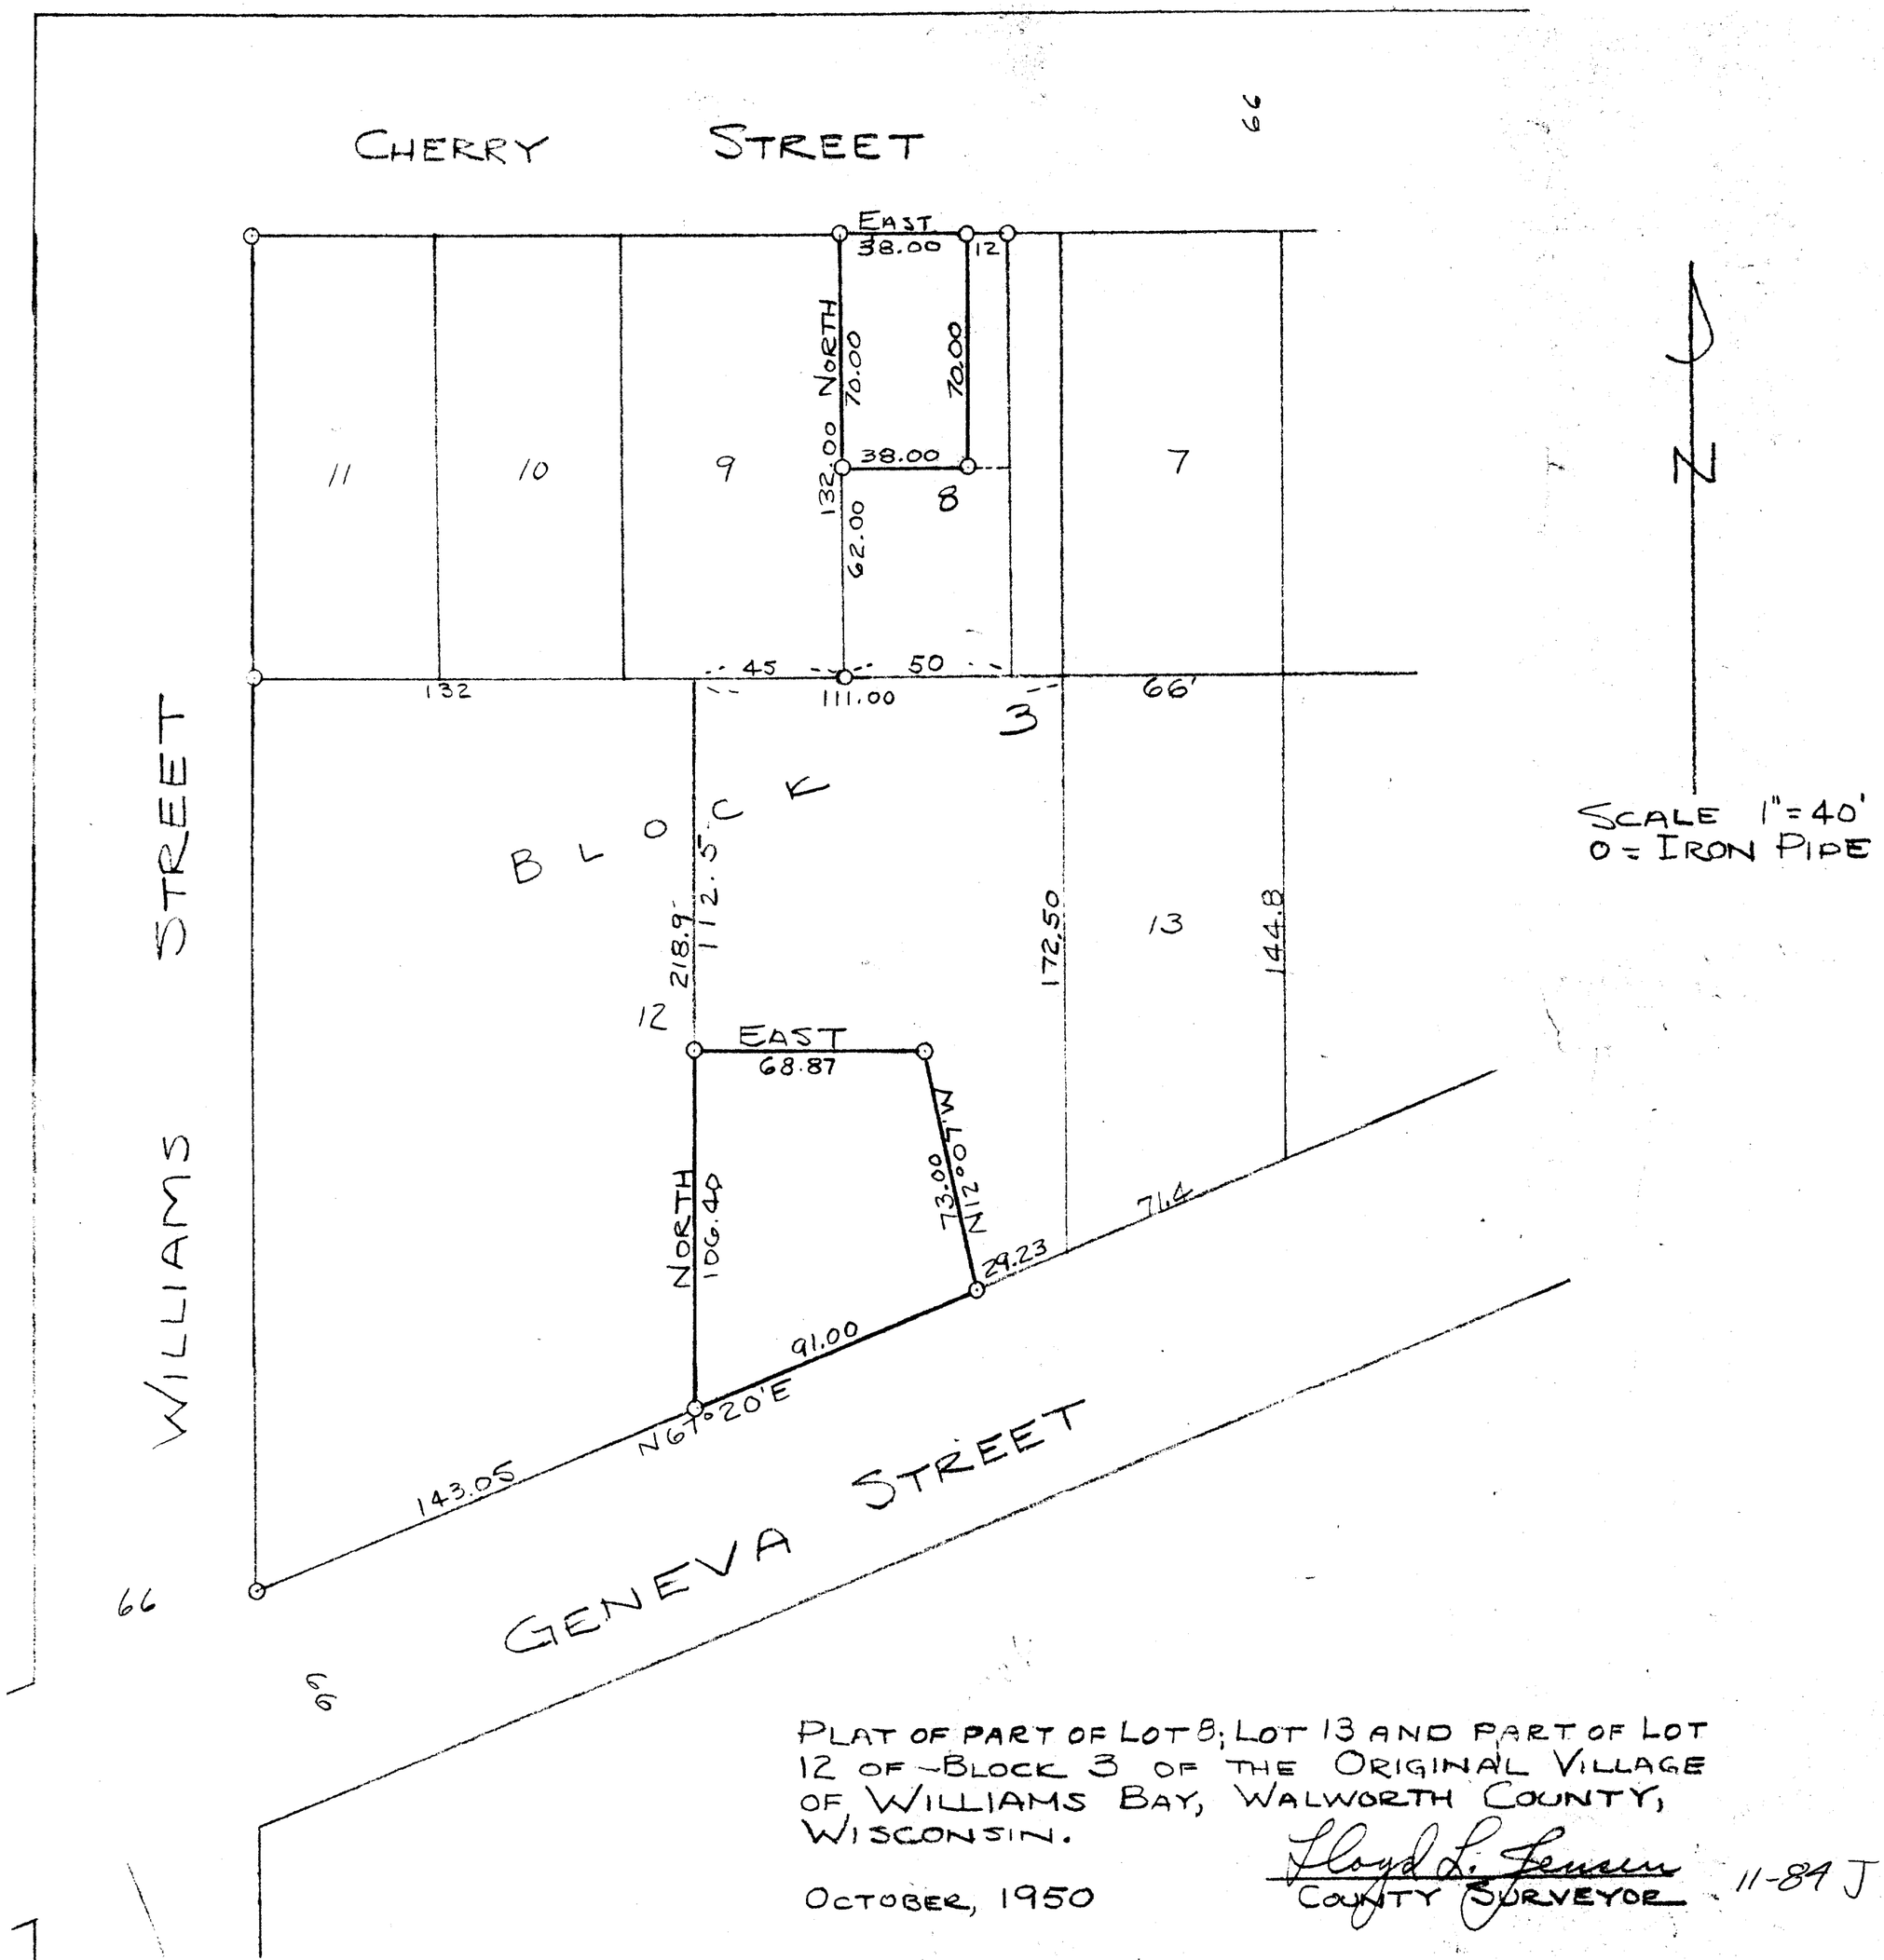

PLAT OF PART OF LOT 8; LOT 13 AND PART OF LOT 12 OF BLOCK 3 OF THE ORIGINAL VILLAGE OF WILLIAMS BAY, WALWORTH COUNTY, WISCONSIN.

OCTOBER, 1950

Lloyd L. Jensen
COUNTY SURVEYOR

11-84 J


