PLAT OF SURVEY

LOT 1 OF CERTIFIED SURVEY MAP NO. 1102
LOCATED IN THE NE & NW 1/4'S OF THE NE 1/4
SEC. 34, T. 1 N., R. 15 E.,
WALWORTH COUNTY, WISCONSIN

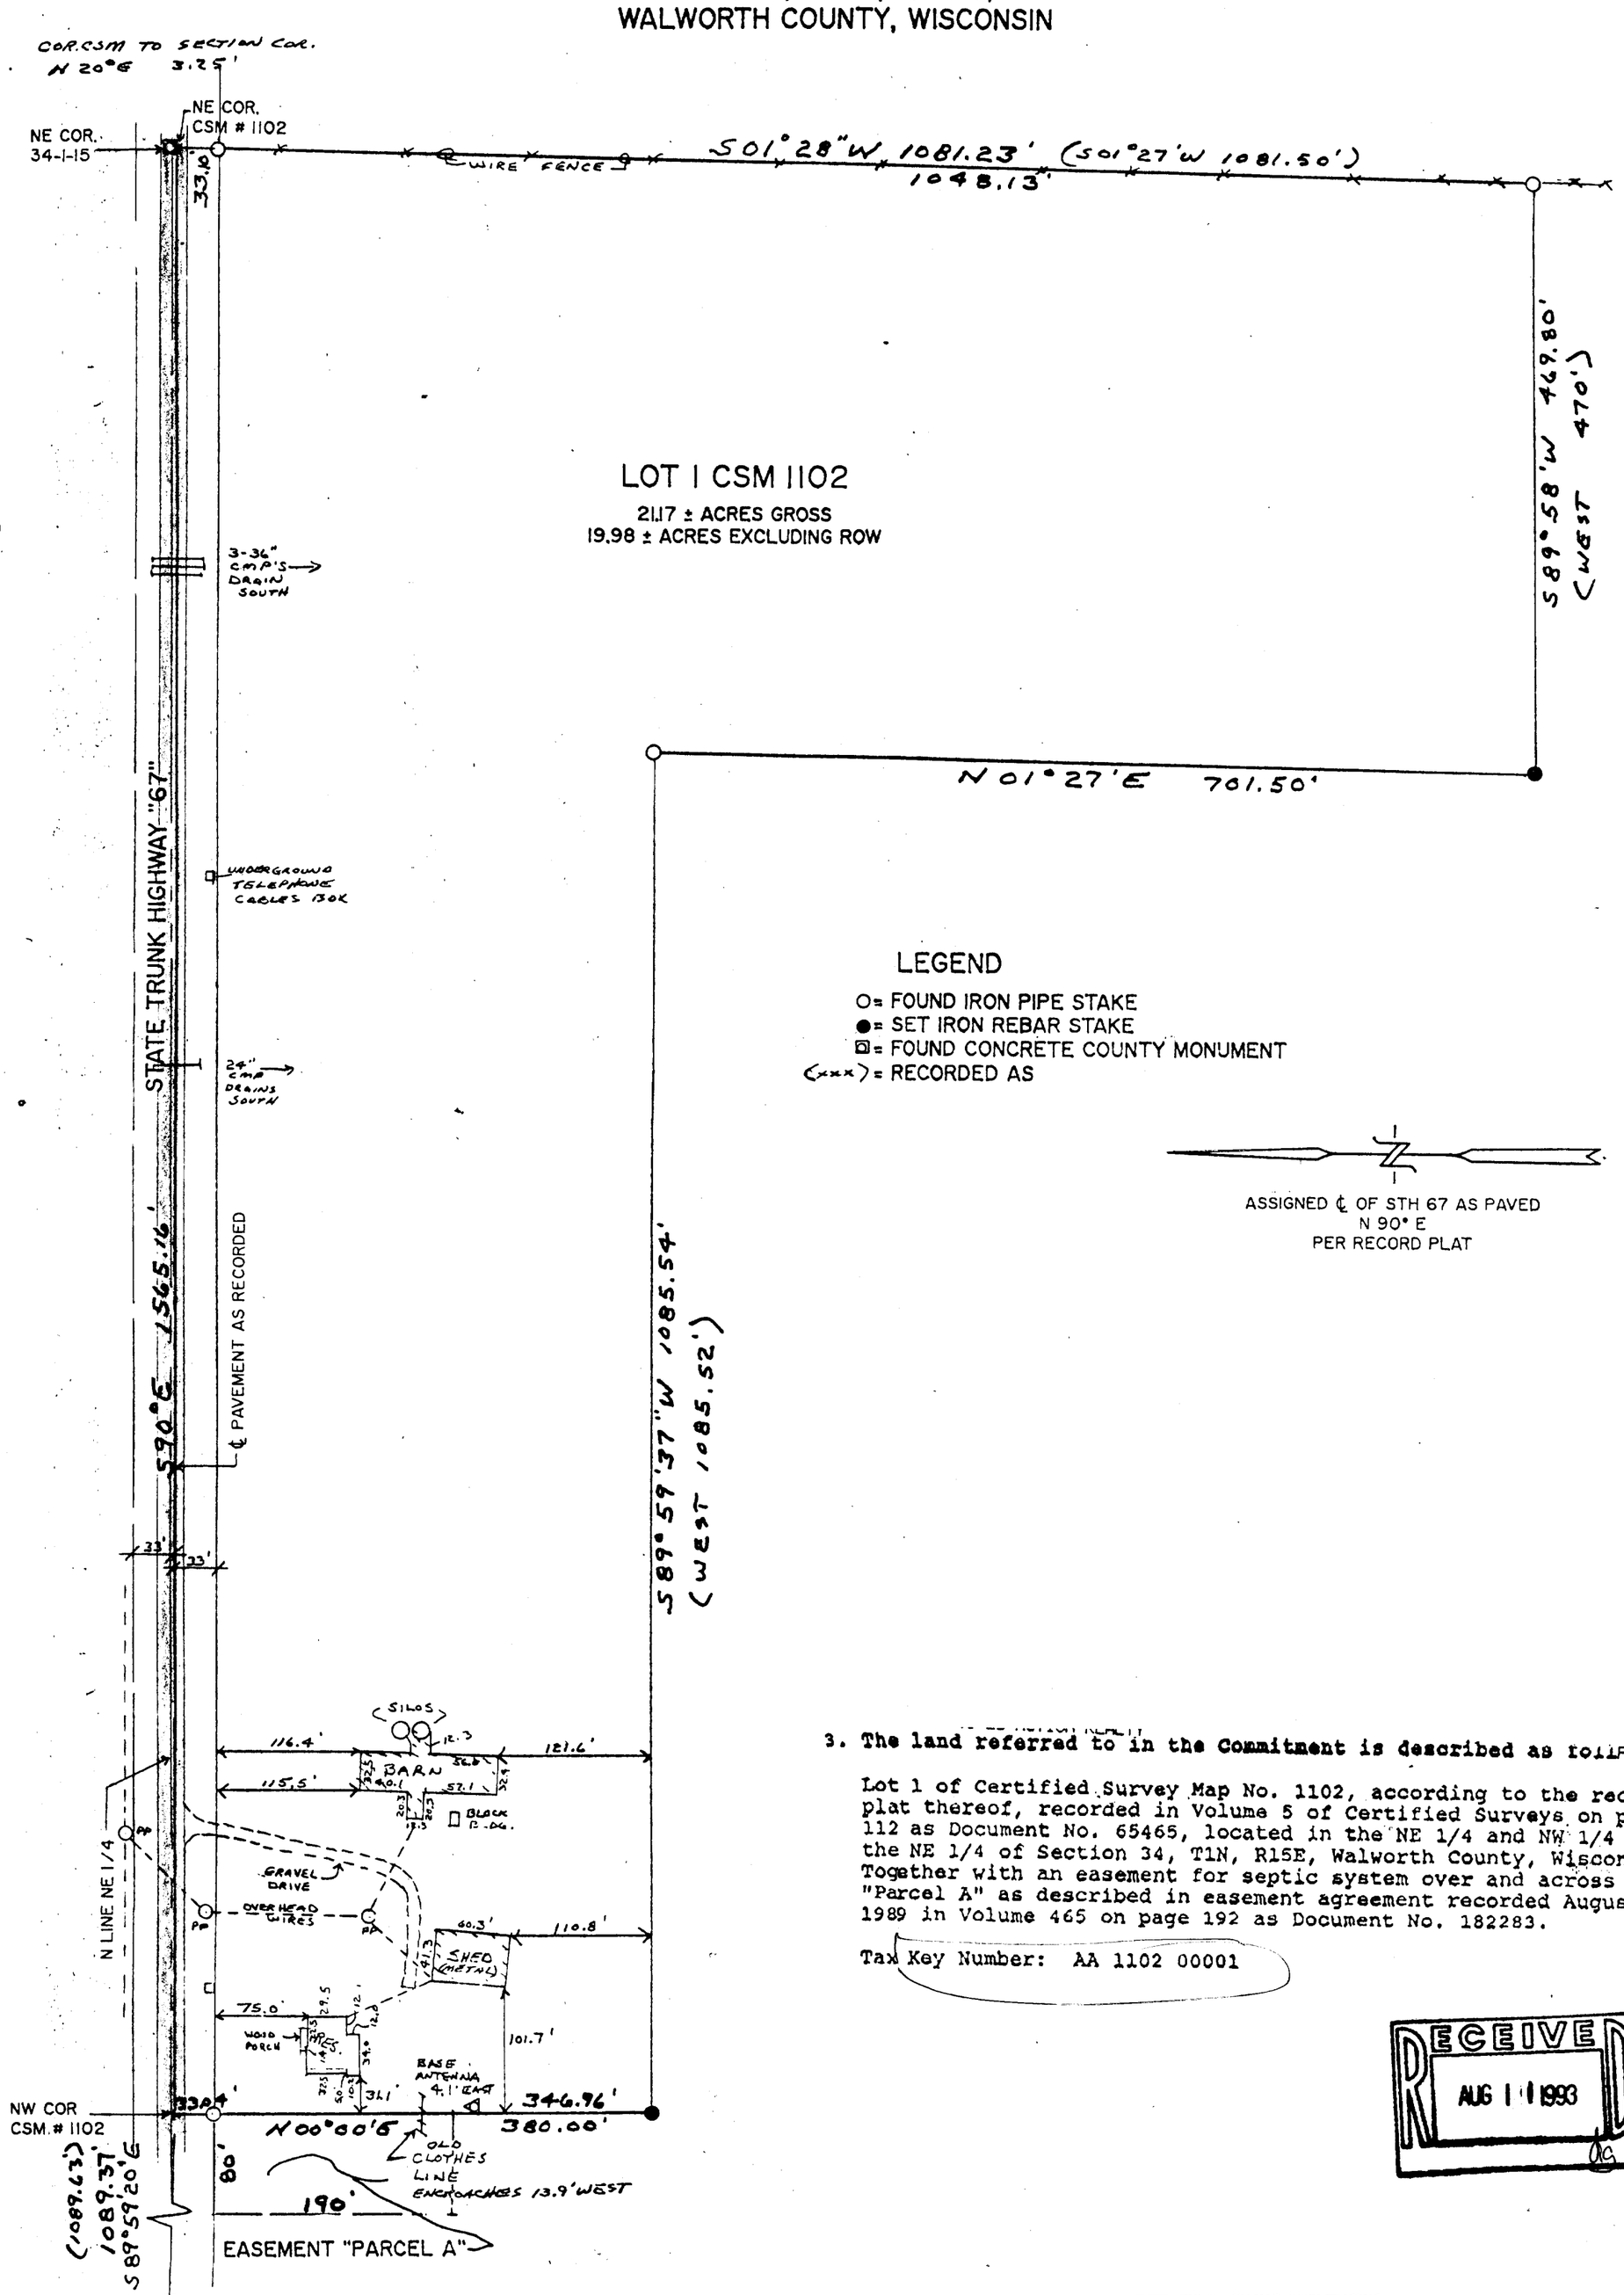

3. The land referred to in the Commitment is described as follows:

Lot 1 of Certified Survey Map No. 1102, according to the recorded plat thereof, recorded in Volume 5 of Certified Surveys on page 112 as Document No. 65465, located in the NE 1/4 and NW 1/4 of the NE 1/4 of Section 34, T1N, R15E, Walworth County, Wisconsin. Together with an easement for septic system over and across "Parcel A" as described in easement agreement recorded August 21, 1989 in Volume 465 on page 192 as Document No. 182283.

Tax Key Number: AA 1102 00001

RECEIVED AUG 11 1993

NOTE: COPIES OF THIS MAP TO WHICH THE FOLLOWING CERTIFICATE WILL APPLY ARE BLUE LINE PRINTS SHOWING SURVEYOR'S ORIGINAL SEAL AND SIGNATURE IN BLACK INK. COPIES BY ANY OTHER MEANS MAY HAVE ALTERATIONS WHICH DO NOT REPRESENT THE SURVEYOR'S WORK PRODUCT.

I HEREBY CERTIFY THAT THE ABOVE DESCRIBED PROPERTY HAS BEEN SURVEYED UNDER MY DIRECTION AND THAT THE ABOVE MAP IS A TRUE REPRESENTATION THEREOF AND SHOWS THE SIZE AND LOCATION OF THE PROPERTY, ITS EXTERIOR BOUNDARIES, THE LOCATION OF ALL VISIBLE STRUCTURES AND DIMENSIONS OF ALL PRINCIPAL BUILDINGS THEREON, BOUNDARY FENCES, APPARENT EASEMENTS, ROADWAYS AND VISIBLE ENCROACHMENTS, IF ANY. THIS SURVEY IS MADE FOR THE USE OF THE PRESENT OWNERS OF THE PROPERTY, AND ALSO THOSE WHO PURCHASE, MORTGAGE, OR GUARANTEE THE TITLE THERETO WITHIN ONE YEAR FROM THE DATE HEREOF.

DATED: 06/25/93 Peter S. Gordon

WISCONSIN PETER S. GORDON S-2101 ELKHORN, WI LAND SURVEYOR

PLAT OF SURVEY
LOT 1 OF CSM # 1102
LOCATED IN THE NE & NW 1/4'S OF THE NE 1/4
SEC. 34, T. 1 N., R. 15 E.,
WALWORTH COUNTY, WISCONSIN

WORK ORDERED BY: ACTION REALTY
FOR KAREN ARLEN
W. 8203 RT 67
SHARON, WI.

FARRIS, HANSEN & ASSOCIATES, INC.
Engineering, Architecture, Surveying
7 Ridgway Court P.O. Box 437
ELKHORN, WISCONSIN 53121
Office: (414) 723-2098
Fax: (414) 723-5886

REVISIONS

PROJECT NO 1758.93
DATE 06/25/93.
SHEET NO. 1 OF 1

115-174