


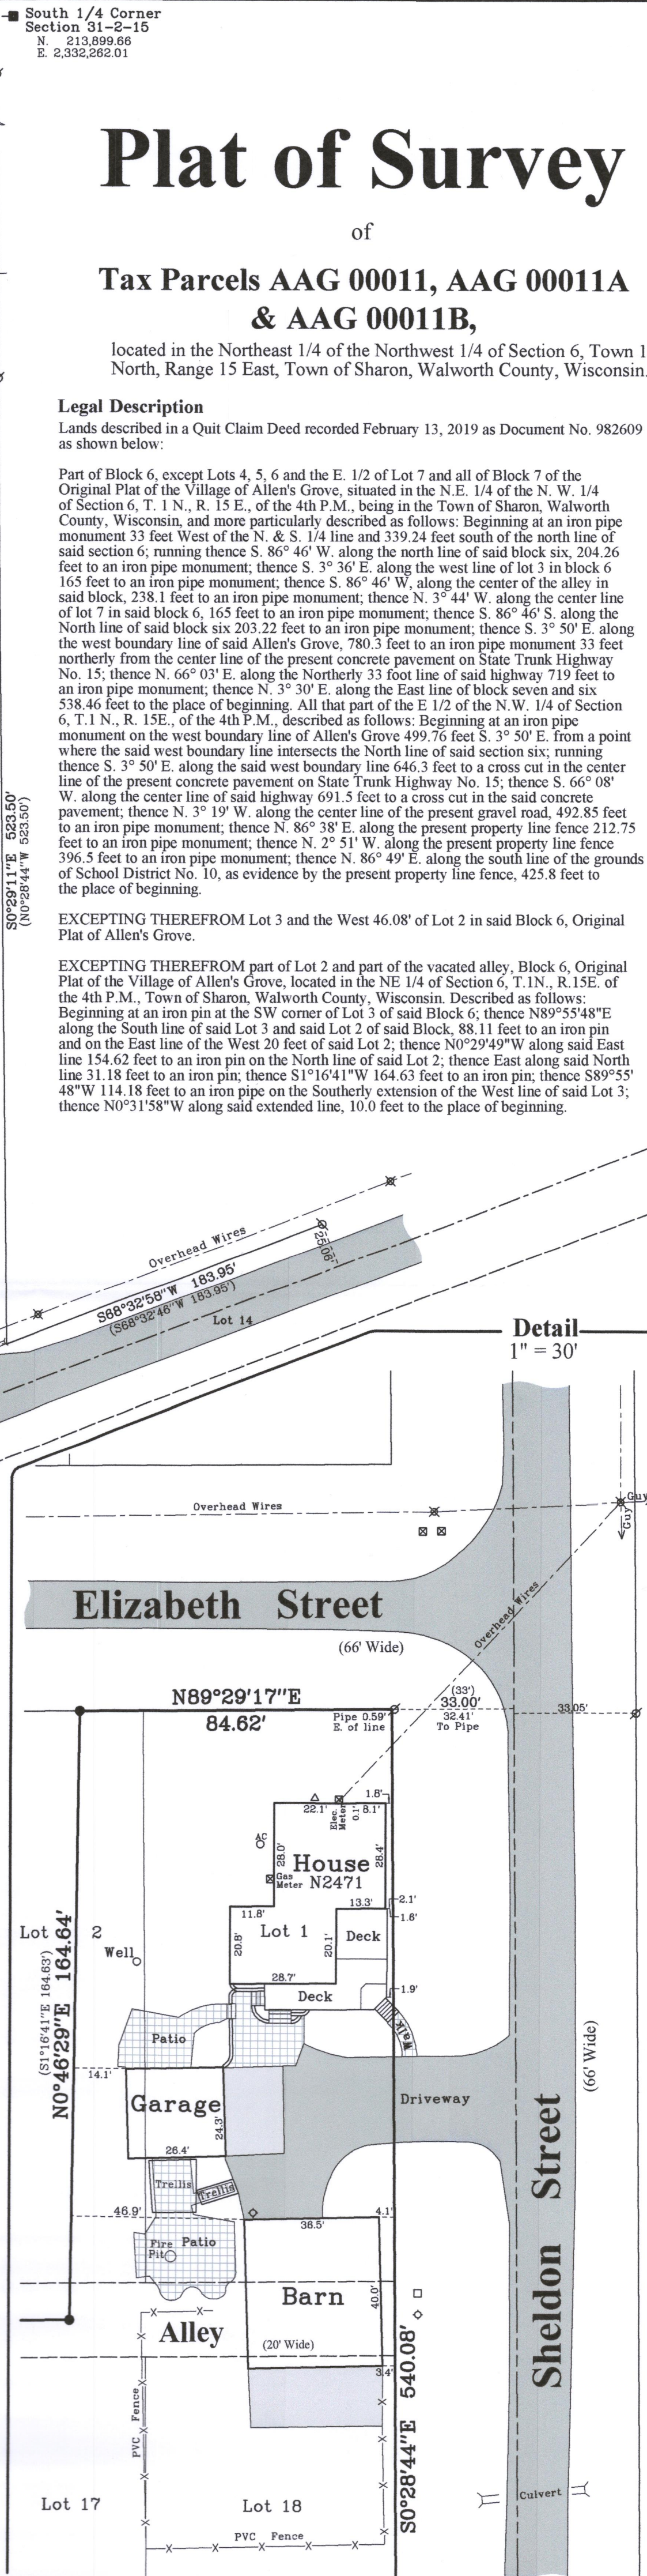

2020.099