

ENGINEERING – ARCHITECTURE – SURVEYING  
7 RIDGWAY COURT – P.O. BOX 437 – ELKHORN, WISCONSIN 53121  
PHONE: (262) 723-2098 FAX: (262) 723-5886


PART OF THE SE 1/4 AND SW 1/4 OF THE NE 1/4 SEC. 11  
TOWN 1 NORTH, RANGE 15 EAST WALWORTH COUNTY, WI.

The Southeast 1/4 of the North East 1/4 and the North 1/2 of the Southwest 1/4 of the Northeast 1/4 of Section 11, Town 1 North, Range 15 East, in the Town of Sharon, Walworth County, Wisconsin, excepting therefrom a strip of land 2 rods (3 feet) wide off the West side of the last described piece and also excepting therefrom the right of way conveyed to Railroad in Volume 104 of Deeds, Page 422, as Document No. 145635. Also excepting Lot 1 of Certified Survey Map No. 1497 recorded in Volume 7 of Certified Survey Map, on Page 83, as Document No. 129480 and further excepting therefrom Lot 1 of Certified Survey Map No. 3468 recorded on August 26, 2002, in Volume 20 of Certified Survey Maps, Page 113, as Document No. 520829.

Lot 1 of Certified Survey Map No. 3468 recorded on August 26, 2002, in Volume 20 of Certified Survey Maps, Page 113, as Document No. 520829, being part of the Southeast 1/4 and Southwest 1/4 of the Northeast 1/4 of Section 11, Town 1 North, Range 15 East, in the Town of Sharon, Walworth County, Wisconsin.

For Informational Purposes Only:  
Address: County Road K, Sharon, WI  
Tax Key No.: AS110002A (Parcel 1)  
AA346800001 (Parcel 2)

AREA SHOWN AS SPECIAL FLOOD HAZARD  
AREA SUBJECT TO INUNDATION BY THE  
1% ANNUAL CHANCE FLOOD  
ZONE A  
NO BASE FLOOD ELEVATIONS DETERMINED  
PER FIRM MAP PANEL 55127C0285D  
DATED OCT. 2, 2009

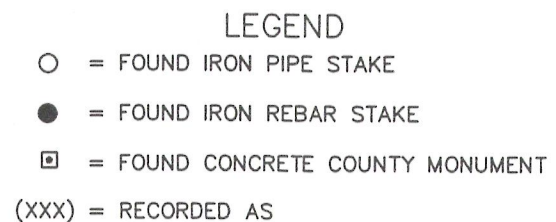

I HEREBY CERTIFY THAT THE ABOVE DESCRIBED PROPERTY HAS BEEN SURVEYED UNDER MY DIRECTION AND THAT THE ABOVE MAP IS A TRUE REPRESENTATION THEREOF AND SHOWS THE SIZE AND LOCATION OF THE PROPERTY, ITS EXTERIOR BOUNDARIES, THE LOCATION OF ALL VISIBLE STRUCTURES, AND DIMENSIONS OF ALL PRINCIPLE BUILDINGS THEREON, BOUNDARY FENCES, APPARENT EASEMENTS, ROADWAYS, AND VISIBLE ENCROACHMENTS, IF ANY. THIS SURVEY IS MADE FOR THE USE OF THE PRESENT OWNERS OF THE PROPERTY, AND ALSO THOSE WHO PURCHASE, MORTGAGE, OR GUARANTEE THE TITLE THERETO WITHIN ONE YEAR FROM THE DATE HEREOF.

PETER S. GORDON

PROJECT: 6035.12  
DATE: 10-17-2012  
SHEET 1 OF 1

115-399

0/22/2012 X:\Projects\6035\dcad\2012srvy